

DETAILED EMERGENCY RESPONSE PLAN TO DEAL WITH SPILLAGE OF CHEMICALS CAUSED BY TRAFFIC INCIDENTS ON HONG KONG-ZHUHAI-MACAO BRIDGE - HONG KONG LINK ROAD

1 Background and Objectives

- 1.1 Under the Environmental Impact Assessment Ordinance, the Environmental Impact Assessment (EIA) Report (Register No.: AEIAR-144/2009) for the “Hong Kong-Zhuhai-Macao Bridge Hong Kong Link Road” (the project) has been approved by the Environmental Protection Department (EPD), and an Environmental Permit (Permit No.: EP-352/2009/D) has been issued for the project. Pursuant to the recommendation in Section 9.94 of the EIA Report and the Condition 3.16 of the Environmental Permit (EP), the Permit Holder shall prepare an Emergency Response Plan to prevent and handle oil and chemical spillages caused by traffic incidents on the carriageway from entering into the waterbody.
- 1.2 This document presents the Emergency Response Plan (ERP) to deal with chemical spillage due to vehicle accident that may occur on the Hong Kong-Zhuhai-Macao Bridge (HZMB) Hong Kong Link Road (HKLR) during the operational stage. The objectives of this ERP are to ensure:
- (1) A timely and effective response to any spill incidents occurred on the HKLR;
 - (2) The coordination of the relevant government departments to deal with the spill; and
 - (3) Minimal impacts to the aquatic environment and ecological system in North Lantau.
- 1.3 The priorities for control of the spill are as follows:
- (1) The primary aim is to control the spreading of spill on the road surface of the HKLR and prevent release of spills into waters of North Western Water Control Zone and North Western Supplementary Water Control Zone, either through the road drainage system or by other means; and
 - (2) The secondary aim is to clean up the spill and re-open any affected area of HKLR carriageway to traffic as soon as possible.

2 Chemicals of Concern

- 2.1 There are wide varieties of chemicals. Oils, fertilizers, corrosive or poisonous chemicals will pose serious threat to the ecology of waters in North Western Water Control Zone and North Western Supplementary Water Control Zone. However, other chemicals, when poured to the waters in vast quantities, may also affect the ecology to certain extent. This ERP therefore deals with general chemical spillage instead of restricting itself to only certain categories of chemicals.
- 2.2 Chemicals in liquid state or chemicals soluble in water are of most concern because there is a higher risk of these of chemicals to release into the seawater through the road drainage system.

3 Sensitive Areas

- 3.1 The HKLR is located in North Western Water Control Zone and North Western Supplementary Water Control Zone, which is an ecologically sensitive area. The highest dolphin density in Hong Kong is found in the Northwest Lantau waters and some ecologically sensitive areas inside the Airport Channel. The road drainage system collecting the road runoff would be directly discharged into the waters of North Western Water Control Zone and North Western Supplementary Water Control Zone. In case of a vehicle

accident on the bridge, it may cause the spillage of chemicals that would have potential impacts to the ecology in the waters if the spillage were not dealt with properly.

- 3.2 There are a number of water sensitive areas in the vicinity (Figure 9.5 Location of Water Quality and Ecological Sensitive Receivers of the EIA Report for HKLR refers). Some of them are located in the close proximity to the HKLR. The following gives a list of the key sensitive areas in North Western Water Control Zone and North Western Supplementary Water Control Zone:

- (1) Tai O
- (2) Sham Wat
- (3) Sha Lo Wan
- (4) Hau Hok Wan
- (5) San Tau SSSI
- (6) Tai Ho Wan Inlet
- (7) Artificial Reef in NE Airport
- (8) Sha Chau and Lung Kwu Chau Marine Park
- (9) The Brothers Marine Park
- (10) Gazettal beaches in Tuen Mun
- (11) Butterfly Beach
- (12) Proposed Southwest Lantau Marine Park
- (13) The marine ecology sensitive receivers as shown in the Figure 9.5 of the EIA Report

- 3.3 **Figure 1** shows the locations of these sensitive areas.

4 Drainage System on HKLR

- 4.1 Two types of drainage systems are adopted on HKLR viaducts:

- (1) Type A – comprising conventional road side gullies with carrier drains inside the bridge deck and discharge down pipes;
- (2) Type B – comprising road side gullies with overflow weir only without carrier drains and discharge down pipes.

The as-built drawings of the drainage systems are enclosed in **Appendix B**.

5 Response Organizations and Emergency Response Plan

- 5.1 In a chemical spillage incident, a prompt action to prevent the spillage from releasing into the waters is the major task. A quick response time is therefore crucial in dealing with the spillage incident. The main response departments and the relevant emergency response plans being implemented are given below. A flow chart depicting the procedures in dealing with chemical spillage incidents on HKLR, briefly listing out the respective responsibilities of various parties, is shown in **Appendix A**:

Highways Department (HyD)

- 5.2 HyD, as the controller of this ERP, is responsible for the overall co-ordination with other government departments in dealing with the spill incident on HKLR.
- 5.3 HyD is the maintenance authority of the HKLR.
- 5.4 The *Highways Department Emergency Handbook* defines the responsibilities of HyD and provides detailed procedures to deal with emergency situations that may occur on roads. In case of chemical spillage on the HKLR, HyD will follow the procedures specified in the Handbook. In particular, in accordance with Clause 2.1 of the Handbook, HyD is responsible for informing the contractor to mobilize emergency plants/materials (e.g. sandbags) to confine chemical spills, upon identification of the incident by emergency parties i.e. HKPF and FSD.

- 5.5 Within the resources of the department or through the term maintenance contractors, HyD will be responsible for the following duties:
- (1) Assist HKPF and TD in the setting up of traffic contra-flow by removal/opening of the water-filled barriers/drop gates at the cross-overs at the East Portal of Tunnel SHT, West Portal of Tunnel SHT and the Turnaround Facility at HLKR Viaduct (Pier No. 56), and to reinstate/close the barriers/drop gates prior to resuming normal traffic operation of the HKLR when directed by TD;
 - (2) Assist other departments to control the situation, assist to confine the chemical spillage by transporting sandbags to the spot as far as possible, assist to block the gullies (e.g. with sandbags) if required at those areas which are safe from the chemicals, assist to recover/handle spilled oil, using sawdust or dry sand under the supervision of EPD or other relevant departments. In addition, provide vacuum tanker vehicle in case it is necessary, the usage of which is under the direction of EPD/GL.
 - (3) When necessary, provide equipment and manpower to assist EPD's licensed chemical waste collector to collect the spilled chemical on HKLR immediately after the incident with the advice provided by EPD;
 - (4) Reinstate/repair any damaged road surface, essential viaduct structure and street furniture immediately after the affected area is cleaned up to enable the earliest resuming of the affected area on the HKLR to traffic;
 - (5) Assign licensed chemical waste contractor to collect and transport the chemical wastes which are non-treatable at the Chemical Waste Treatment Centre (CWTC) (including sand bags soaked with chemicals) to the landfills, and to clear the chemicals/chemical wastes and flushing water etc. remained at the scene;
 - (6) Regularly update this ERP, as necessary, to improve the ERP in response to deficiencies;
 - (7) In case grey areas are identified, trigger the horizontal communication across departments so as to ensure speedy resolution of these grey areas; and
 - (8) Update all the concerned departments of any revised versions of ERP for their incorporation of the specific requirements into their own plans and drills, and to liaise with individual department as regards the compatibility of this ERP with their drills.
 - (9) Notify Airport Authority Hong Kong (AAHK) and Drainage Services Department (DSD) about the incident if the affected area is fall within their jurisdiction.

Transport Department (TD)

- 5.6 In case of vehicle accident with, or with likelihood of, chemical spillage on HKLR, TD and HKPF's "Regional Command and Coordination Centre" will monitor the traffic conditions within Hong Kong portions of HKLR and in its vicinity through the 24-hour Traffic Control and Surveillance System (TCSS) operated by TD.
- 5.7 TD will assist HKPF to ascertain the necessity of traffic diversion and control, and whether partial or total road closure is required. TD will assist the temporary traffic management / arrangement including contra-flow traffic arrangement if necessary by controlling the TCSS. TD, in consultation with Police Public Relations Branch (PPRB), will be responsible for disseminating traffic diversion and lane/road closure as well as other related traffic and transportation information for motorists through the media and to other parties if necessary. Regarding cross-boundary coach services on HKLR, TIMS duty officers will arrange publicity on the closure of HKLR, inform THB duty officer, and inform the cross-boundary coach associations that the HKLR is to be closed. TIMS duty officer will request them to adjust service level / suspend service as appropriate.

Hong Kong Police Force (HKPF)

- 5.8 The "New Territories Regional Command and Control Centre (RCCC NT)" of HKPF operates 24 hours in parallel with "Fire Services Communications Centre (FSCC)" of FSD. Upon receiving the report of vehicle accident with, or with likelihood of, chemical spillage

- on the HKLR from TD or other sources, RCCC NT will immediately activate this ERP and inform the relevant government departments including but not limited to those departments identified under this ERP to take immediate actions to deal with the (potential) chemical spillage.
- 5.9 As HKPF and FSD are usually the first emergency services to arrive at the scene, they will carry out a preliminary assessment as to the likelihood of chemical spillage from vehicle, and if spillage has occurred, the likelihood of the spill entering into the drainage system of HKLR. HKPF should keep RCCC NT informed of the seriousness of the incident and provide RCCC NT with regular updated situation reports.
- 5.10 In the event of traffic congestion brought about by a chemical spillage incident, HKPF will inform the Mainland/Macao Authorities through the established border liaison channel for any incidents which may cause serious disruption to the operation of the HZMB and HKLR. They may request the Mainland/Macao Authorities for assistance from Mainland/Macao as and where necessary.
- 5.11 HKPF will be a key member of the ad hoc chemical spillage response team comprising representatives of all relevant departments to deal with (potential) chemical spillage from vehicle. The duties of the response team are as follows:-
- (1) To assess the seriousness of the chemical spillage, the likelihood and the means to avoid the chemicals entering into the drainage gullies or waters of North Lantau, in order to determine the immediate actions to be undertaken by each department.
 - (2) To coordinate between different departments involved.
 - (3) To determine whether and what additional support and assistance from other departments not included in this ERP should be called upon directly or through policy bureaux.
- 5.12 Other duties of the HKPF in case of chemical spillage includes: -
- (1) Protect life and property.
 - (2) Initiate a cordon of the area affected by the chemical spillage under the advice of FSD and EPD and implementing traffic management and control measures for people, vehicles or vessels at the scene. HKPF will also transport sawdust stored inside the HyD's workshop (See **Figure 2**) to a safe place near the scene.
 - (3) Assist in evacuation of the affected area, if necessary.
 - (4) Implementing traffic management and control measures on all roads leading to the scene.
 - (5) Provide escort to emergency/rescue vehicles and/or transports carrying plants and equipment to deal with the chemical spillage in case they are delayed by traffic jams.

Fire Services Department (FSD)

- 5.13 FSD is mainly responsible for fire-fighting and rescue. The fire station at the Hong Kong Boundary Crossing Facility will be supported by two nearby fire stations – Chek Lap Kok Fire Station and Tung Chung Fire Stations (See the location plan in **Figure 3**). It is expected that the response time to any accident/incident would be in terms of several minutes.
- 5.14 FSD has established procedures to deal with chemical spillage. FSD Officer-In-Charge (Oic) of the incident will appraise the situation and assess whether the accident/incident is a Major and/or Prolonged Chemical Incident. FSD will be responsible to take the following actions: -
- (1) Protect life & property, and remove immediate danger.
 - (2) Identify the type of chemicals such as whether it would be poisonous / hazardous to human being in the vicinity through inhalation or contact, or whether it is flammable / explosive and determine whether evacuation of the area is necessary. FSD will advise HKPF the extent of the cordon area. In case the chemicals cannot be identified on the

scene, FSD will seek information from the consignee firm and/or call upon GL to identify the chemical.

- (3) Control or secure the situation such as confining the spillage, the effect of chemical contamination and etc., by appropriate means, by turning off valves or removal from the sources, or by other method of inhibiting the reaction.
- (4) Assistant to other Government Department may render upon request.

Marine Department (MD)

5.15 MD is the designated authority for the clean up of oil spillage at sea. When the chemical spill from a vehicle accident has been released from HKLR into the waters, MD will endeavour to regulate the marine traffic in and in the vicinity of the affected area, subject to available depth of water and a risk hazard assessment of the working environment confirmed that the prevailing environment is safe. In case of oil spillage into the marine waters, the response actions from MD will follow the *Maritime Oil Spill Response Plan* (MOSRP), which has been developed to deal with oil spill and their potential hazard to the waters of HKSAR, in order to provide a timely response to oil spillages.

5.16 The other responsibilities of MD include:

- (1) Provide absorbents, booms and skimmers for controlling the spill at where and when practical and desirable;
- (2) Assist to endeavour to regulate the marine traffic in and in the vicinity of the affected area, subject to available depth of water and a risk hazard assessment of the working environment confirmed that the prevailing environment is safe; and
- (3) Monitor the spill situation and reporting extent of pollution.

Due to the remote waters in North Lantau, in order to provide timely and effective responses to the incidents, MD would solicit assistance from Marine Police as necessary.

5.17 In principle, either MD or the Zhuhai/Macao counterpart will not be responsible for any cross border cleaning up of the oil spillage at sea, unless request is made by the governing side of the incident scene to the other side. In such case, coordination will be through HKPF, who is the principal coordinating department with the Zhuhai/Macao Government through the established border liaison channel.

5.18 However, even if the oil spillage is confined to the waters of HZMB Main Bridge, MD will arrange a duty-officer to take in charge of the clean-up operation at sea and render assistance when the situation warrants. And the MD Patrol launch deployed at the scene/in vicinity main duty is to provide traffic regulating.

Environmental Protection Department (EPD)

5.19 EPD has plans responding to marine based and land based pollution incidents in the territory. EPD will follow these plans as appropriate in handling such incidents.

Government Laboratory (GL)

5.20 When requested by FSD, GL will provide assistance in chemical identification in a chemical spillage incident and advise the characteristics of the chemical so as to help FSD and HKPF to plan the operational strategy. If necessary, GL will send an officer to the scene to assist in locating/identifying the chemical, analyse the levels of toxic substances at scene and/or provide advice to stabilise/handle/dispose the chemical.

Agriculture, Fisheries and Conservation Department (AFCD)

5.21 AFCD will advise on the protection of ecologically sensitive areas in the waters; provide assistance and comments on the methods for cleaning up the substances/wastes/chemicals washed ashore in the nearby marine parks, especially their ecological impacts as recommended by relevant authorities; and monitor the ecological conditions and assess the potential ecological/fisheries impacts at the likely affected ecologically sensitive areas.

Leisure and Cultural Services Department (LCSD)

- 5.22 HyD will provide back up equipment and personnel to assist LCSD in removal of landed oil from gazetted beaches according to MOSRP.

Food and Environmental Hygiene Department (FEHD)

- 5.23 In case of oil spillage incidents, FEHD will provide manpower to assist to manual removal of non-contaminated refuse not classified as chemical or hazardous waste on non-gazetted beaches and foreshores that are without land access if necessary. For non-gazetted beaches and foreshores where land access is available, HyD is responsible for providing equipment and personnel for the removal of landed oil.

District Office (Islands) and District Office (Tuen Mun)

- 5.24 DO(Islands) and DO(Tuen Mun) will inform the relevant District Council member(s) and Village Representative(s) in case of chemical spillage incidents in the waters as necessary.

Security Bureau

- 5.25 If coordination with the Zhuhai/Macao side is required in traffic control during the exercise/drills (if any), Security Bureau will help liaison work, particularly at the initial stage.

Maintenance Authority of Main Bridge of HZMB

- 5.26 The HZMB Authority is responsible for the operation, management and maintenance of the Main Bridge of HZMB. In principle, the HZMB Authority will be responsible for emergency response actions for chemical spillage on the Main Bridge of HZMB.

Owner of the Chemicals

- 5.27 In case of chemical spillage incidents, the responsibilities of the owner of the chemicals include the following:-
- (1) Advise the type and characteristics of the chemicals;
 - (2) Remove the chemicals and those sand bags / absorbents which are soaked with chemicals, including the spilled chemicals on the road carriageway, in the waters and those washed ashore.
- 5.28 If the owner of the chemicals does not possess suitable plant and machinery for the removal, the owner could hire a contractor to do the job for himself, or alternatively the Government can do the job and then charge the owner accordingly. If the owner is reluctant to take action, relevant Government authorities could prosecute the owner according to the relevant laws of Hong Kong.

6 Emergency Response Actions

- 6.1 In the event of vehicle accident on the HKLR, the relevant government departments will implement the existing emergency response plans to deal with the incident.
- 6.2 It is important for the relevant government departments to confine the spill to be within the HKLR such that water quality and ecological impacts to the waters would be minimised.
- 6.3 At least 24 nos. dry sandbags and sawdust will be stored at HyD's workshop at HMA (See **Figure 2**). HyD (with the assistance from HKPF if necessary) will transport the materials to the scene to control the spreading of any spilled chemical and to prevent the spilled chemical from entering into waters near HKLR.
- 6.4 The general operational guidelines to deal with the spill to minimise water quality and ecological impacts include:
- (1) Identify the type of chemicals if it would be poisonous/hazardous to human being in the vicinity through inhalation of / contact with them, or flammable / explosive which require immediate evacuation of the area;
 - (2) Evacuate the area as necessary;
 - (3) Stop the flow of spill from the source of the pollution;

- (4) Confine the spill to a limited area and prevent the spill from entering the road drainage system of HKLR;
 - (5) Avoid spraying water or chemicals unless it is absolutely necessary; for oil spills to the waters, no oil dispersants should be used. For chemical spill, the measures to be taken will need to be decided case by case. Appropriate techniques and methods with careful study and assessment should be adopted. AFCD, EPD and/or GL should be consulted as needed.
 - (6) Remove the spilled chemical by using suitable equipment and materials; e.g. absorbent to absorb the oil on the road surface. The absorbent should be able to absorb oil material at a high ratio of oil to absorbent.
 - (7) Dispose of the collected spill and the used absorbent as chemical wastes once the spill has been removed from the road surface.
 - (8) Any flushing water (or other chemicals) for cleaning spilled chemical on HKLR should be retrieved by vacuum suction or equivalent means to suitable container for proper disposal. Flushing chemicals to the waters, either directly or via the road drainage system of HKLR, is strictly prohibited.
 - (9) Monitor the dispersion of the spilled chemicals in the waters.
- 6.5 Personnel responsible for the clean up operation should take safety precautions in accordance with the corresponding departmental guidelines and procedures.
- 6.6 According to the Height Restricted Areas and Special Areas for the Hong Kong Link Road and the Hong Kong International Airport Approach Restricted Areas under Fifth Schedule of Cap. 313A and Section 12 & 18B of Cap. 548F respectively, the relevant emergency responsible departments should deploy their emergency team and vessels in the vicinity to evaluate their vessel height in compliance with the height restriction under the law.

7 Liaison with Mainland Authority

- 7.1 HKPF will notify the Mainland Authority through the established border liaison channel for the accident and requesting for assistance from Mainland where necessary. TD/HKPF will also notify the Mainland Authority if any traffic diversion and lane/road closure are required to be implemented on the Main Bridge.

8 Training and Drill

- 8.1 In order to provide a prompt response to an emergency event, relevant government departments who are responsible for dealing with the spill incident must be familiar with the procedures and the operation of the essential equipment. Regular training should be provided to all designated personnel of all relevant government departments / non-government departments concerned to deal with the spill incident on HKLR. The areas that should be covered in the training include:
- (1) Procedures to deal with spill incident
 - (2) Ordinance and regulations related to chemical waste control
 - (3) Awareness of chemical waste hazards and pollution
 - (4) Roles and responsibilities
 - (5) Precaution and safety measures
 - (6) Spill clean up
 - (7) Spill disposal
- 8.2 In addition, it is important to regular test-run to establish the effectiveness of this ERP. The aim is to ensure good coordination and prompt action amongst relevant government departments. Testing will take the form of an exercise or drill to practice responding to a spill on the HKLR. The exercise is aimed to build the sense of teamwork and familiarity from relevant government departments. It makes the response more effective and efficient

when an actual spill incident occurs. Details of the training and drill by each individual party should refer to their own standing practice that is currently in force in Hong Kong. HyD, as the controller of this ERP, is responsible for updating all the concerned departments of any revised versions of the ERP for their incorporation of the specific requirements in this ERP into their own drills. Liaison with individual departments as regards the compatibility of this ERP with their drills could be held as necessary.



9 Contact List for Spillage of Chemicals

Immediate Reporting of Incident		
Hong Kong Police Force (HKPF)	Emergency 24 hrs Hotline	999
Designated Response Departments		
Home Affairs Department (HAD)	Senior Liaison Officer (2), Islands District Office	2852 4573 / 9380 7484
	Senior Liaison Officer (1), Tuen Mun District Office	2451 3032
Highways Department (HyD)	HyD Emergency Control Centre (ECC)	2926 4333
Transport Department (TD)	Emergency Transport Co-ordination Centre (ETCC)	2410 0066 / 2410 0193
Hong Kong Police Force (HKPF)	Duty Officer (Tuen Mun)	TBA
	Duty Officer (Tung Chung)	3661 1694
	Duty Officer (Chek Lap Kok)	3661 1668
Fire Services Department (FSD)	Hong Kong-Zhuhai-Macao Bridge Fire Station cum Ambulance Depot	2516 0201
Marine Department (MD)	Vessel Traffic Centre (VTC)	2233 7801
Environmental Protection Department (EPD)	Mr. Alfred Lo (Environmental Protection Officer)	2516 1782
Government Laboratory (GL)	Duty Chemists	Responder 1: 6377 6591 Responder 2: 6377 6599
Agriculture, Fisheries and Conservation Department	Dr. YM Mak	3468 5742

(AFCD)	(Marine Conservation Officer)	
Leisure and Cultural Services Department (LCSD)	For gazetted beaches in Tuen Mun District:	
	1. Senior Leisure Manager (Aquatic Venues)	2601 8873 / 9195 1385
	2. Chief Leisure Manager (Aquatic Venues)	2601 8083 / 6291 0027
	3. District Leisure Manager (Tuen Mun)	2451 3102 / 9195 9170
Food and Environmental Hygiene Department (FEHD)	Chief Health Inspector (Operations)1	2867 5657
	Chief Health Inspector (Operations)3	2867 5644
	Chief Health Inspector (Cleansing & Pest Control)1	2867 5290
Islands District Council Member 離島區議會議員		
Chairman 主席	YU Hon Kwan 余漢坤	2984 7633 2984 7656
Tai O Rural Committee 大澳鄉事委員會		
Chairman 主席	HO Siu Kei 何紹基	9837 3283
Mui Wo Rural Committee 梅窩鄉事委員會		
Chairman 主席	WONG Man Hon 黃文漢	9079 6618
Village Representatives		
SAN TAU 磧頭		
Indigenous Inhabitant Representative 原居民代表	TSE King Till 謝擎天	9090 3696
Resident Representative 居民代表	HO Siu Kei 何紹基	9837 3283
SHA LO WAN 沙螺灣		
Indigenous Inhabitant Representative 原居民代表	LI Sau Mui 李秀梅	9022 4187
Resident Representative 居民代表	CHAN Chi Kuen 陳志權	6875 6262

SHAM SHEK 深石		
Resident Representative 居民代表	NG Fung-lin 吳鳳蓮	5668 9793
PAK MONG 白芒		
Indigenous Inhabitant Representative 原居民代表	KWOK Wai Man 郭偉文	9258 2406
Resident Representative 居民代表	KWOK Ma Keung 郭馬強	9252 9982
NGAU KWU LONG 牛牯壆		
Indigenous Inhabitant Representative 原居民代表	LUM Sai Ming 林世明	Not agree to disclose
Resident Representative 居民代表	LAM Hing Kwai 林慶貴	6159 1392
TAI HO 大鵝		
Indigenous Inhabitant Representative 原居民代表	CHOW Cheung Fuk 鄒長福	9497 0381
Resident Representative 居民代表	Vacant	-

Appendix A - Flow Chart for Responsibilities of Various Parties in case of Chemical Spillage Incidents

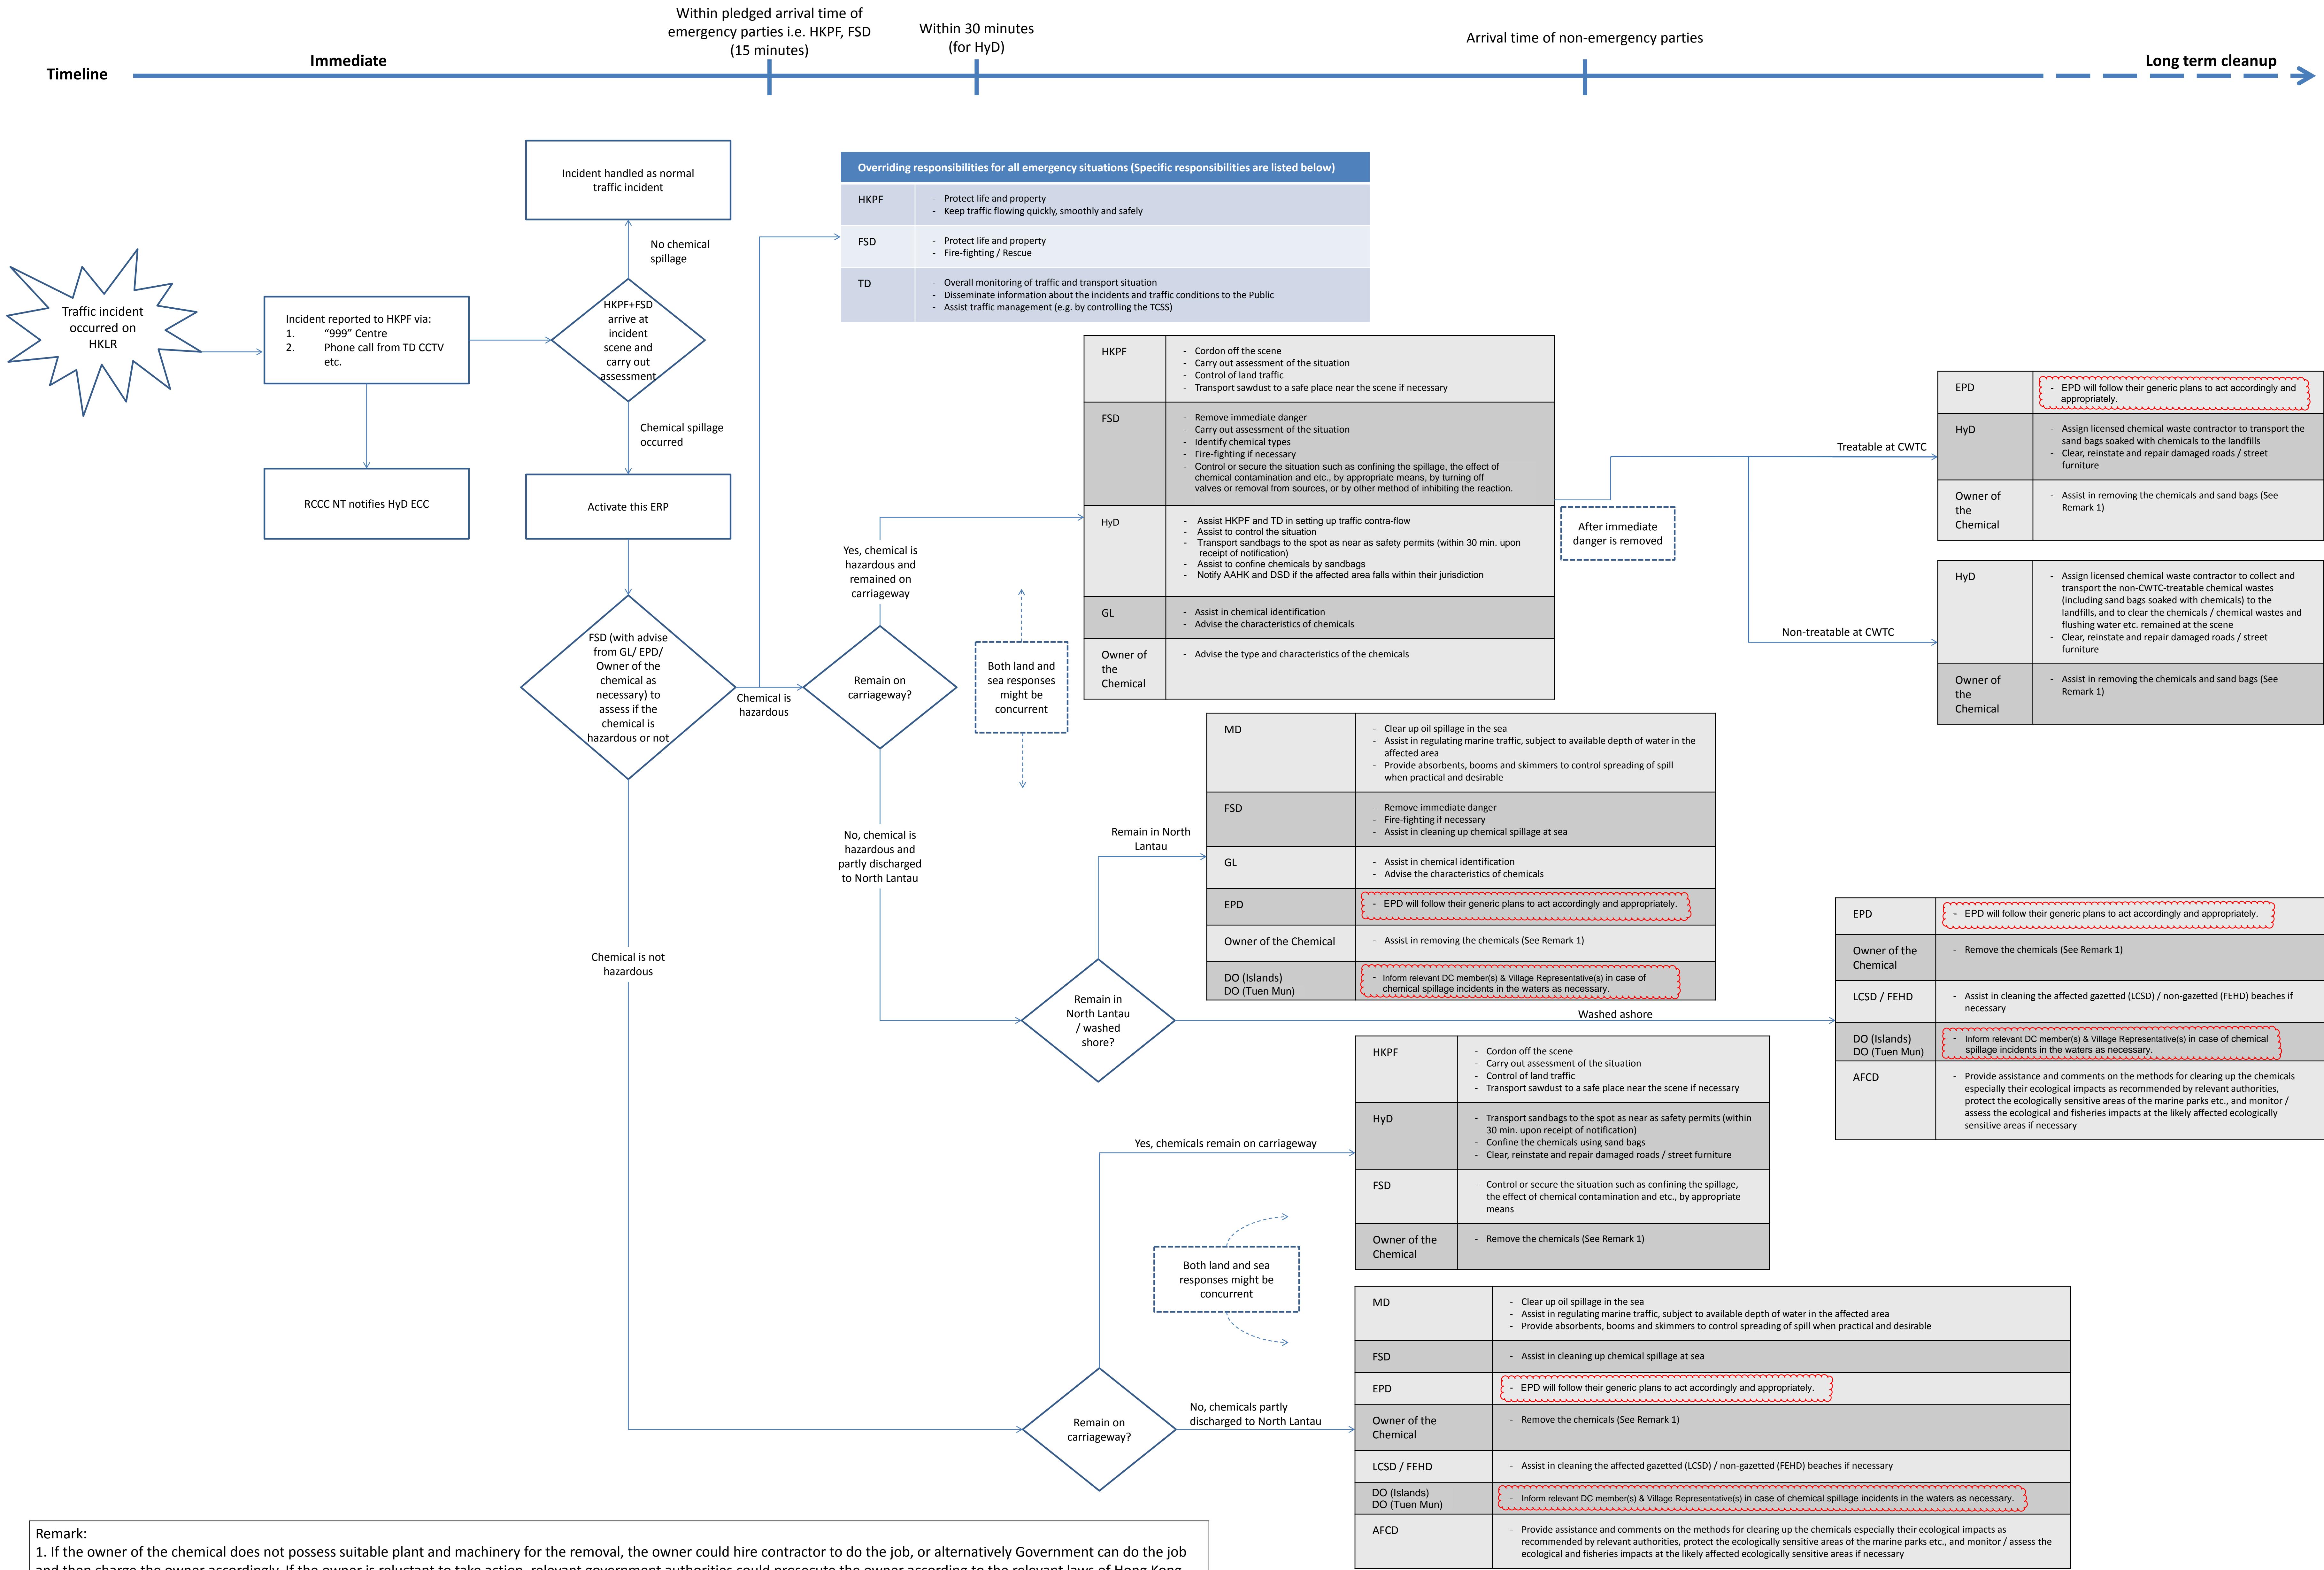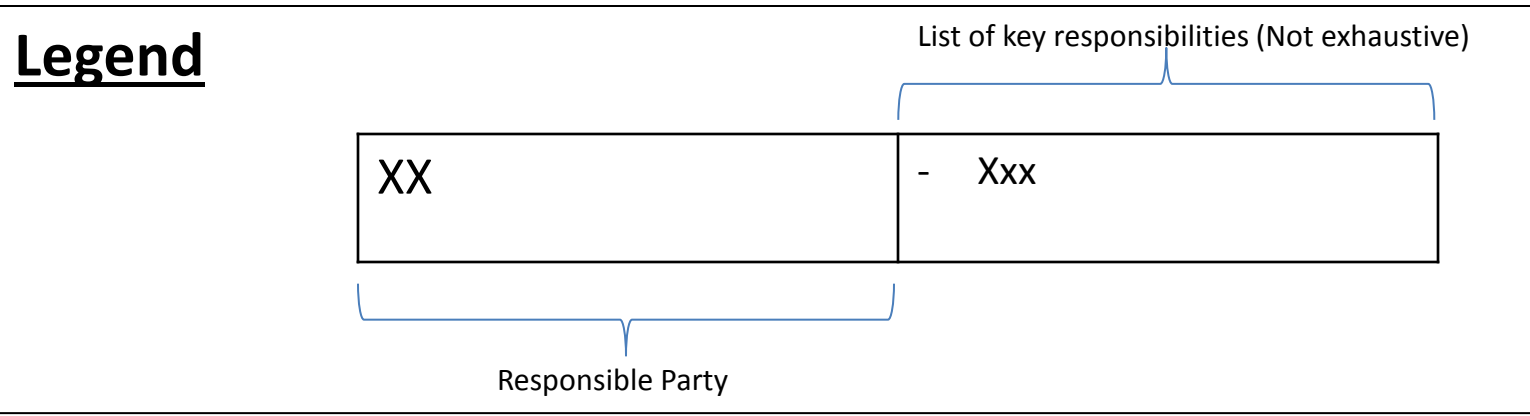

Remark:
1. If the owner of the chemical does not possess suitable plant and machinery for the removal, the owner could hire contractor to do the job, or alternatively Government can do the job and then charge the owner accordingly. If the owner is reluctant to take action, relevant government authorities could prosecute the owner according to the relevant laws of Hong Kong.

Appendix B – As-built Drawings of Drainage System of HKLR Viaducts


Drawing Number	Drawing Title
HKLR9/MMH/AB/PW/DN/00000	General Notes for Drainage
HKLR9/MMH/AB/PW/DN/00001	Proposed Viaduct Drainage System - Key Plan
HKLR9/MMH/AB/PW/DN/00002	Proposed Viaduct Drainage System Layout (Sheet 1 of 8)
HKLR9/MMH/AB/PW/DN/00003	Proposed Viaduct Drainage System Layout (Sheet 2 of 8)
HKLR9/MMH/AB/PW/DN/00004	Proposed Viaduct Drainage System Layout (Sheet 3 of 8)
HKLR9/MMH/AB/PW/DN/00005	Proposed Viaduct Drainage System Layout (Sheet 4 of 8)
HKLR9/MMH/AB/PW/DN/00006	Proposed Viaduct Drainage System Layout (Sheet 5 of 8)
HKLR9/MMH/AB/PW/DN/00007	Proposed Viaduct Drainage System Layout (Sheet 6 of 8)
HKLR9/MMH/AB/PW/DN/00008	Proposed Viaduct Drainage System Layout (Sheet 7 of 8)
HKLR9/MMH/AB/PW/DN/00009	Proposed Viaduct Drainage System Layout (Sheet 8 of 8)
HKLR9/MMH/AB/PW/DN/00102	Typical Drainage Details at Turnaround Facility
HKLR9/MMH/AB/PW/DN/00103	Typical Drainage Downpipe Arrangement- Pier P17
HKLR9/MMH/AB/PW/DN/00104	Typical Drainage Downpipe Arrangement- Pier P79
HKLR9/MMH/AB/PW/DN/00105	Typical Drainage Downpipe Arrangement- Pier P68
HKLR9/MMH/AB/PW/DN/00106	Typical Drainage Downpipe Arrangement- Pier P77
HKLR9/MMH/AB/PW/DN/00107	Typical Drainage Downpipe Arrangement- Pier P85
HKLR9/MMH/AB/PW/DN/00108	Typical Drainage Downpipe Arrangement- Pier P87, P88, P89, P90, P94, P95, P96, P97, P98, P101 and P103
HKLR9/MMH/AB/PW/DN/00109	Typical Drainage Downpipe Arrangement- Pier P107
HKLR9/MMH/AB/PW/DN/00110	Typical Drainage Downpipe Arrangement
HKLR9/MMH/AB/PW/DN/00111	Typical Drainage Downpipe Arrangement- Pier P113
HKLR9/MMH/AB/PW/DN/00112	Typical Drainage Downpipe Arrangement- Pier P110
HKLR9/MMH/AB/PW/DN/00113	Typical Drainage Downpipe Arrangement- Pier P100
HKLR9/MMH/AB/PW/DN/00114	Typical Drainage Downpipe Arrangement- Pier P93
HKLR9/MMH/AB/PW/DN/00115	Typical Drainage Downpipe Arrangement- Pier P86
HKLR9/MMH/AB/PW/DN/00116	Typical Drainage Downpipe Arrangement - Pier P91
HKLR9/MMH/AB/PW/DN/00117	Typical Drainage Downpipe Arrangement - Pier P20
HKLR9/MMH/AB/PW/DN/00118	Typical Drainage Downpipe Arrangement - Pier P18
HKLR9/MMH/AB/PW/DN/00119	Typical Drainage Downpipe Arrangement - Pier P69
HKLR9/MMH/AB/PW/DN/00120	Typical Drainage Downpipe Arrangement - Pier P71, P72, P73 & P75
HKLR9/MMH/AB/PW/DN/00121	Typical Drainage Details Interface Abutment
HKLR9/MMH/AB/PW/DN/00124	Typical Drainage Details - Hanger Support
HKLR9/MMH/AB/PW/DN/00125	Typical Drainage Details - Drainage Hopper and Rodding Eye
HKLR9/MMH/AB/PW/DN/00126	Typical Drainage Details - Gully connection Pipe
HKLR9/MMH/AB/PW/DN/00128	Typical Drainage Arrangement for Widening Section
HKLR9/MMH/AB/PW/DN/00130	Typical Drainage Details Drainage Hopper
HKLR9/MMH/AB/PW/DN/00132	Typical Drainage Downpipe Arrangement - Pier P76
HKLR9/MMH/AB/PW/DN/00133	Typical Drainage Downpipe Arrangement Pier P82 & P83
HKLR9/MMH/AB/PW/DN/00134	Typical Drainage Details Downpipe Arrangement - Pier P105
HKLR9/MMH/AB/PW/DN/00137	Typical Drainage Downpipe Arrangement Pier P80
HKLR9/MMH/AB/PW/DN/00150	TYPICAL DRAINAGE DOWNPIPE ARRANGEMENT PIER P87, P96, P98, P103

Printed by : 9/23/2019
Filename : D:\HKL\R9\As-Built drawings\DDA_20\Final As-Built drawings\Part 8\HKL_R9_MWH_AB_PW_DN_00000.dgn

GENERAL NOTES FOR VIADUCT DRAINAGE


- UNLESS NOTED OTHERWISE ON A PARTICULAR DRAWING, NOTES ON THIS DRAWING APPLY TO ALL OTHER DRAWINGS. SPECIFIC NOTES RETAINING TO PARTICULAR ELEMENT OF WORK ARE SHOWN ON EACH DRAWING.
- ALL WORKS ARE IN ACCORDANCE WITH CURRENT EDITION OF HONG KONG GOVERNMENT GENERAL SPECIFICATIONS FOR CIVIL ENGINEERING WORKS AND THE ASSOCIATED CONSTRUCTION SPECIFICATIONS FOR THE CONTRACT.
- ALL CO-ORDINATES ARE REFERRED TO HONG KONG (1980) METRIC GRID CO-ORDINATES SYSTEM.
- ALL LEVELS SHOWN ARE IN METRES AND REFER TO THE PRINCIPAL DATUM (MPD).
- ALL DIMENSIONS ARE IN MILLIMETRES UNLESS OTHERWISE STATED.
- NO DIMENSIONS ARE OBTAINED FROM SCALING DRAWING.
- ALL CHAINAGES ARE IN METRE.
- ALL GROUND PROFILES, SEABED LEVEL AND WATER LEVEL ARE INDICATIVE ONLY.
- UNLESS SPECIFIED OTHERWISE INDICATED CROSS SECTIONS SHOW THE BRIDGE DECK LOOKING EAST.
- THIS SET OF DRAWINGS DOES NOT NECESSARILY INDICATE THE FULL EXTENT OF PROPOSED SERVICES. ANY MODIFICATION TO THE PROPOSED SERVICES SHALL BE CONFIRMED WITH SOR AND DUE ALLOWANCE SHALL BE MADE IN THE CONSTRUCTION PROGRAMME.
- DRAINAGE SYSTEM FOR VIADUCT COMPRISES:
TYPE A: ROAD SIDE GULLY WITH CARRIER DRAINS AND DOWN PIPES
TYPE B: ROAD SIDE GULLY WITH OVERFLOW PIPE ONLY WITHOUT CARRIER DRAINS AND DOWN PIPES
- OUTLET PIPES FROM GULLIES TO LONGITUDINAL CARRIER PIPES SHALL HAVE A MIN. GRADIENT OF 1 IN 40 WHEN THE DECK SEGMENTS ARE INSTALLED IN THEIR FINAL POSITION. UNLESS SHOWN OTHERWISE LONGITUDINAL CARRIER PIPES SHALL HAVE A GRADIENT AS SHOWN ON DRAWING NOS. HKLR9/MMH/AB/PW/DN/00002 - DN/00009.
- PIPEWORK SHALL BE UPVC, AND THE PIPES SHALL BE THOSE DESIGNATED AS CLASS B IN BS3506:1969 AND SHALL CONFORM TO THE RELEVANT REQUIREMENTS OF BS3506:1969.
JOINTS IN UPVC DRAIN PIPES MAY TAKE THE FORM OF EITHER:
(a) ELASTOMERIC SEALING RING JOINT ASSEMBLIES, OR
(b) SOLVENT WELDED JOINT ASSEMBLIES
- GULLY GRATINGS SHALL BE TYPE GA1-450 WITH DEEP FRAMES AS SHOWN ON HyD STD. DRG. NOS. H3117, H3118, UNLESS OTHERWISE SPECIFIED. FRAMES SHALL BE BEDDED ON 1:3 SAND CEMENT MORTAR.
- INSTALLATION DETAILS SHOW THE GULLY SUMPS WITH THEIR PIPE OUTLETS INCORPORATED INTO THE DECK SEGMENTS DURING INITIAL CASTING.
- GRADIENT FOR STORMWATER DRAINS ARE AS SHOWN ON THE DRAWINGS. MAXIMUM GRADIENT FOR STORMWATER DRAINS TO SUIT MAXIMUM VELOCITY LIMIT OF 6m/s.
- ALL LOW OR SAG POINTS IN CARRIAGEWAY SHALL BE PROVIDED WITH THE REQUIRED NUMBER OF GULLIES AS SHOWN ON LAYOUT PLAN DRAWINGS. KERB OVERFLOW WEIRS WITH THE VERTICAL BARS SHALL BE PROVIDED ON EACH GULLY.
- GULLY DETAILS AND SPACINGS SHALL REFER TO DRAWING NO. HKLR9/MMH/AB/PW/DN/00101.
- KERB OVERFLOW SHALL BE PROVIDED AS INDICATED ON THE DRAWINGS. FOR DETAILS OF KERB OVERFLOW WEIR REFER TO HyD STD. DRG. NO. H3127.
- THE LOCATION OF LOW POINTS SHALL BE IN ACCORDANCE WITH LONGITUDINAL PROFILE OF ROAD AS SHOWN ON DRAWING NOS. HKLR9/MMH/AB/PW/RW/00021 - 00029.
- AT GRADE PETROL INTERCEPTOR NEAR SHT TUNNEL SHALL REFER TO DRAWINGS HKLR9/MMH/AB/PW/DN/00141 AND 00122 OF DDA20. FOR ANOTHER PETROL INTERCEPTOR AT TURNAROUND FACILITY PLEASE REFER TO DRAWINGS HKLR9/YML/AB/TF/SP/06601, 06603 AND 06652 OF MLB.4 SUBMISSION PACKAGE.

TYPICAL GULLY ARRANGEMENT AT SAG POINT

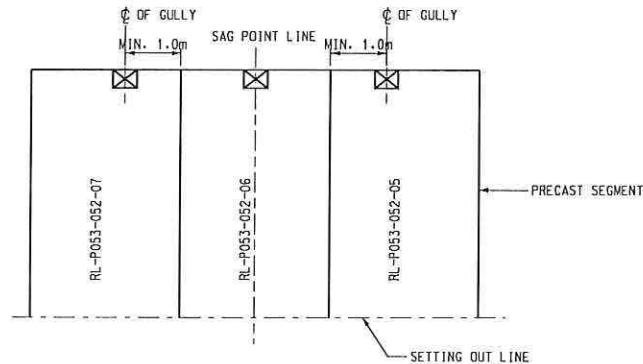

- GULLY SHALL BE PLACED AT THE SAG POINT AS FAR AS POSSIBLE.
- THE MINIMUM CLEARANCE BETWEEN THE GULLY AND SEGMENT EDGE SHALL BE 1000mm.

LEGEND

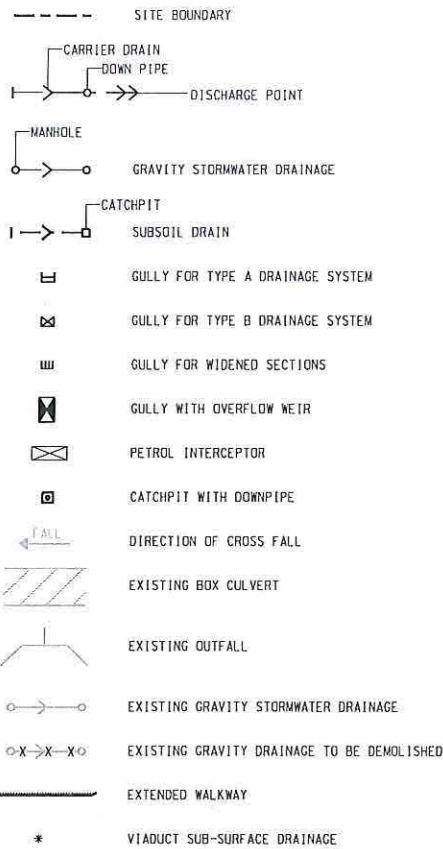

NOTES FOR LANDSIDE DRAINAGE AND SEWERAGE WORKS

- MANHOLE COVER SHALL BE FLUSH OR NOT MORE THAN 5mm BELOW FINISHED ROAD SURFACE. COVER LEVEL SHOWN FOR MANHOLE IS APPROXIMATE ONLY. THE ACTUAL COVER LEVEL SHALL BE VERIFIED ON SITE.
- CONCRETE FOR MANHOLE SHALL BE GRADE 30/20 UNLESS STATED OTHERWISE.
- FOR MANHOLE DETAILS, REFER TO THE FOLLOWING DSD STD. DRGS.

MANHOLE TYPE	DSD STANDARD DRAWING NO. AND TYPE
D1	DS1079
E1	DS1080
F1	DS1081
G1	DS1082
H	DS1009
I	DS1011
J	DS1013
K	DS1015
L	DS1017
- FOR DETAILS OF TOP TREATMENT TO MANHOLE, REFER TO DSD STD. DRG. NO. DS1032.
- FOR DETAILS OF MANHOLE COVER AND FRAME, REFER TO DSD STD. DRG. NOS. DS1033, DS1034, DS1076 AND DS1077.
- FOR DETAILS OF MANHOLE STEP IRON, REFER TO DSD STD. DRG. NO. DS1043.
- UNLESS OTHERWISE STATED, PRECAST CONCRETE PIPES TO BS 5911 SHALL BE USED FOR STORMWATER DRAINS.
- PRECAST CONCRETE PIPES AND FITTINGS SHALL HAVE FLEXIBLE SPIGOT AND SOCKET JOINTS AND COMPLYING WITH BS EN 1916:2002 AND BS 5911-1:2002.
- FOR DETAILS OF FLEXIBLE JOINT, REFER TO DSD STD. DRG. NO. DS1050.
- FOR DETAILS OF BEDDING CLASS A AND CLASS B AND CONCRETE SURROUND, REFER TO DSD STD. DRG. NOS. DS1048 AND DS1049.
- ALL GULLY CONNECTION PIPE SHALL BE 150 DIAMETER CONCRETE UNLESS OTHERWISE SPECIFIED.
- GULLY SHALL BE UNTRAPPED TYPE WITH COMPOUND MATERIALS GRATING GA1-450 AND KERB OVERFLOW WEIRS TYPE K1-450V IN ACCORDANCE WITH HyD STD. DRG NOS. H3109A, H3123M H3152 AND H3153.
- STEP IRON SHALL BE PROVIDED FOR DRAINPIT WITH INTERNAL BOTTOM LEVEL TO GROUND LEVEL GREATER THAN 1m.
- THE EXACT EXTENT OF PIPES./MANHOLES ABANDONMENT SHALL BE INVESTIGATED AND VERIFIED AND APPROVED BY THE SUPERVISING OFFICER ON SITE. OTHER EXISTING PIPES/MANHOLES SHALL BE MAINTAINED UNLESS INSTRUCTED BY THE SUPERVISING OFFICER.
- MINIMUM COVER TO PIPE SHALL BE PROVIDED AS FOLLOWS UNLESS OTHERWISE SPECIFIED:
1.2m IN ROAD, FOOTWAYS OR VERGES;
0.9m IN OTHER AREAS
- FOR DETAILS OF CATCHPIT, REFER TO CEDD STD. DRG. NO. C2405 AND C2407.
- MANHOLE COVERS WITHIN CARRIAGEWAY AND VEHICLE ACCESS ROAD ARE HEAVY DUTY FOR TRAFFIC LOADING TO CLS.28 OF THE CONSTRUCTION SPECIFICATION AND G.S.C1.5.28.
- MANHOLE IDENTIFICATION TAGS AS SHOWN ON DSD STD. DRG. NO. DS1075 SHALL BE PROVIDED TO MANHOLES.
- ALL PRECAST CONCRETE PIPES SHALL BE CLASS 120 UNIT TO BS 5911-1, UNLESS OTHERWISE STATED.
- IDENTIFICATION TAPE AND MARKER POSTS SHALL BE PROVIDED TO ALL UTILITIES IN ACCORDANCE WITH THE SPECIFICATION.
- THE MATERIAL OF THE DIVERTED SEWERAGE PIPE SHALL BE PRECAST CONCRETE PIPES.

ABBREVIATION

CU	COVERED U-CHANNEL
UC	U-CHANNEL
SMH01	STORMWATER MANHOLE 01
FMH01	FOULWATER MANHOLE 01
CP01	CATCHPIT 01
I.L.	INVERT LEVEL
C.L.	COVER LEVEL/GROUND LEVEL
D.I.	DUCTILE IRON
STG	SEALED TRAP GULLY
DTG	OPEN TRAP GULLY
V.P.	VENT PIPE
C.I.	CAST IRON
STD.	STANDARD
DRG.	DRAWING
A	CLASS A BEDDING
B	CLASS B BEDDING
H	PRECAST CONCRETE PIPS AND FITTING C CLASS HIGH
	STANGTH SHALL COMPLY WITH BS 5911
GS	GENERAL SPECIFICATION PUBLISHED BY CEDD
US	UPSTREAM
DS	DOWNSTREAM
RM	RISING MAIN
HyD	HIGHWAY DEPARTMENT
DSD	DRAINAGE SERVICES DEPARTMENT
CEDD	CIVIL ENGINEERING DEVELOPMENT DEPARTMENT
Ex	VITRIFIED CLAY PIPES AND FITTINGS (CLASS 120) SHALL COMPLY WITH EN 295

As-built Drawing

Prepared by the Contractor "DCVJV"

23SEP2019
Mr. W.K.Poon
(Project Director)
Date

Checked by the Designer "Mott MacDonald"

23SEP2019
Dr. H.T.Cheng
(Designer)
Date

Endorsed by the Design Checker "AECOM"

23SEP2019
Mr. Charles Luk
(Design Checker)
Date

Main Contractor



Contractor's Designer



Consultant




Project Title
Contract No. HY/2011/09
Hong Kong - Zhuhai - Macao Bridge
Hong Kong Link Road
Section Between HKSAR Boundary
and Scenic Hill

GENERAL NOTES FOR DRAINAGE


Drawing No.					Rev.	
HKLR9/MMH/AB/PW/DN/00000					-	
Design	AL	Drawn	PL	Approved	HTC	Status
Scale	N.T.S.			Approved		AS-BUILT
Doc No.	HKLR9			Sheet No.	1 OF 1	
File name	HKLR9_MMH_AB_PW_DN_00000.dgn					
COPYRIGHT RESERVED						



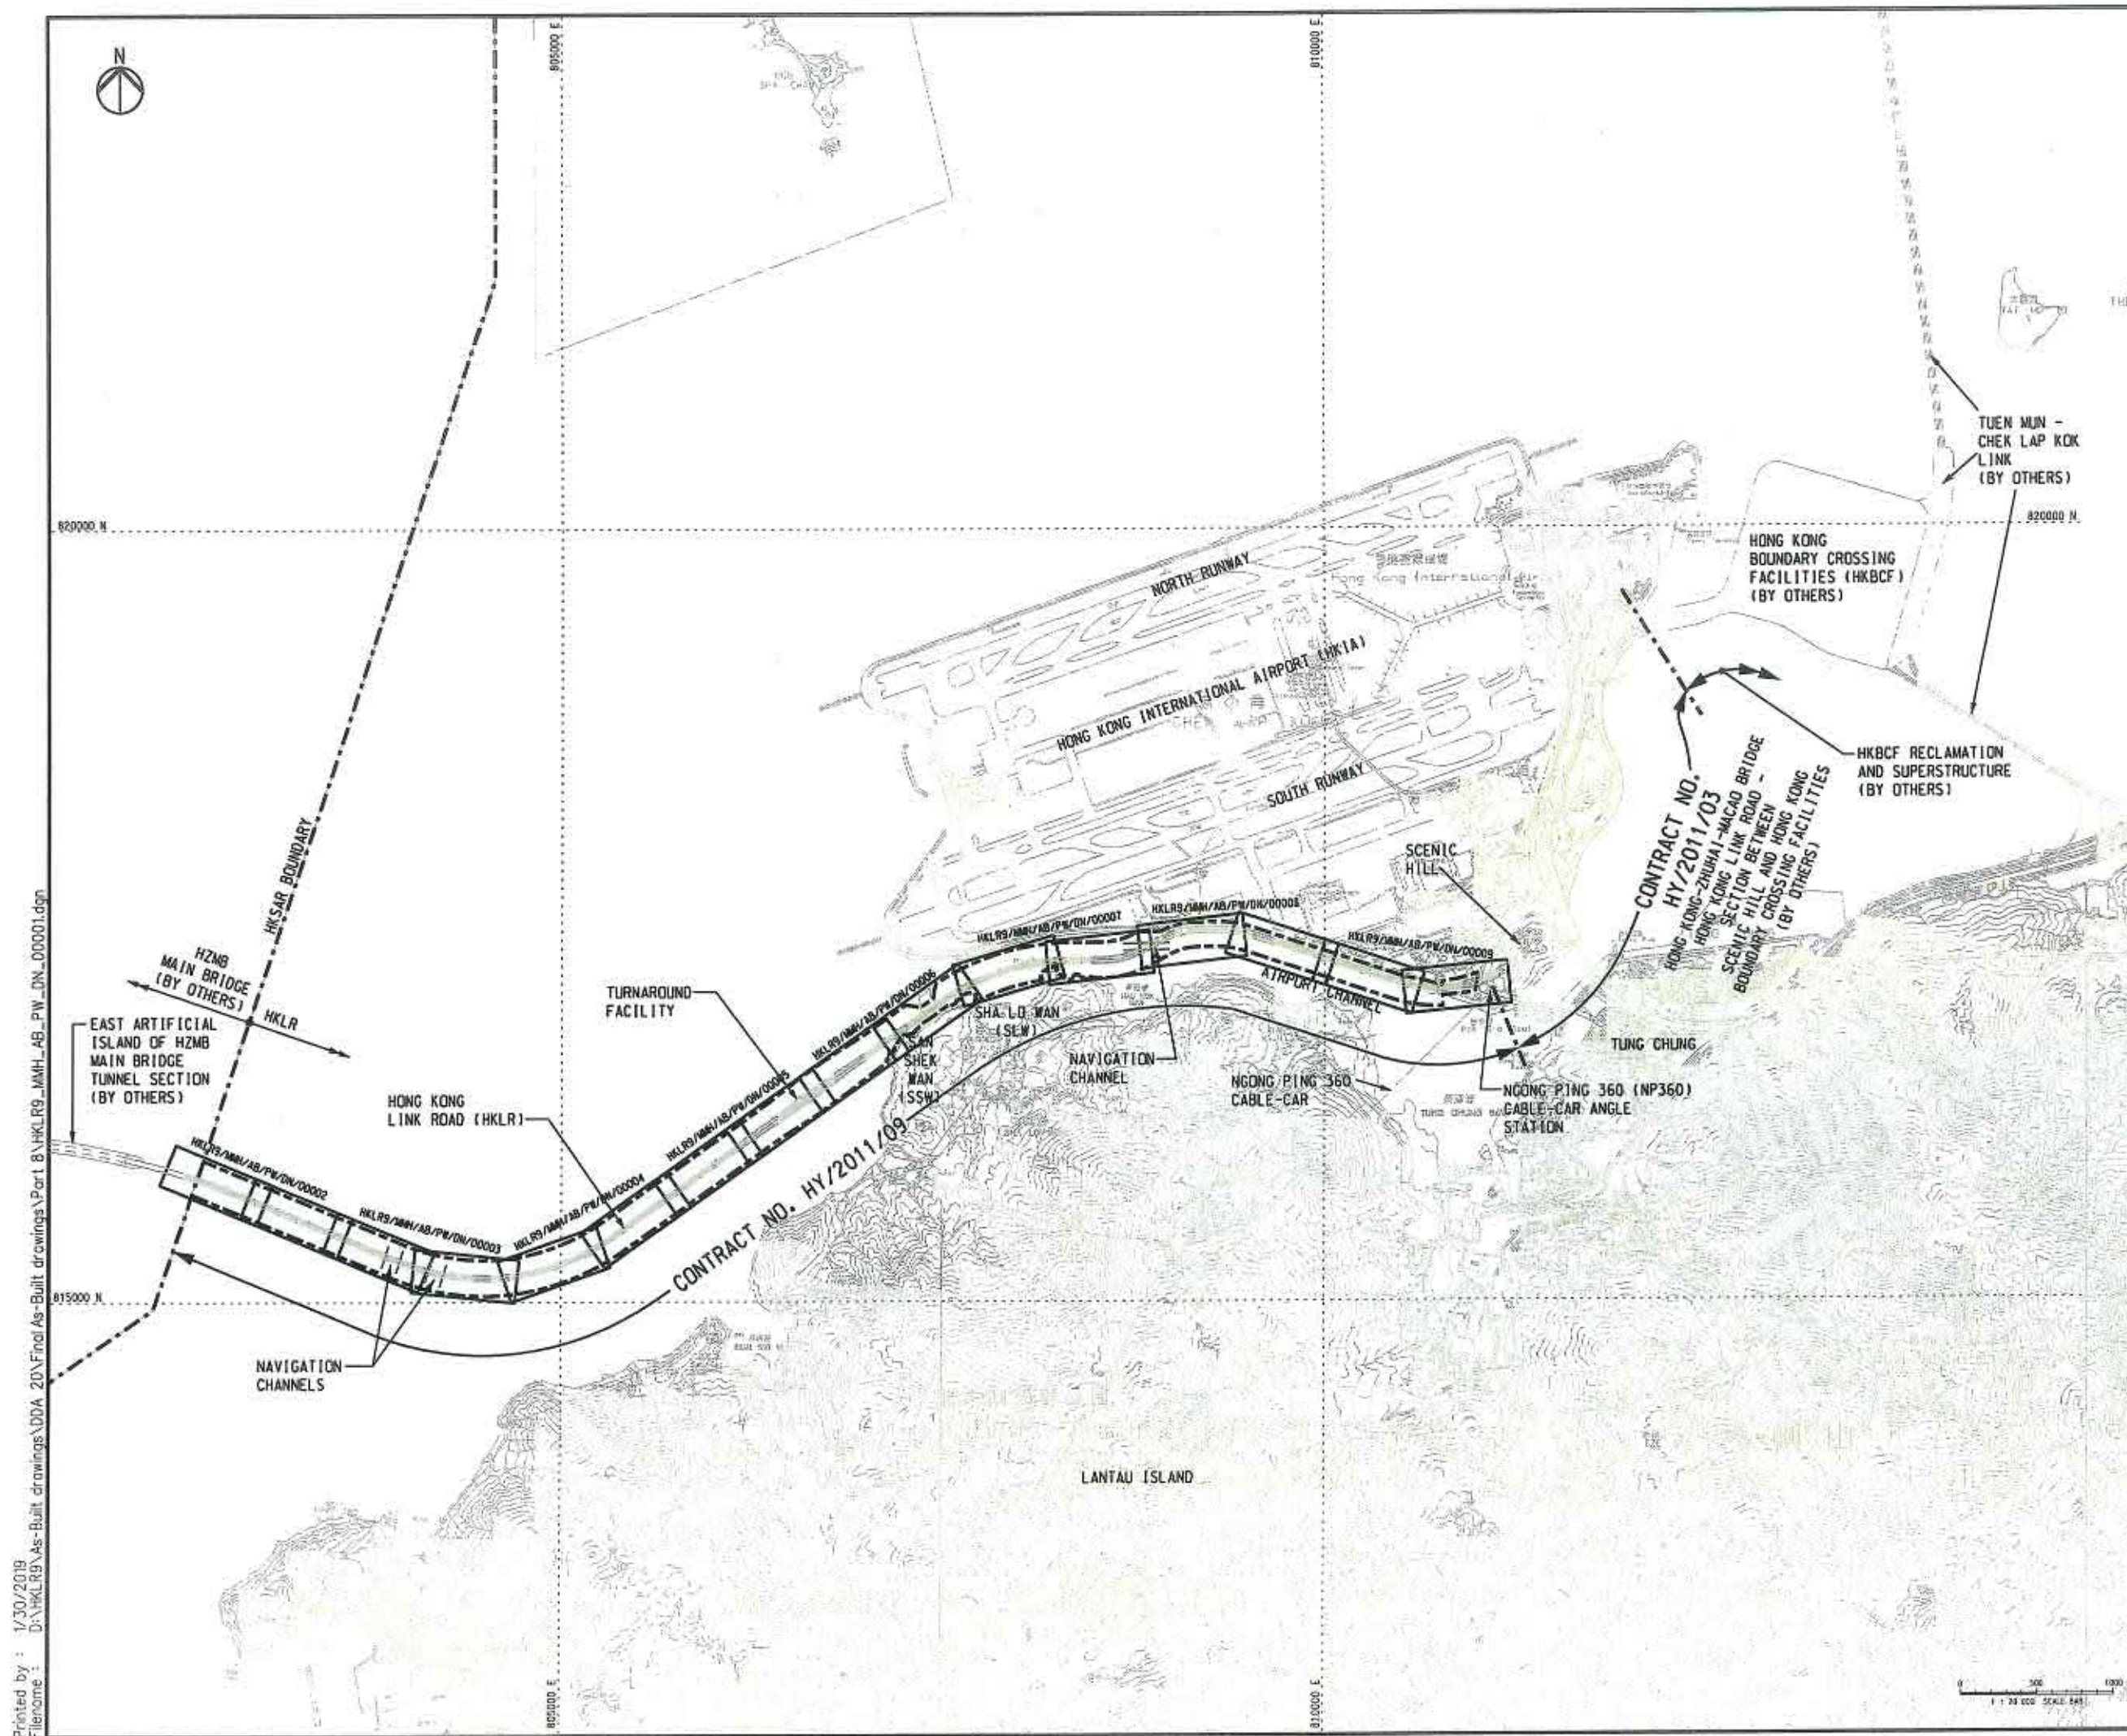

Printed by : 1/30/2019
Filename : D:\HKL R9\As-Built drawings\Part 8\HKL R9_MMH_AB_PW_DN_00001.dgn

THE UNIVERSITY OF THE CHURCH OF ENGLAND IN THIS DRAWING IS RETAINED BY THE ISSUER WHOSE CONSENT MUST BE OBTAINED BEFORE ANY USE OR REPRODUCTION OF THE DRAWING OR ANY PART THEREOF CAN BE MADE.

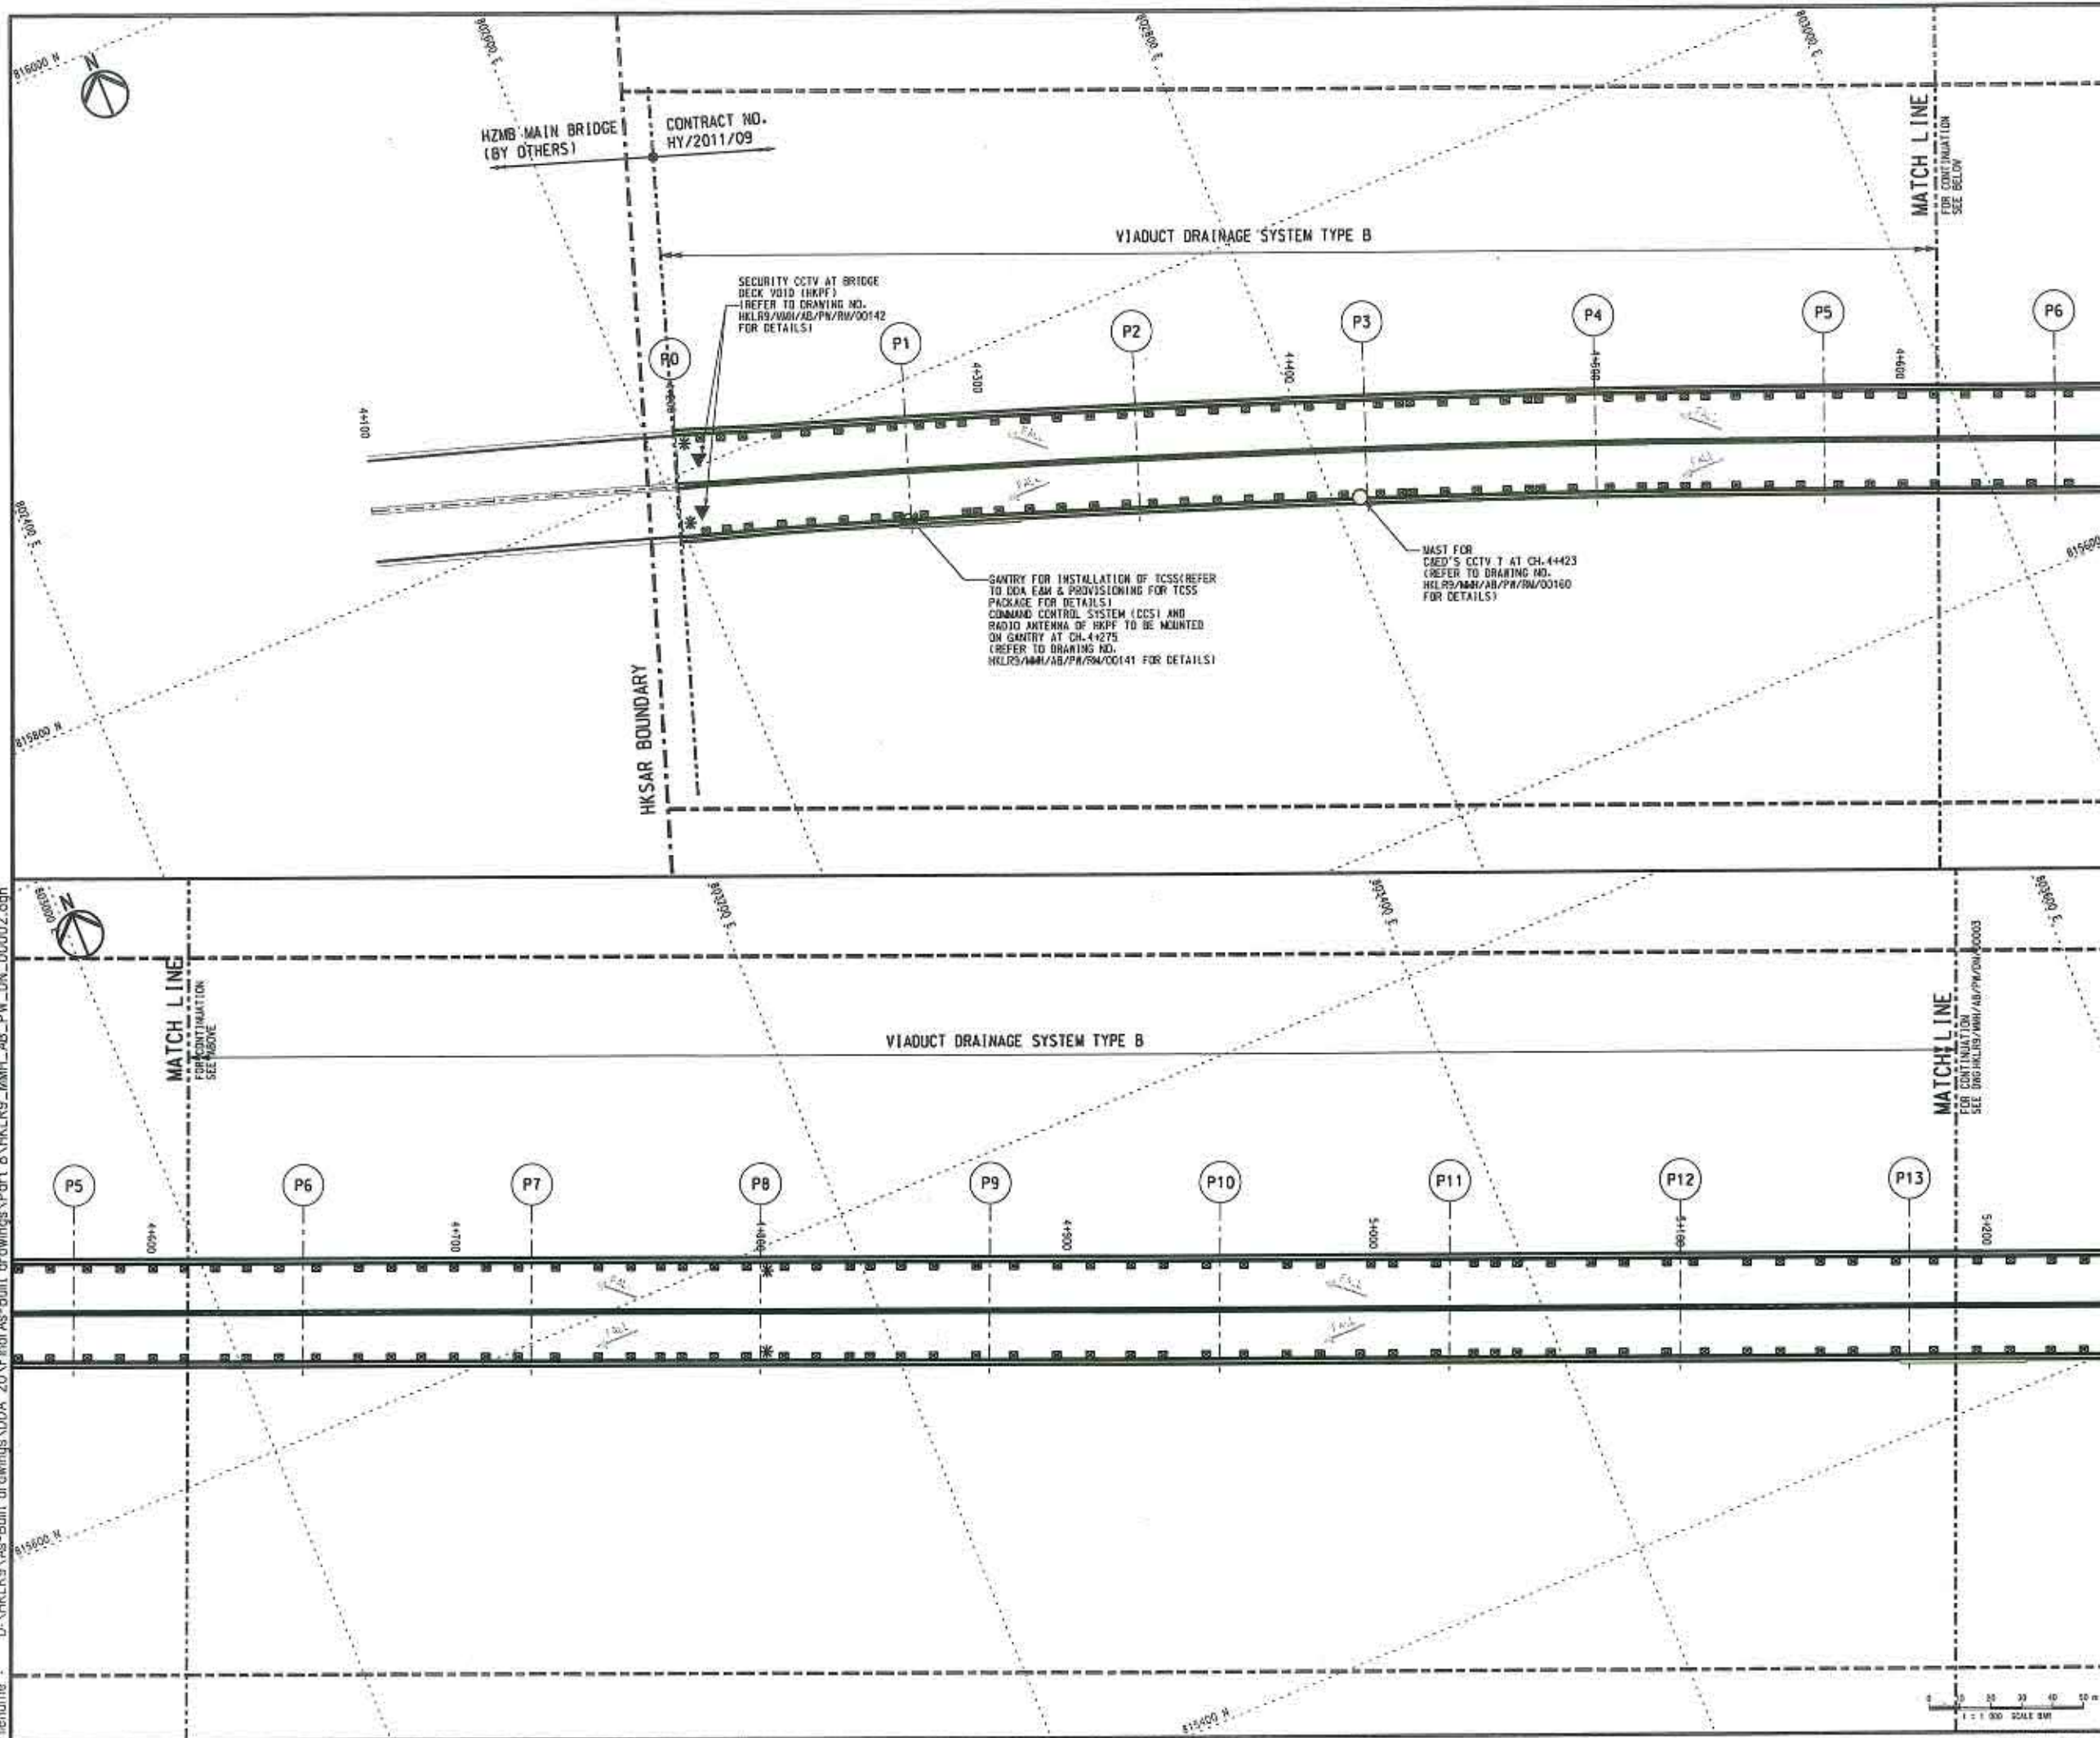

NOTES

- THIS SET OF DRAWINGS SHALL BE READ IN CONJUNCTION WITH THE KEY PLAN DRG. NO. HKLRS/MMH/AB/PW/DN/00001.
- FOR GENERAL NOTES, PLEASE REFER TO DRG. NO. HKLRS/MMH/AB/PW/DN/00000.

As-built Drawing

Prepared by the Contractor "DCV JV"

Mr. W.K. Poon
 (Project Director)
 Date 11/01/19
 Checked by the Designer "Mott MacDonald"
 Dr. H.T. Cheng
 (Designer)
 Date 11/01/19
 Endorsed by the Design Checker "AECOM"
 Mr. Charles Luk
 (Design Checker)
 Date 11/01/19




Contract No. HY/2011/09
 Hong Kong - Zhuhai - Macao Bridge
 Hong Kong Link Road
 Section Between HKSAR Boundary and Scenic Hill

VIADUCT DRAINAGE SYSTEM LAYOUT

Design No.	HKLRS/MMH/AB/PW/DN/00002			
Design	AL	PL	HTC	AS-BUILT
Scale	1:1000 (IN A1)			
Drawn by	HKLRS			
Check by	1 OF 8			
File Name	HKLRS_MMH_AB_PW_DN_00002.dgn			



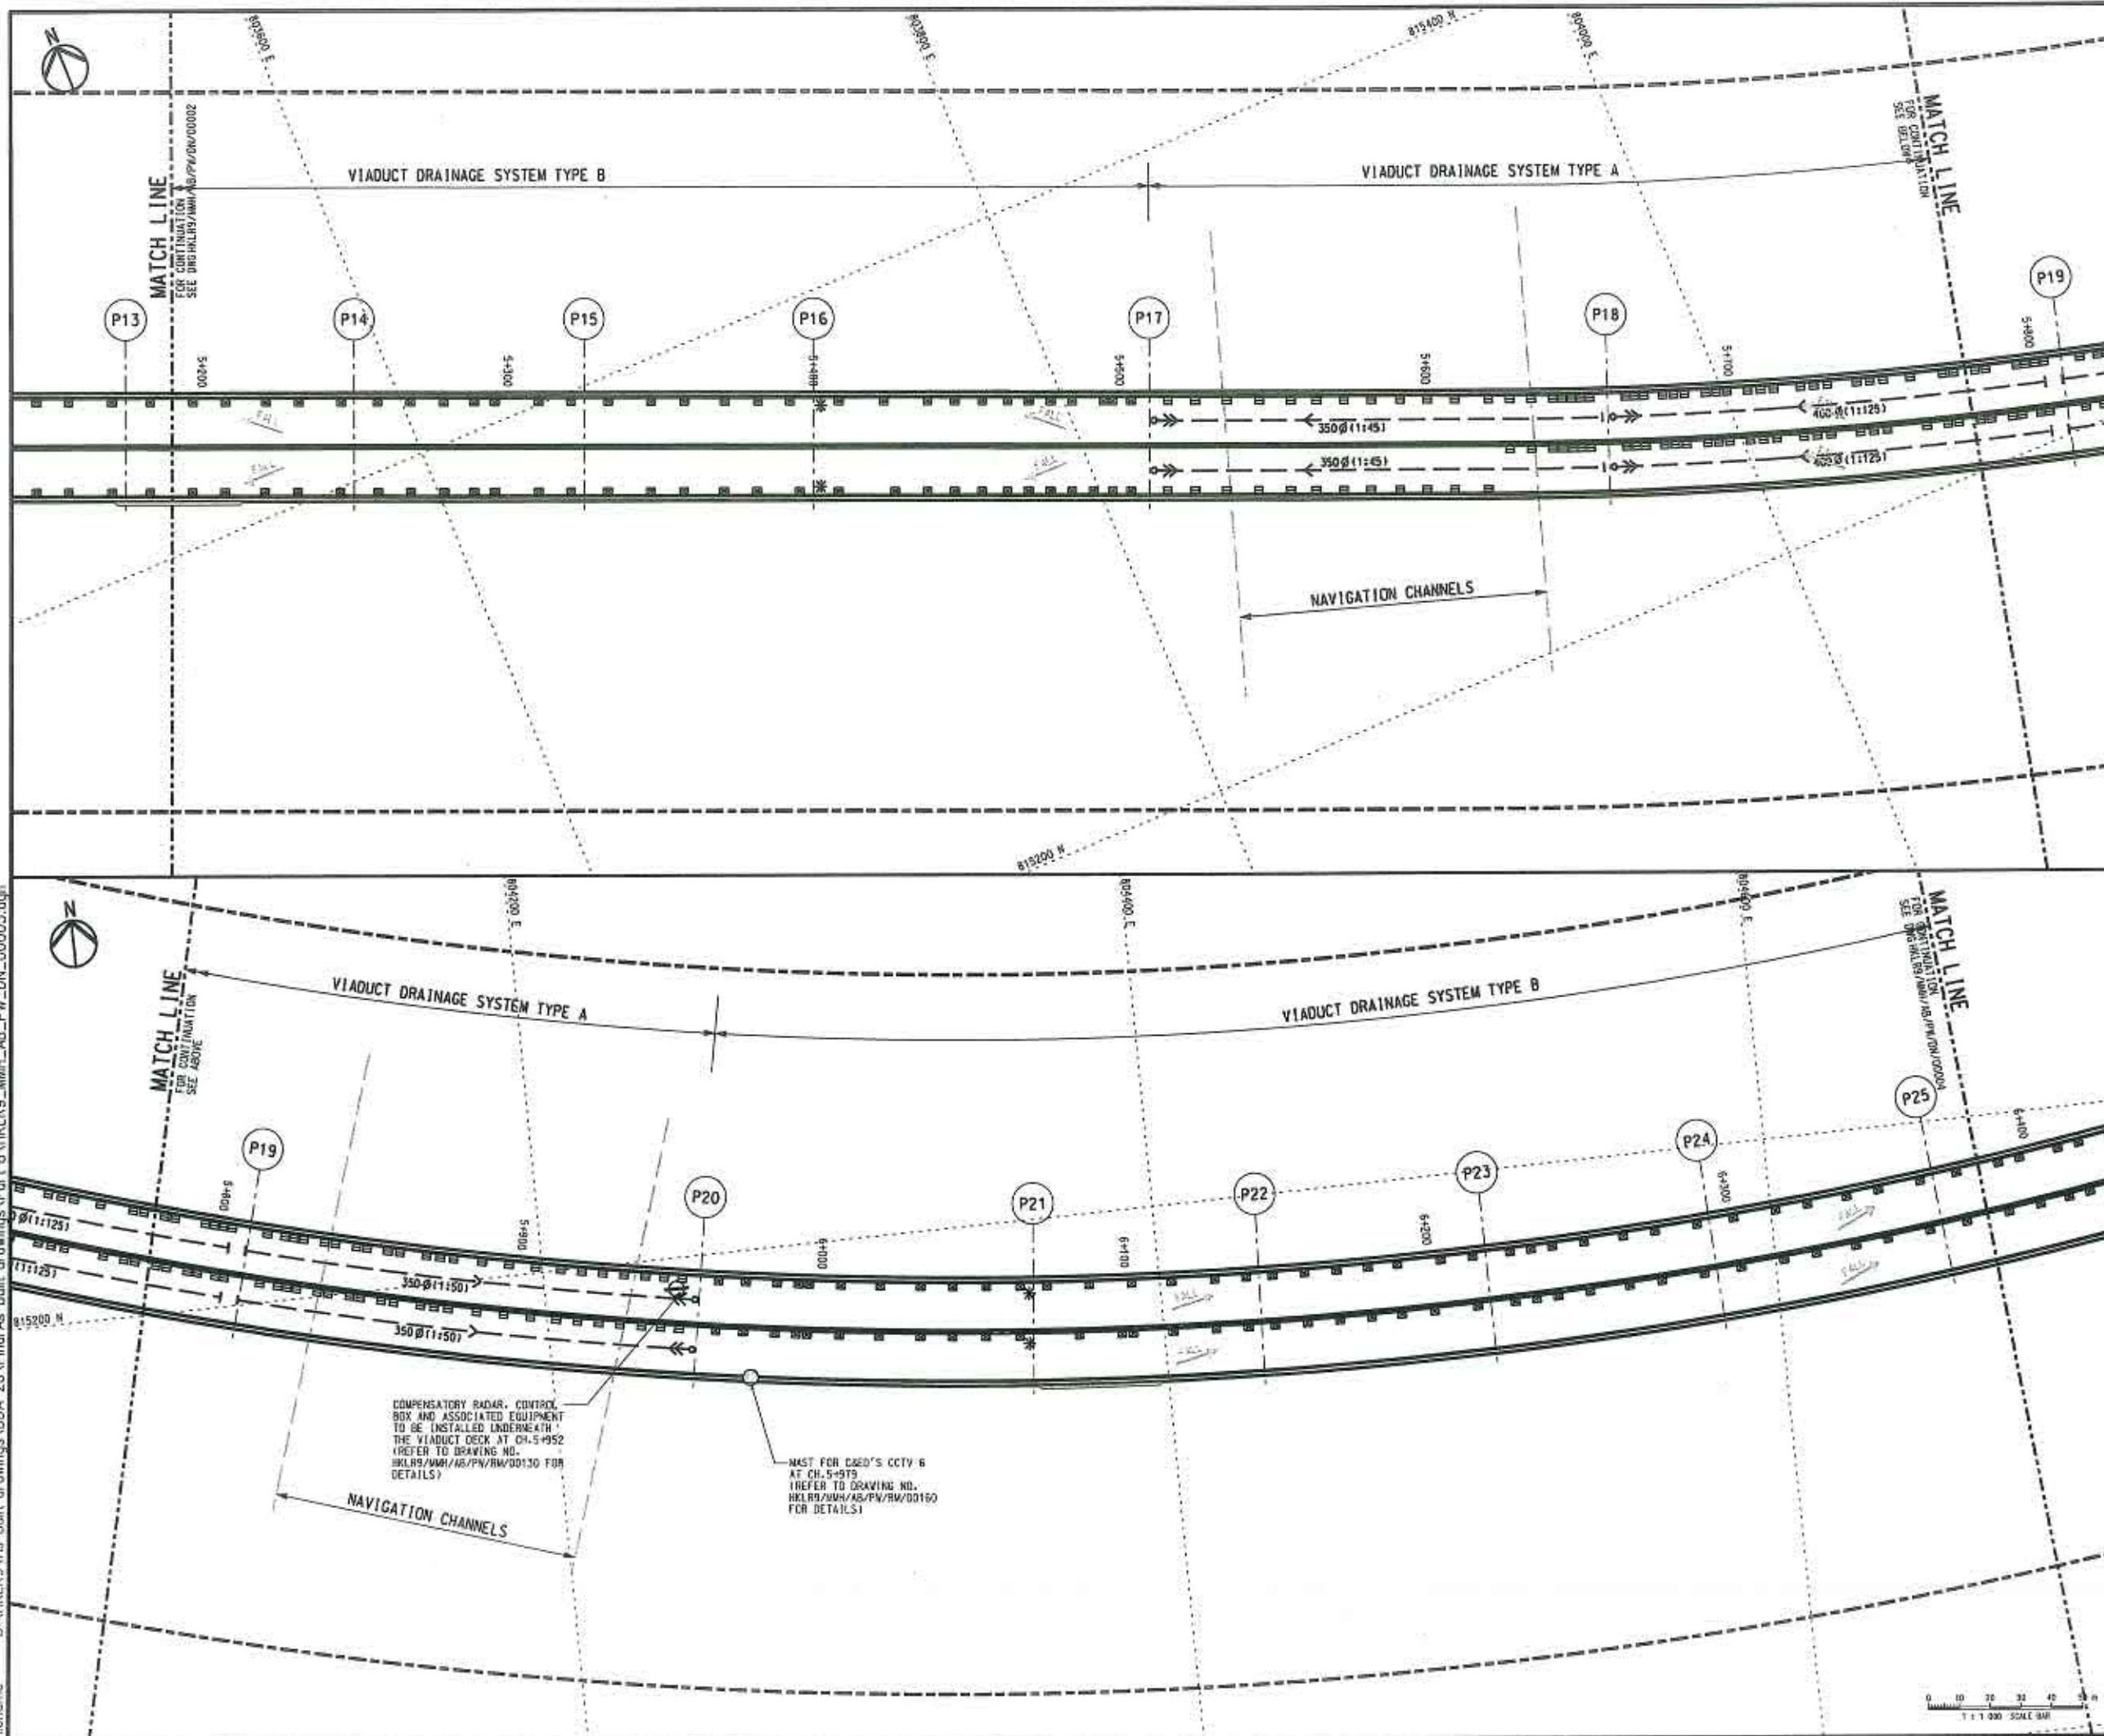

NOTES

- FOR NOTES AND LEGEND, REFER TO DRG. NO. HKLR9/MMH/AB/PW/DN/00000.

As-built Drawing

Prepared by the Contractor "DCV JV"

Mr. W.K. Poon
 (Project Director)
 Date: 11/01/19

Checked by the Designer "Mott MacDonald"

Dr. H.T. Cheng
 (Designer)
 Date: 11/01/19

Endorsed by the Design Checker "AECOM"

Mr. Charles Luk
 (Design Checker)
 Date: 11/01/19



Contract No. HY/2011/09
 Hong Kong - Zhuhai - Macao Bridge
 Hong Kong Link Road
 Section Between HKSAR Boundary and Scenic Hill

VIADUCT DRAINAGE SYSTEM LAYOUT


Project No. HKLR9/MMH/AB/PW/DN/00003

Scale: 1:1000 (IN A1)

Sheet No. 2 OF 8

File Name: HKLR9_MMH_AB_PW_DN_00003.dgn



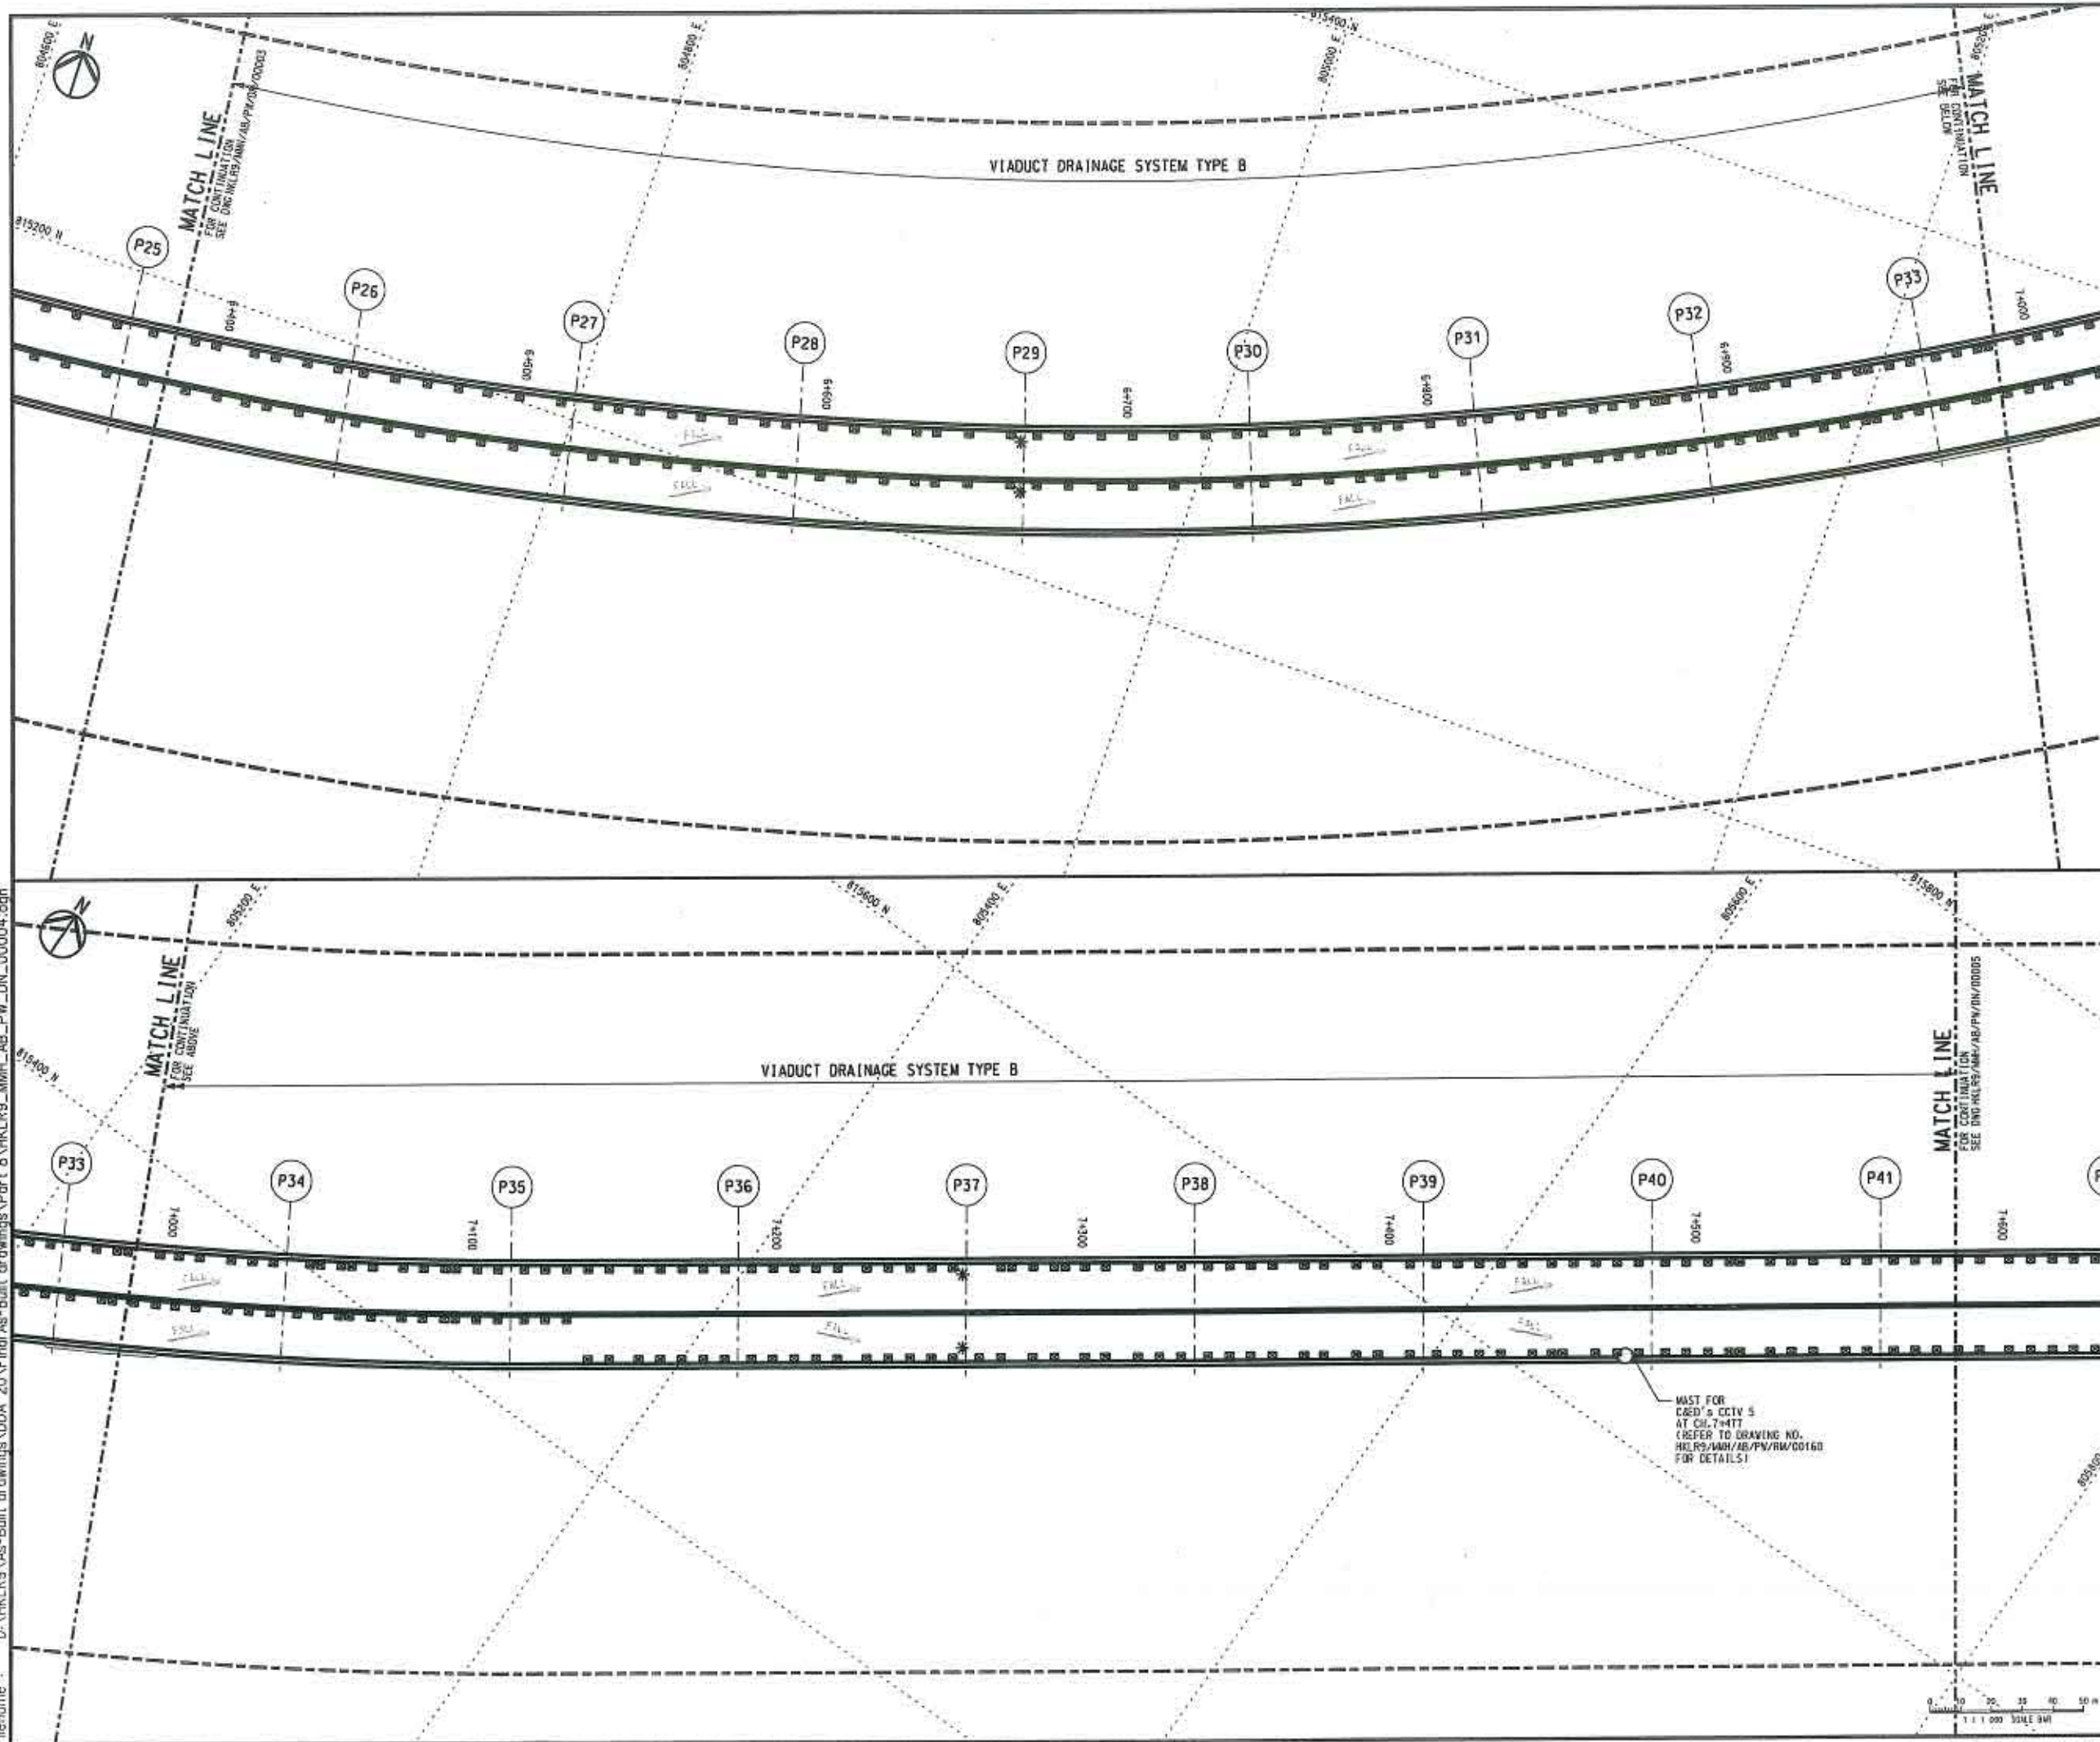

NOTES

1. FOR NOTES AND LEGEND, REFER TO DRG. NO. HKLR9/MMH/AB/PW/DN/00000.

As-built Drawing

Prepared by the Contractor "DCV JV"

Mr. W.K. Boon
 (Project Director)
 Date: 11/01/19

Checked by the Designer "Mott MacDonald"

Dr. H.T. Cheng
 (Designer)
 Date: 11/01/19

Endorsed by the Design Checker "AECOM"


Mr. Charles Luk
 (Design Checker)
 Date: 11/01/19



Contractor's Designer



Contractor

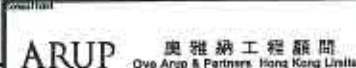

Contract No. HY/2011/09

Hong Kong - Zhuhai - Macao Bridge
 Hong Kong Link Road
 Section Between HKSAR Boundary and Scenic Hill

VIADUCT DRAINAGE SYSTEM LAYOUT

Drawing No. HKLR9/MMH/AB/PW/DN/00004

Design: AL, PL, HTC, AS-BUILT

Scale: 1:1000 (IN A1)


CD No. HKLR9, Sheet No. 3 OF 8

File Name: HKLR9-MMH-AB-PW-DN-00004.dgn

COPYRIGHT RESERVED

路政署

HIGHWAYS DEPARTMENT

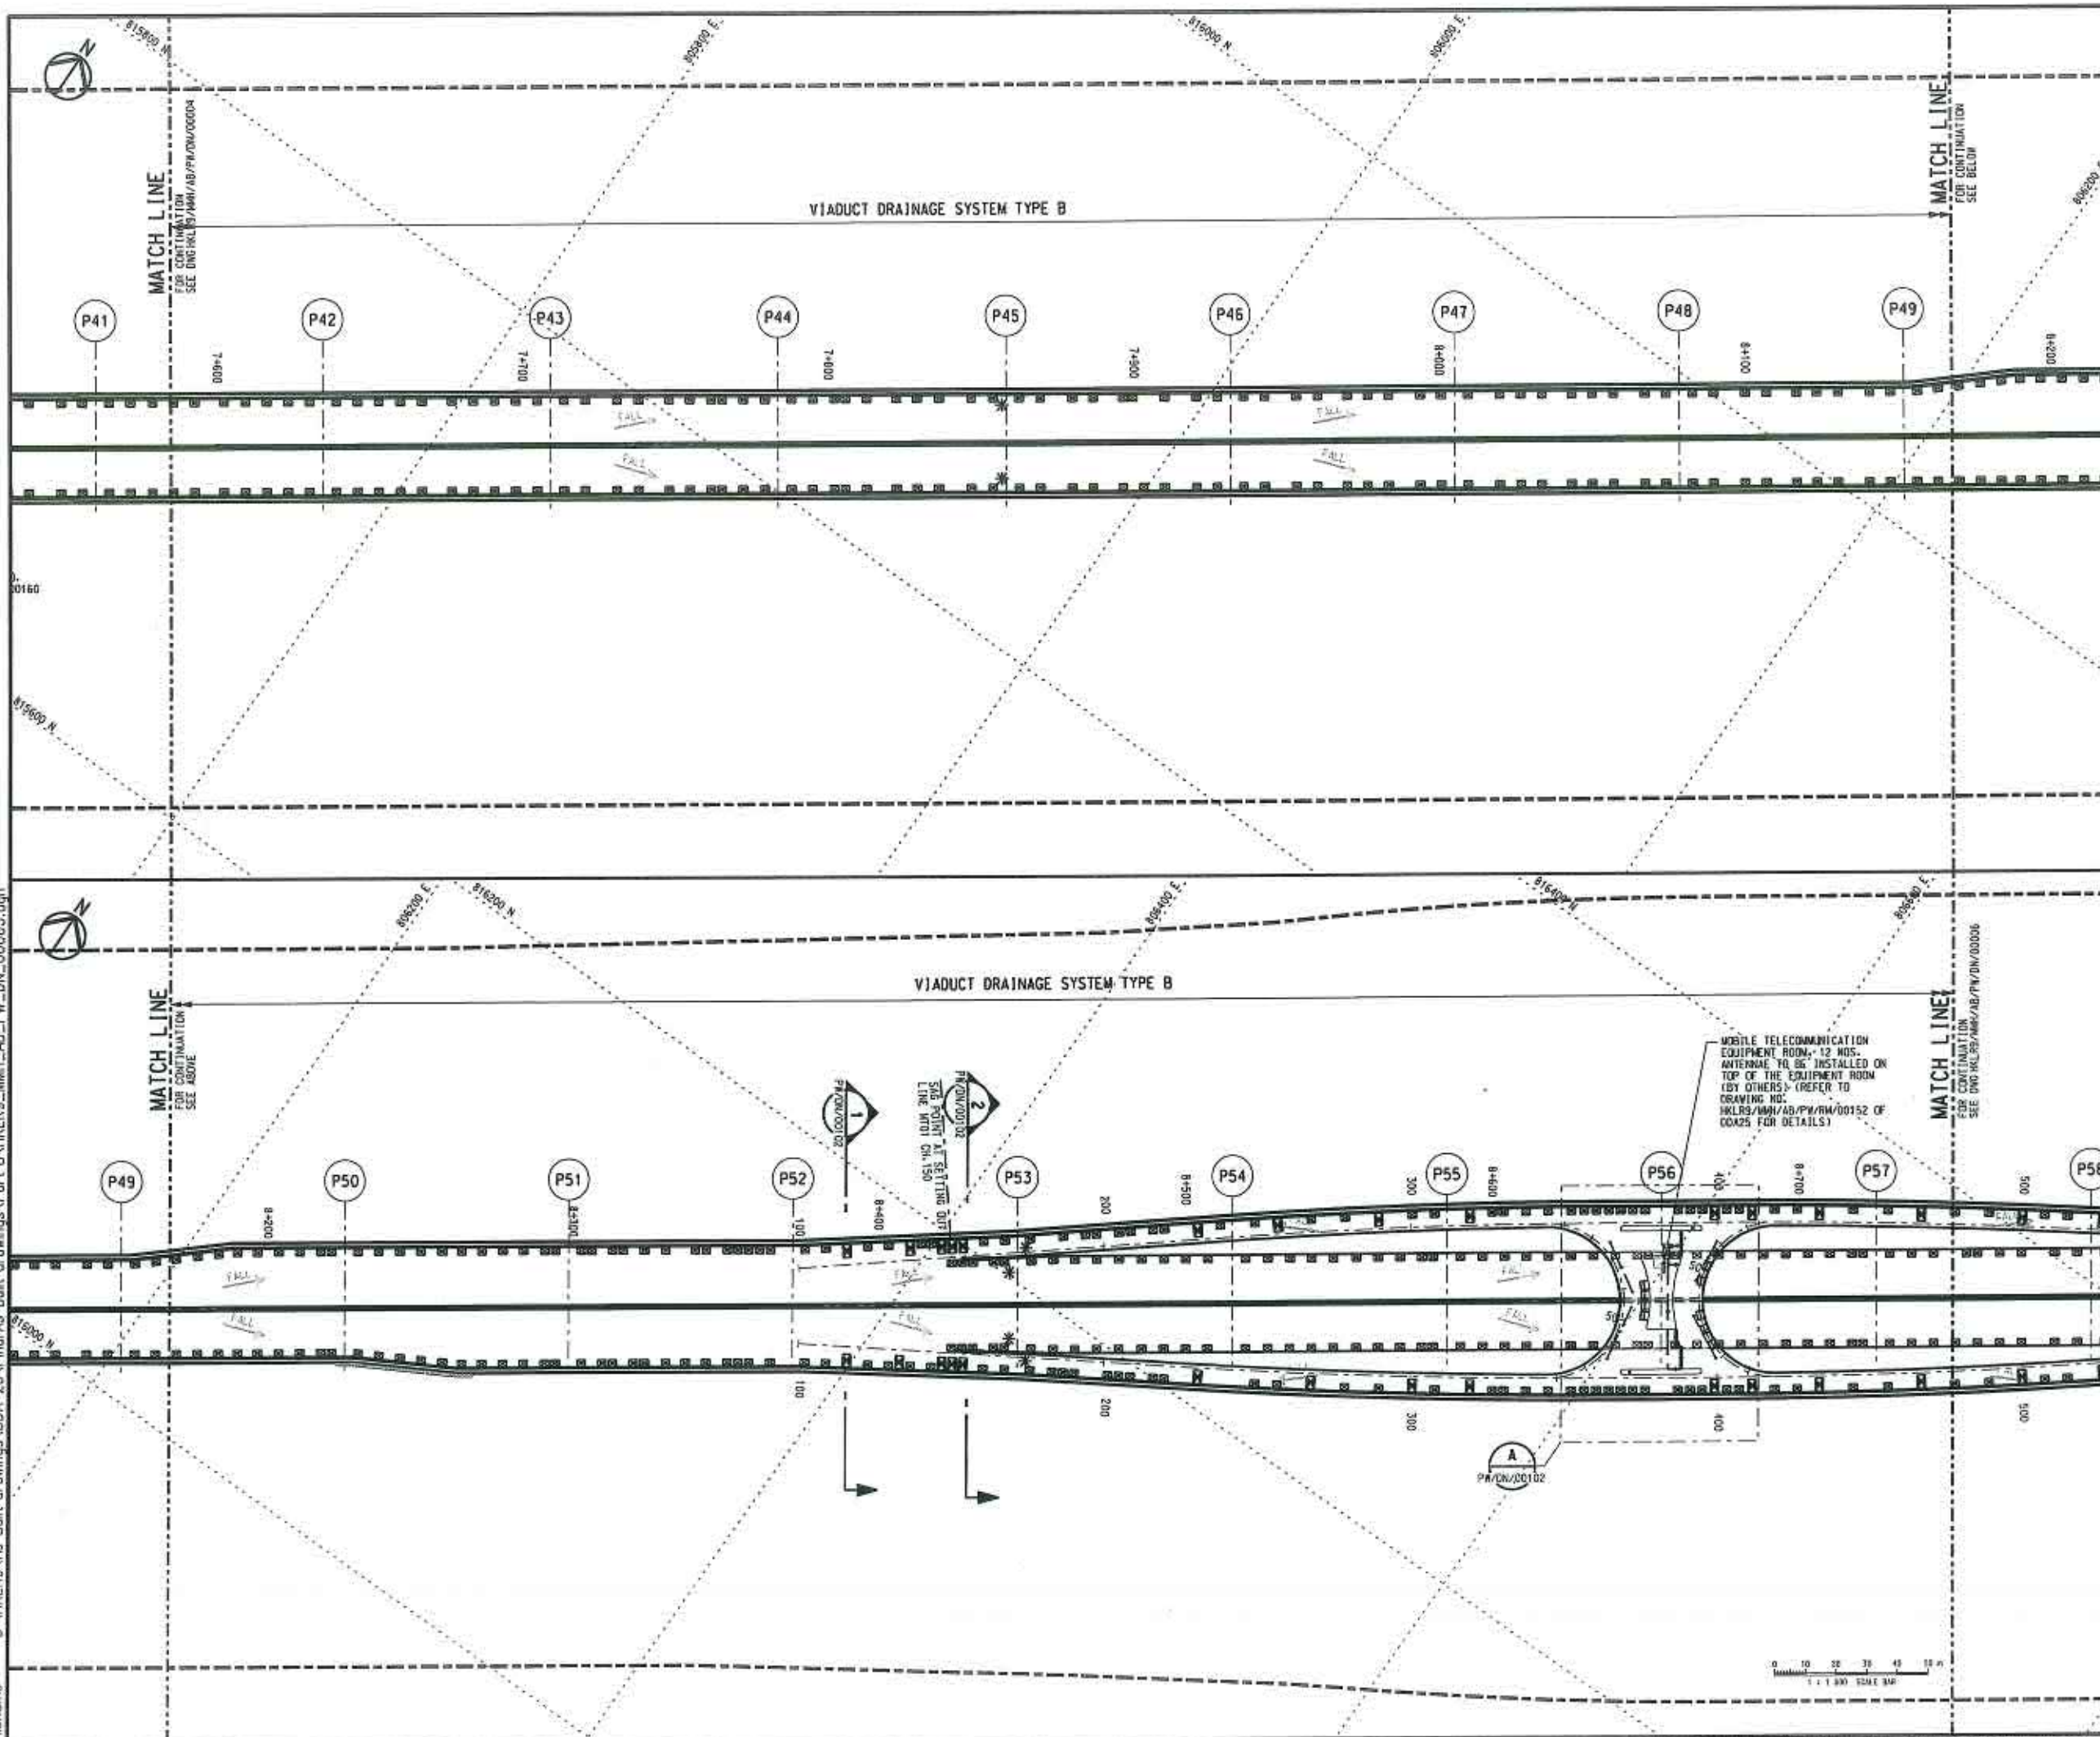

NOTES

1. FOR NOTES AND LEGEND, REFER TO DRG. NO. HKLR9/MMH/AB/PW/DN/00000.

As-built Drawing

Prepared by the Contractor "DCVJV"

Mr. W.K. Poon
 (Project Director)
 Date: 11/01/19

Checked by the Designer "Mott MacDonald"

Dr. H.T. Cheng
 (Designer)
 Date: 11/01/19

Endorsed by the Design Checker "AECOM"

Mr. Charles Luk
 (Design Checker)
 Date: 11/01/19



Diagrams - China Harbour - VSL Joint Venture 測量-中國港務-威達利聯合

Contract No. HY/2011/09

Mott MacDonald YWL Engineering

ARUP 奧雅納工程顧問

Contract No. HY/2011/09
 Hong Kong - Zhuhai - Macao Bridge
 Hong Kong Link Road
 Section Between HK SAR Boundary and Scenic Hill

VIADUCT DRAINAGE SYSTEM LAYOUT

Drawing No. HKLR9/MMH/AB/PW/DN/00005


Scale: 1:1000 (1 IN A1)

Sheet No. HKLR9 4 OF 8

File Name: HKLR9-MMH-AB-PW-DN_00005.dgn

Copyright Reserved

路政署 HIGHWAYS DEPARTMENT

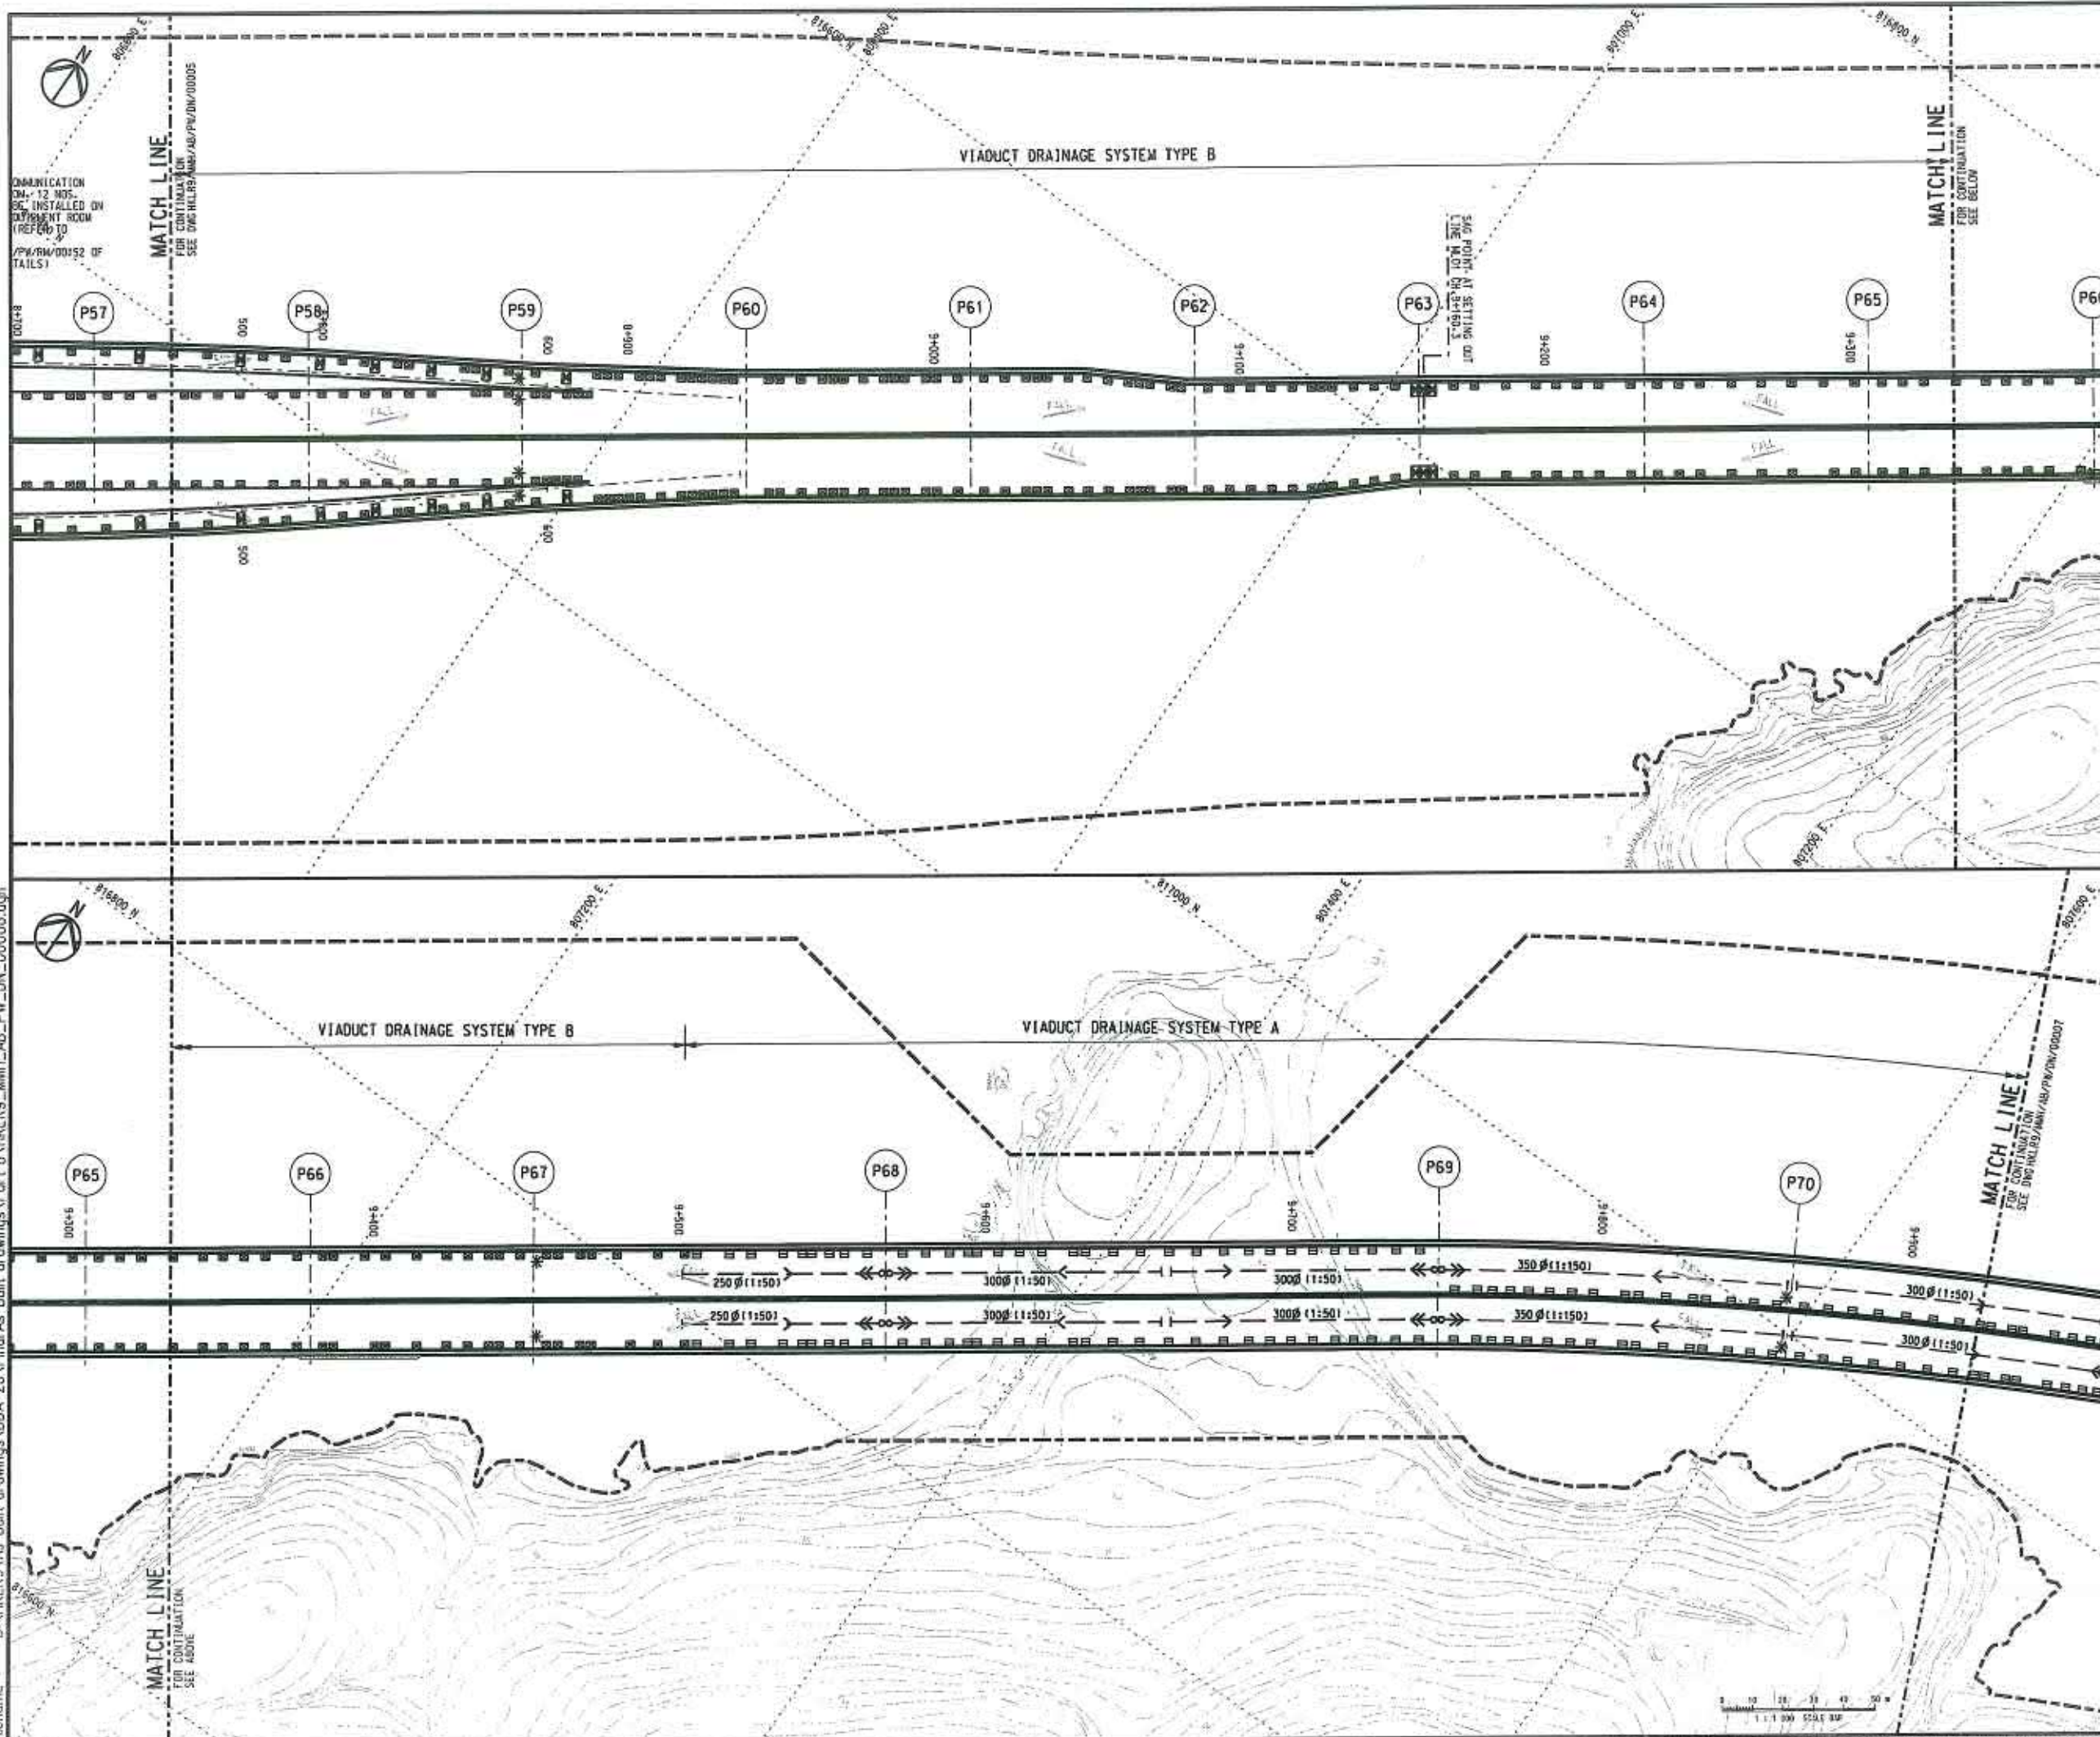

NOTES

1. FOR NOTES AND LEGEND, REFER TO DRC. NO. HKLR9/MNH/AB/PW/DN/00000.

As-built Drawing

Prepared by the Contractor "DCVJV"

Mr. W.K. Poon 11/01/19
 (Project Director) Date

Checked by the Designer "Mott MacDonald"
 Dr. H.T. Cheng 11/01/19
 (Designer) Date

Endorsed by the Design Checker "AECOM"
 Mr. Charles Luk 11/01/19
 (Design Checker) Date



Dragages - Grise Harbour - VSL Joint Venture 奥雅纳工程顾问
 Ove Arup & Partners Hong Kong Limited

Contractor: Mott MacDonald YWL Engineering


Contract: ARUP 奥雅纳工程顾问
 Ove Arup & Partners Hong Kong Limited

Contract No. HY/2011/09
 Hong Kong - Zhuhai - Macao Bridge
 Hong Kong Link Road
 Section Between HKSAR Boundary and Scenic Hill

VIADUCT DRAINAGE SYSTEM LAYOUT

Drawing No.	HKLR9/MNH/AB/PW/DN/00006	Rev.	-
Design	AL	PL	HTC
Scale	1:1000 (IN A1)	AS-BUILT	
Drawn By	HKLR9	Sheet No.	5 OF 8
File Name	HKLR9_MNH_AB_PW_DN_00006.dgn		
Copyright	RESERVED		

路政署
 HIGHWAYS DEPARTMENT

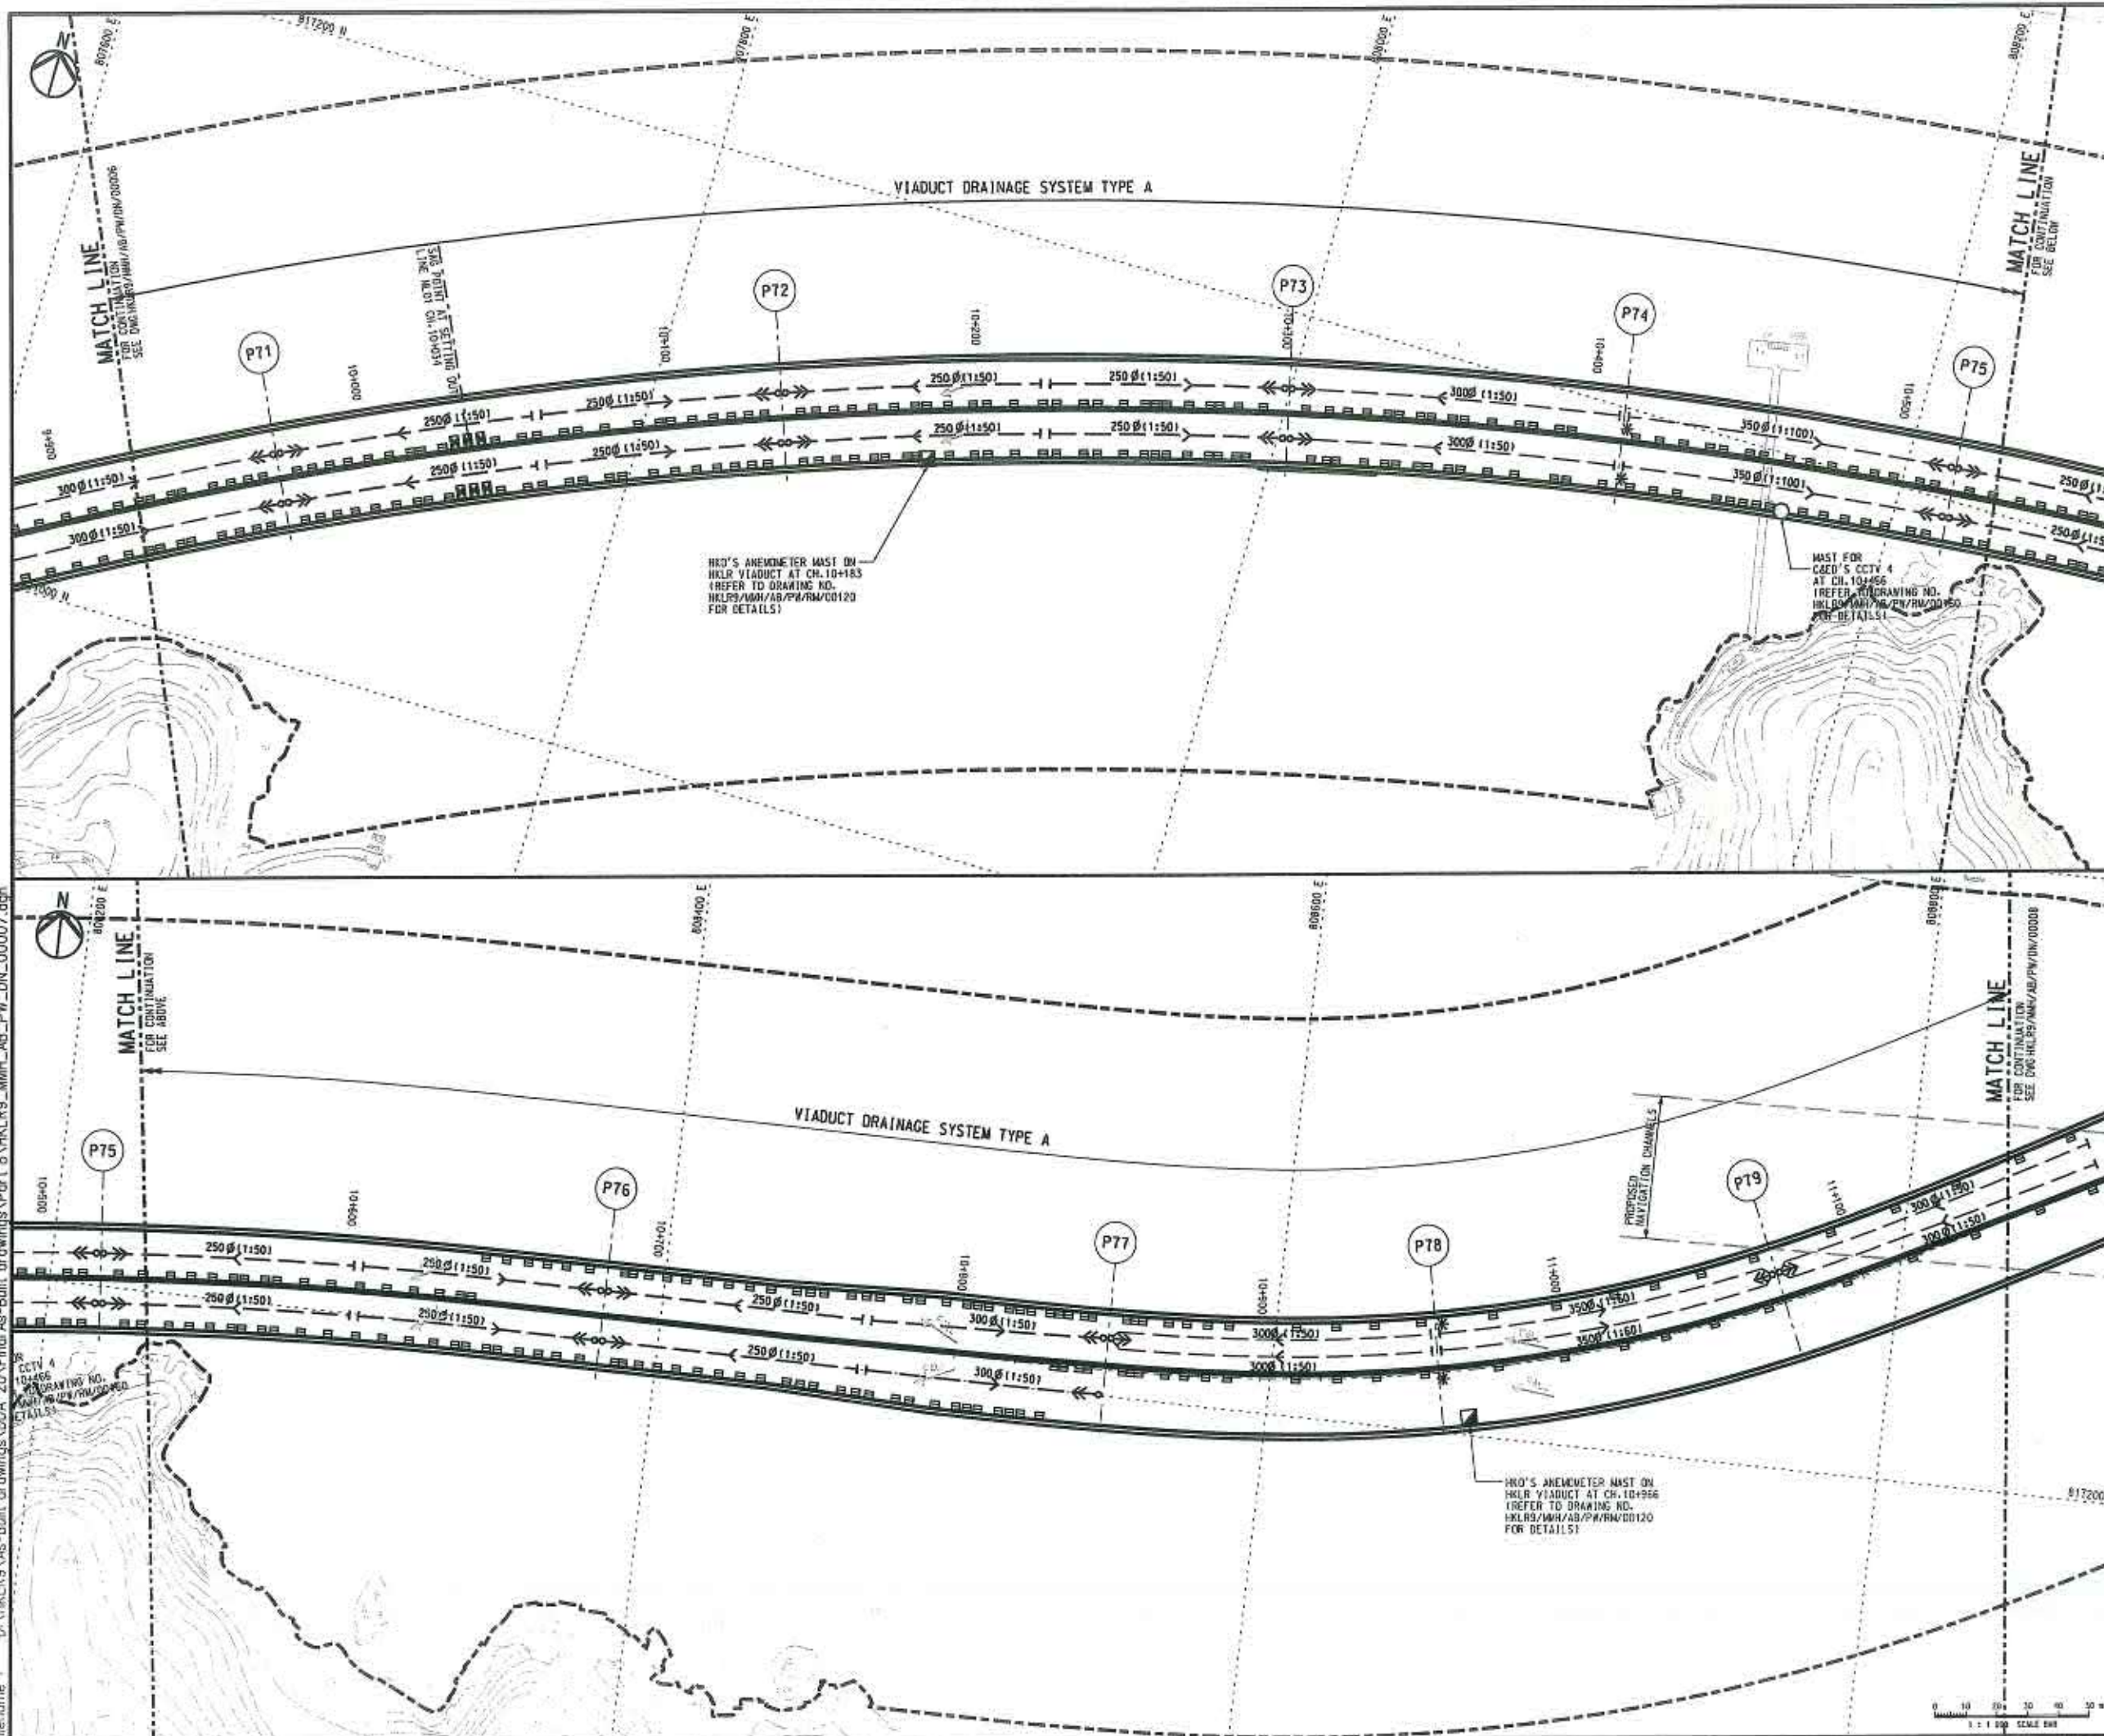

NOTES

1. FOR NOTES AND LEGEND, REFER TO DRG. NO. HKLR9/MMH/AB/PW/DN/00000.

As-built Drawing

Prepared by the Contractor "DCV JV"

Mr. V.K. Poon
 (Project Director)
 Date: 11/01/19

Checked by the Designer "Mott MacDonald"

Dr. H.T. Cheng
 (Designer)
 Date: 11/01/19

Endorsed by the Design Checker "AECOM"

Mr. Charles Luk
 (Design Checker)
 Date: 11/01/19




Contract No. HY/2011/09
 Hong Kong - Zhuhai - Macao Bridge
 Hong Kong Link Road
 Section Between HKSAR Boundary
 and Scenic Hill

VIADUCT DRAINAGE SYSTEM LAYOUT

Drawing No.					Rev.	
HKL9/MMH/AB/PW/DN/00007					-	
Design	AL	Drawn	PL	Approved	HTC	Project
Scale	1:1000 (IN A1)			Approved	-	AS-Built
Proj. No.	HKL9			Sheet No.	6 OF 8	
File Name	HKL9_MMH_AB_PW_DN_00007.dgn					
COPYRIGHT RESERVED						



Printed by : 6/4/2019
Filename : D:\HKLR9 As-Built drawings\DDA 20\Final As-Built drawings\Part 8\HKLR9_MMH_AB_PW_DN_00008.dgn

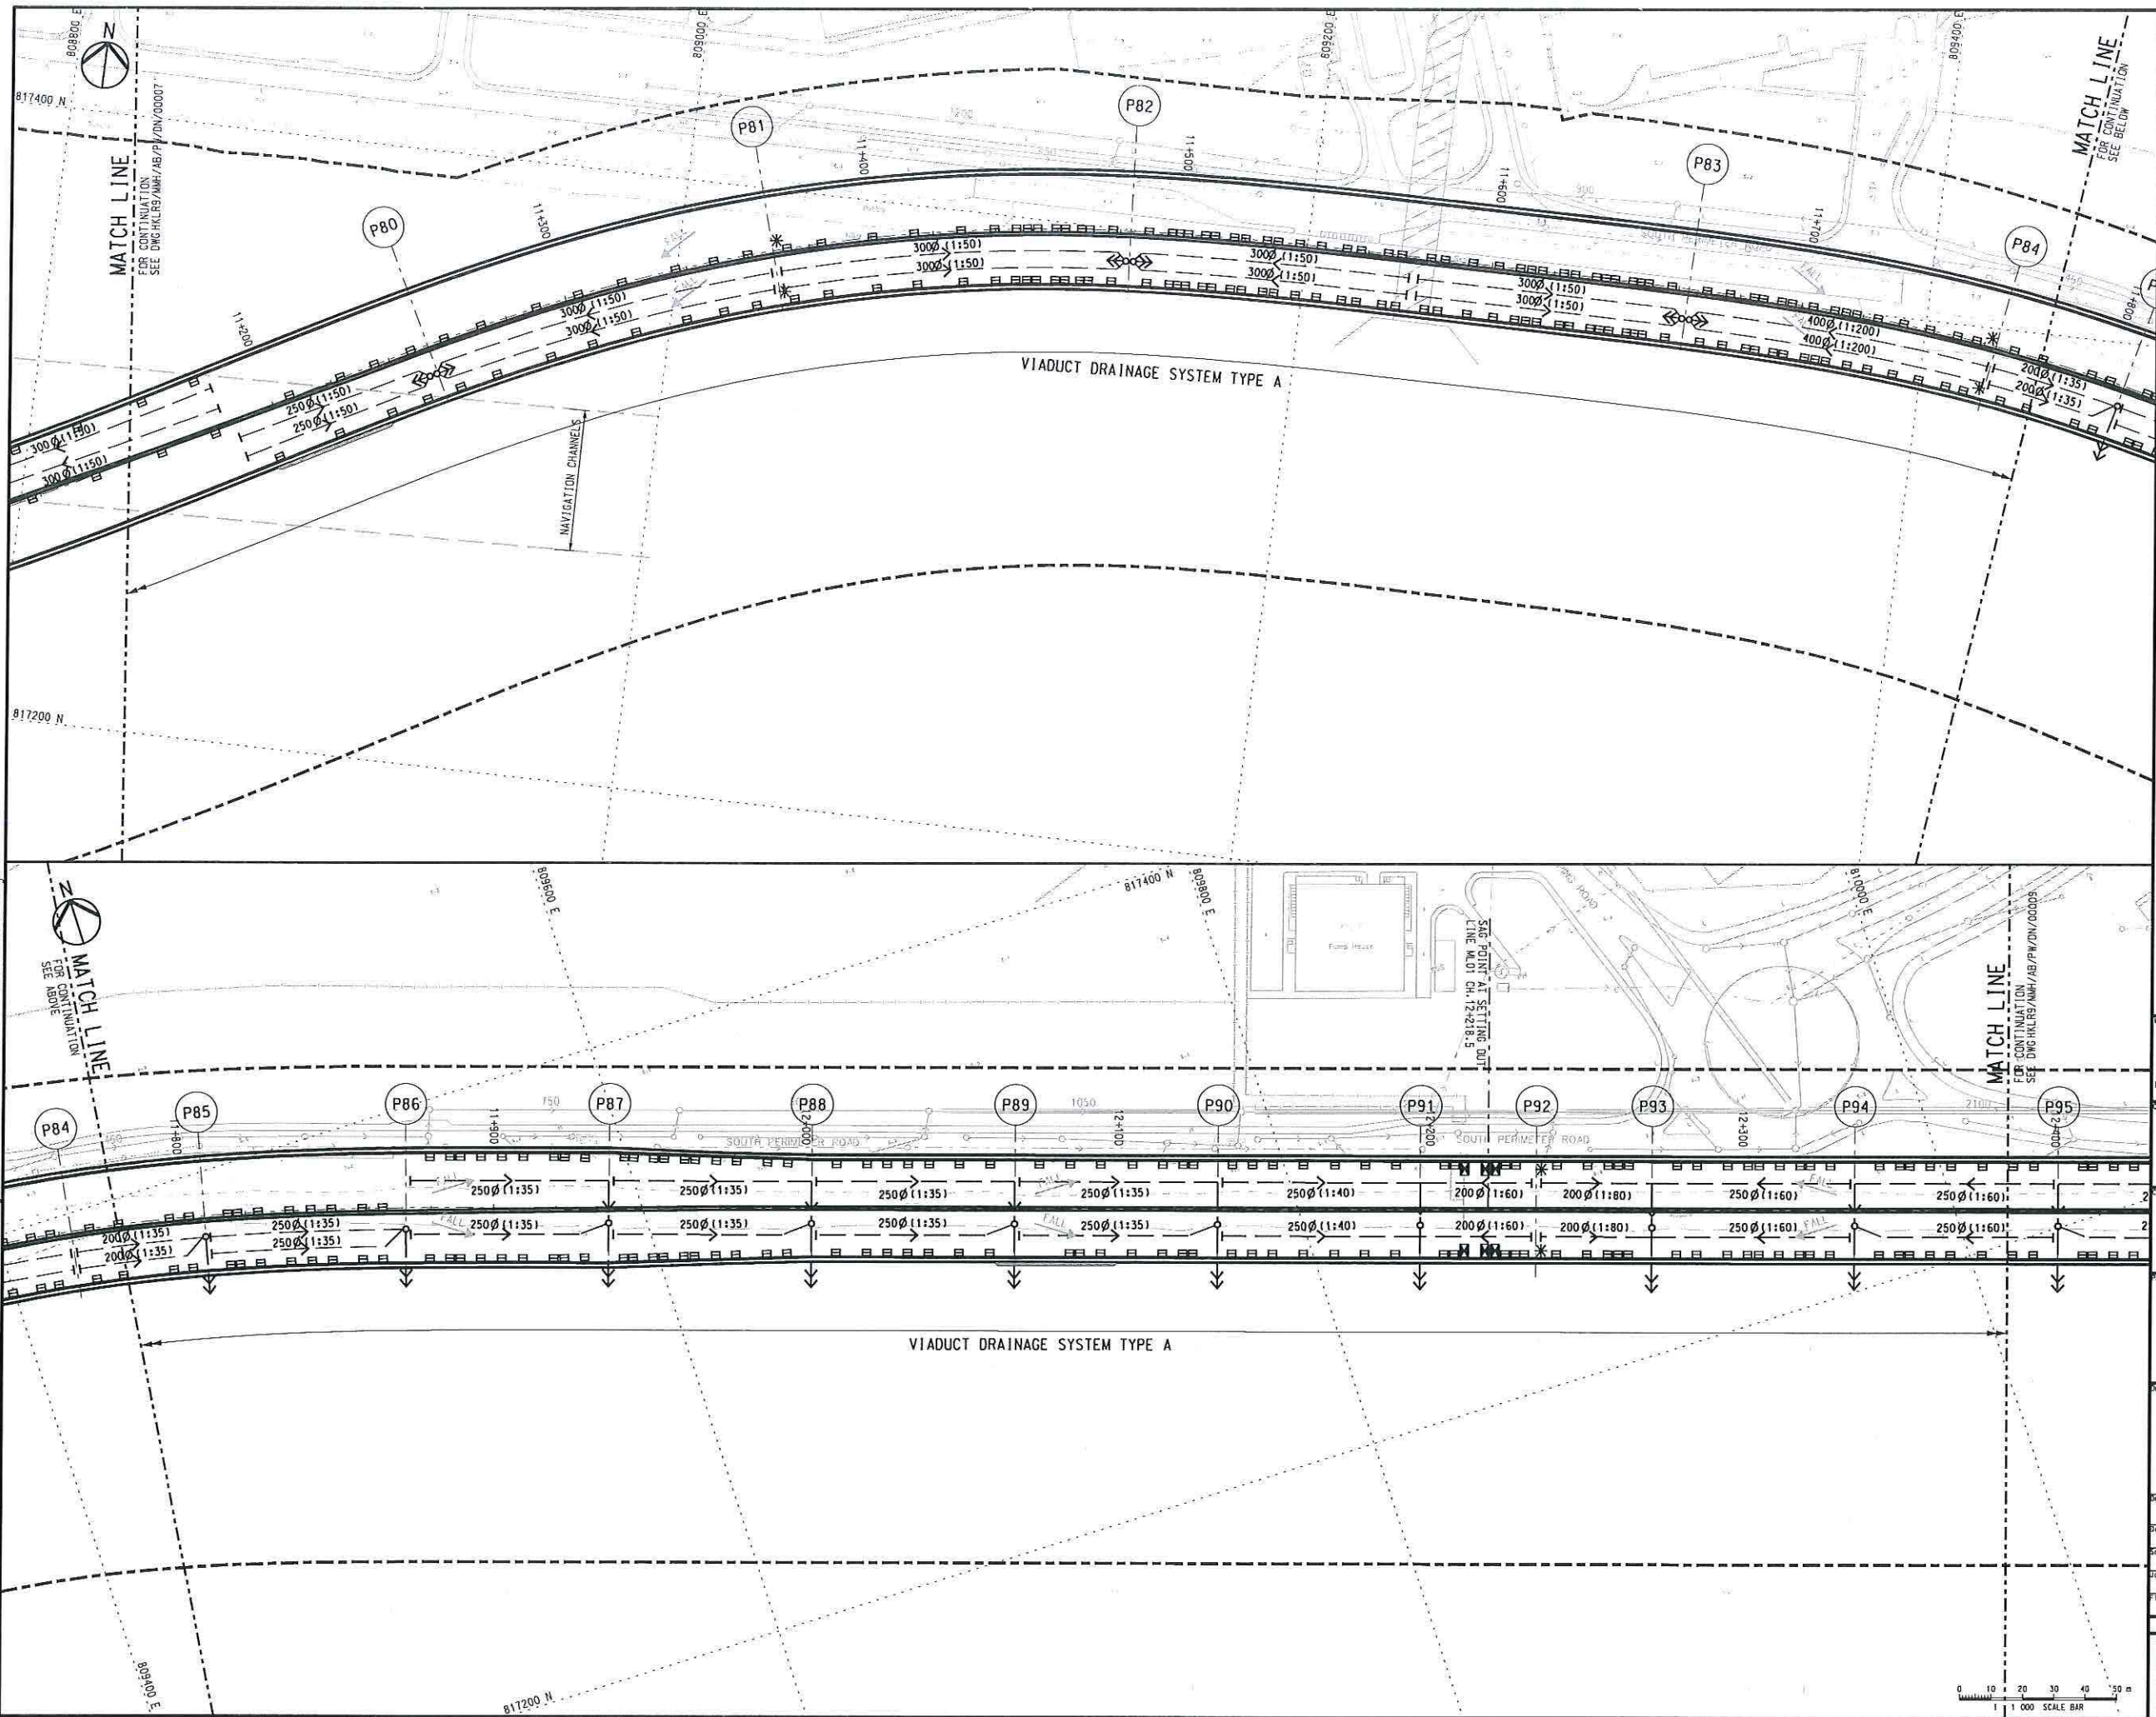

NOTES
1. FOR NOTES AND LEGEND, REFER TO DRG. NO. HKLR9/MMH/AB/PW/DN/00000.

As-built Drawing

Prepared by the Contractor "DCVJV"

Mr. W.K.Poon
(Project Director)

04JUN2019
Date

Checked by the Designer "Mott MacDonald"

Dr. H.T.Cheng
(Designer)

04JUN2019
Date

Endorsed by the Design Checker "AECOM"

Mr. Charles Luk
(Design Checker)

04JUN2019
Date

Main Contractor



Contractor's Designer



Consultant



Project Title
Contract No. HY/2011/09
Hong Kong - Zhuhai - Macao Bridge
Hong Kong Link Road
Section Between HKSAR Boundary
and Scenic Hill






Drawing Title
VIADUCT DRAINAGE SYSTEM
LAYOUT

Drawing No. HKLR9/MMH/AB/PW/DN/00008
Design AL
Scale 1:1000 (IN A1)
Job No. HKLR9
Title name HKLR9_MMH_AB_PW_DN_00008.dgn
Copyright reserved




As-built Drawing
 Prepared by the Contractor "DCVJV"

Mr. Y.K. Poon (Project Director)	11/01/19 Date
Checked by the Designer "Mott MacDonald"	
Dr. H.T. Cheng (Designer)	11/01/19 Date
Endorsed by the Design Checker "AECOM"	
Mr. Charles Luk (Design Checker)	11/01/19 Date

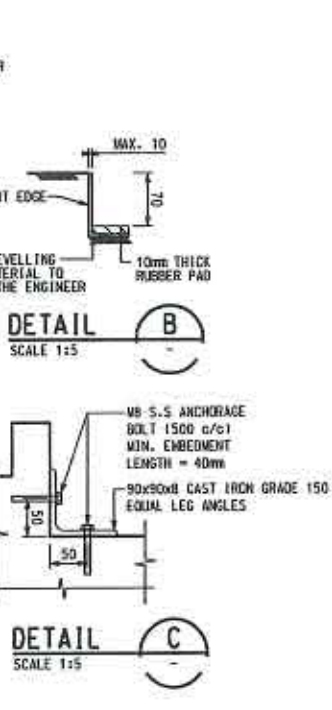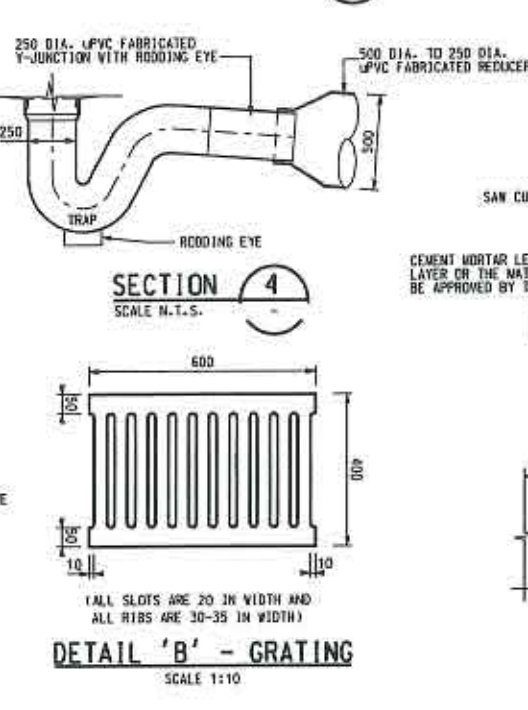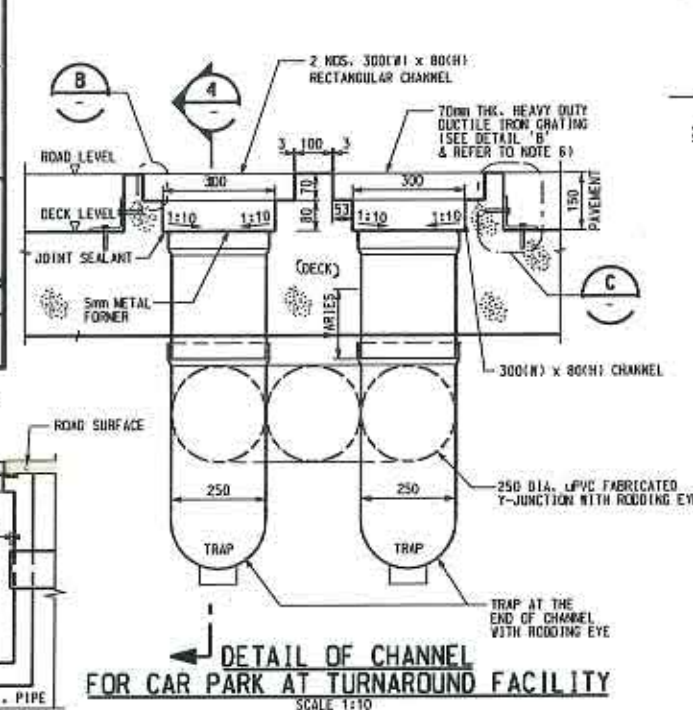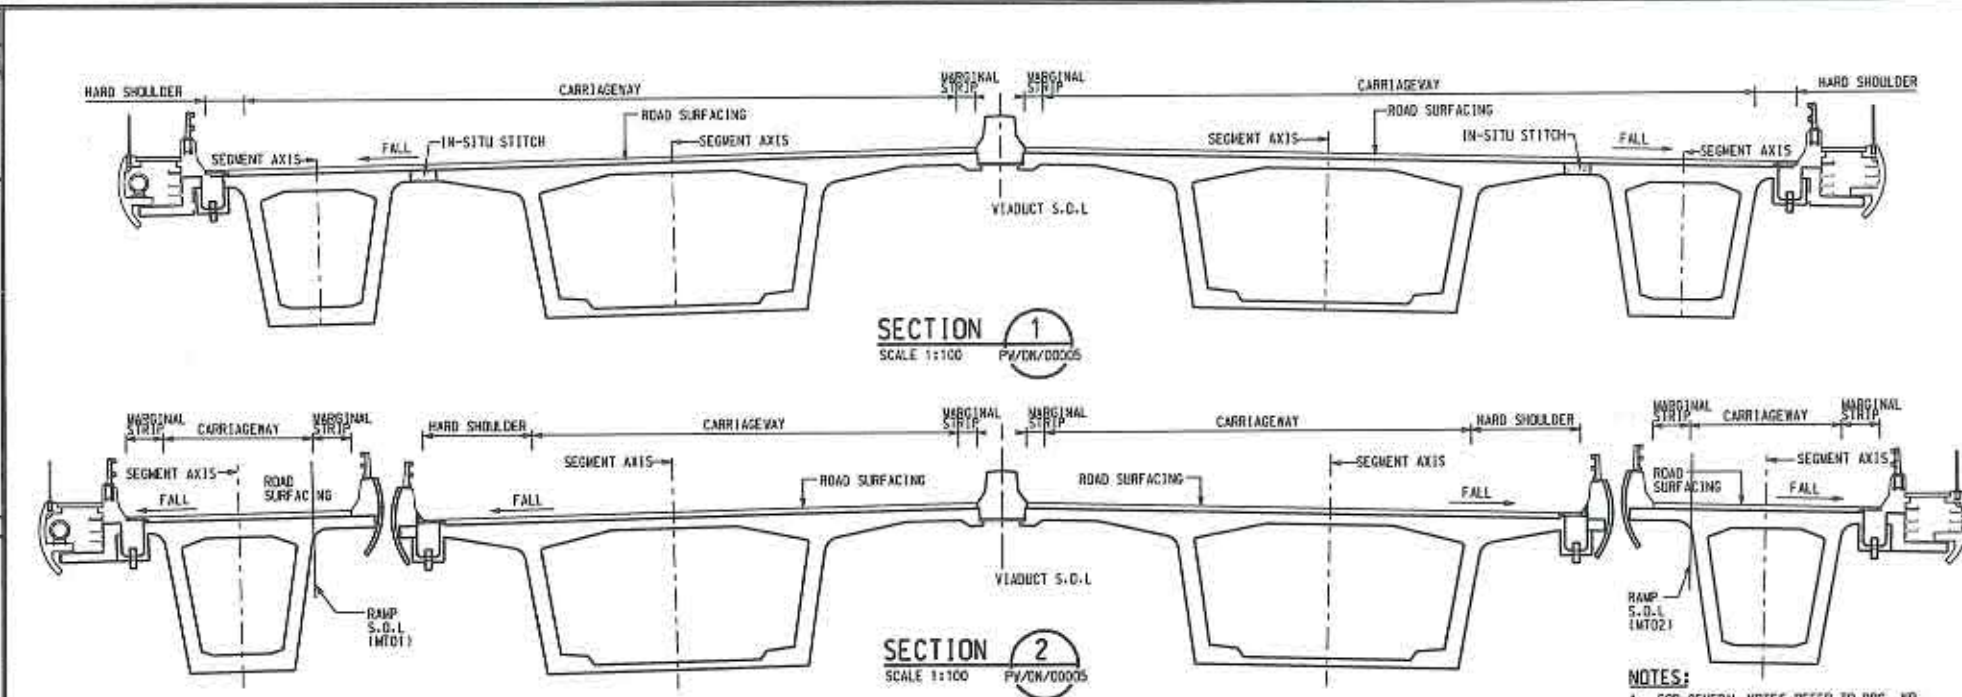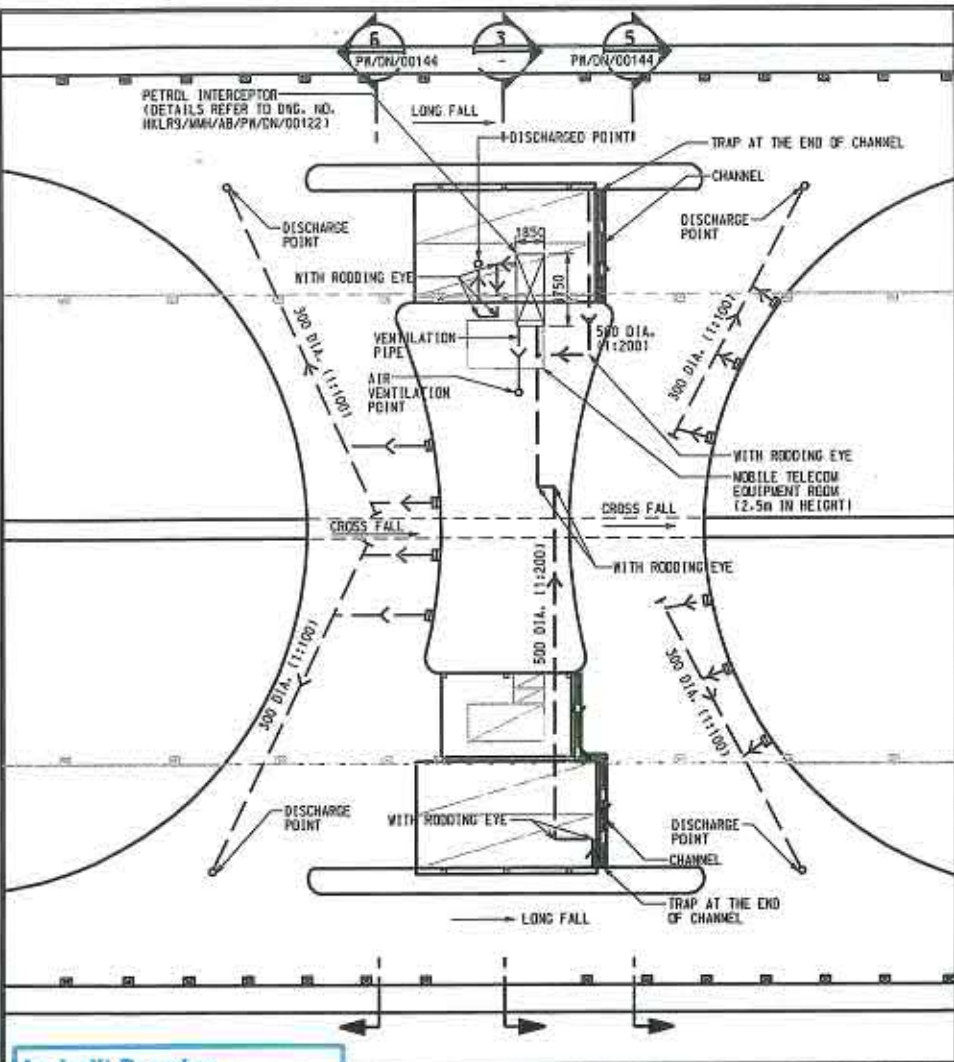

- NOTES:**
- FOR GENERAL NOTES REFER TO DRG. NO. HKLR9/MMH/AB/PW/DN/00000.
 - DETAILS OF GRATING REFERS TO HIGHWAY STANDARD DRG. NO. H3155.
 - DETAILS OF TREATMENT TO THE TOP OF PETROL INTERCEPTOR REFER TO TO ISO STANDARD DRG. NO. 051032.
 - DETAILS OF COVERS TO ACCESS OPENING AND DESTILLING OPENINGS REFER TO ISO STANDARD DRG. NO. 051034.
 - DETAILS OF ACCESS LADDER REFERS TO HIGHWAY STANDARD DRG. NO. H3159A.
 - U-COVERS SHALL BE HEAVY DUTY DUCTILE IRON WITH BLACK BITUMEN COATING COMPLYING WITH BS EN 124 CLASS D400.
 - GENERAL NOTES FOR STRUCTURAL, STAINLESS STEEL AND CONCRETE SHALL REFER TO HIGHWAY DEPARTMENT STANDARD DRAWING H3154A.

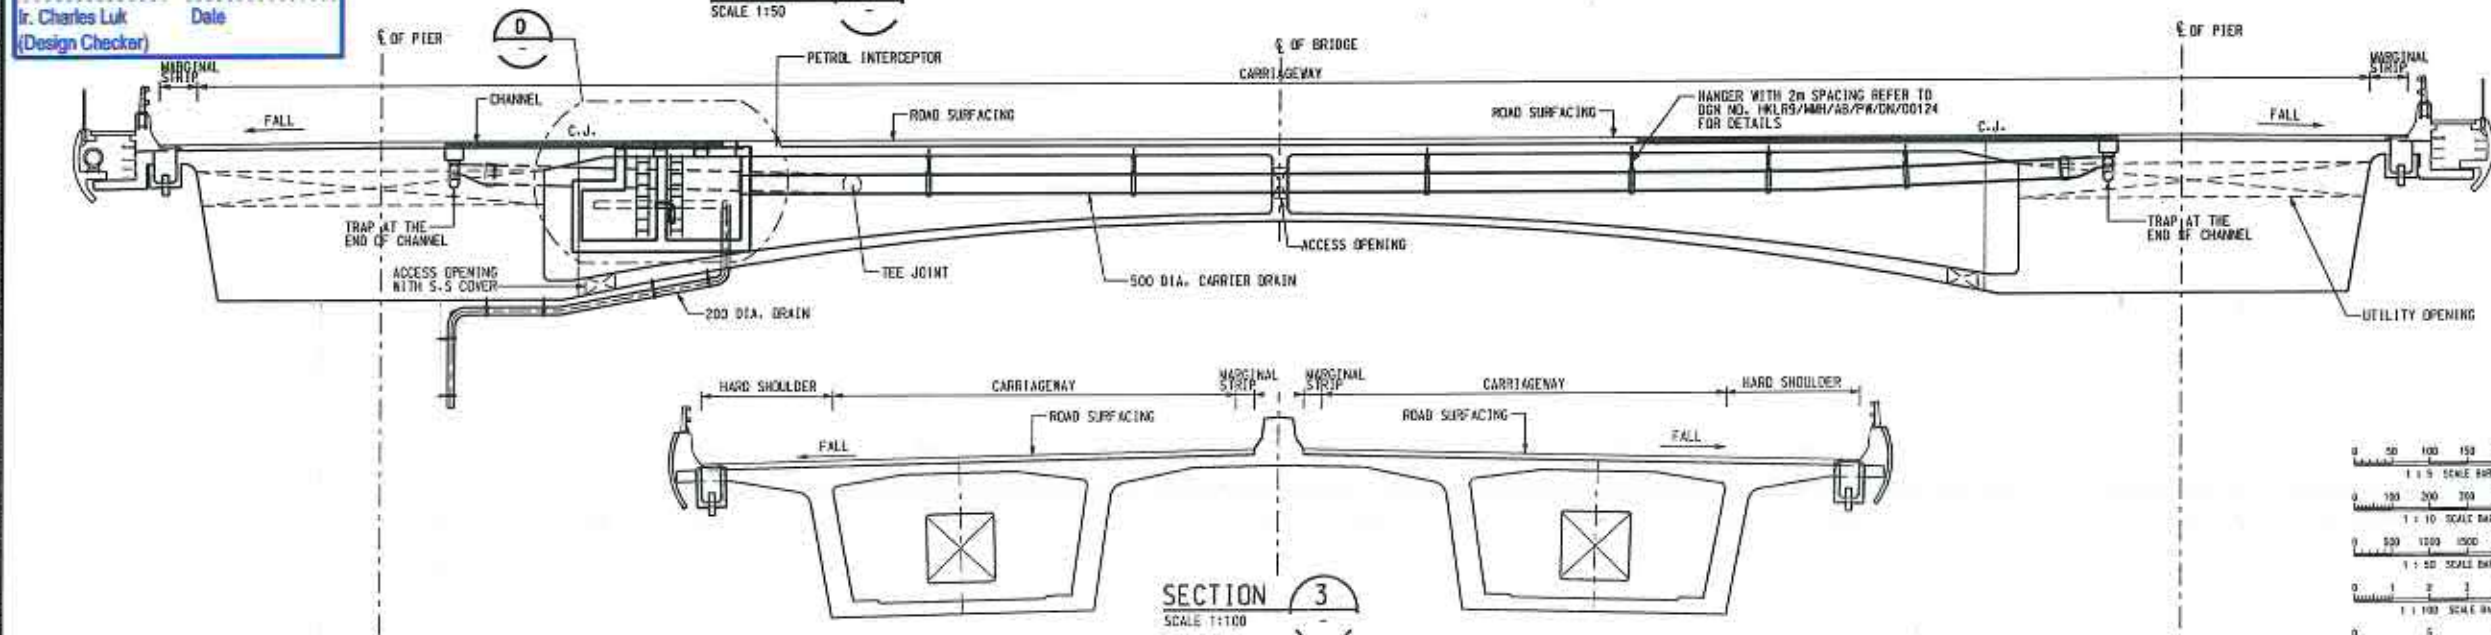

ARUP 奧雅納工程顧問
 Ove Arup & Partners Hong Kong Limited

Contract No. HY/2011/09
Hong Kong - Zhuhai - Macao Bridge
Hong Kong Link Road
Section Between HKSAR Boundary and Scenic Hill

TYPICAL DRAINAGE DETAILS AT TURNAROUND FACILITY

Project Title
 HKLR9/MMH/AB/PW/DN/00102

Revision
 AS SHOWN (IN A1)


Drawn by
 HKLR9

Checked by
 1 OF 1


File name
 HKLR9_MMH_AB_PW_DN_00102.dgn

Copyright
 Copyright reserved


路政署
HIGHWAYS DEPARTMENT

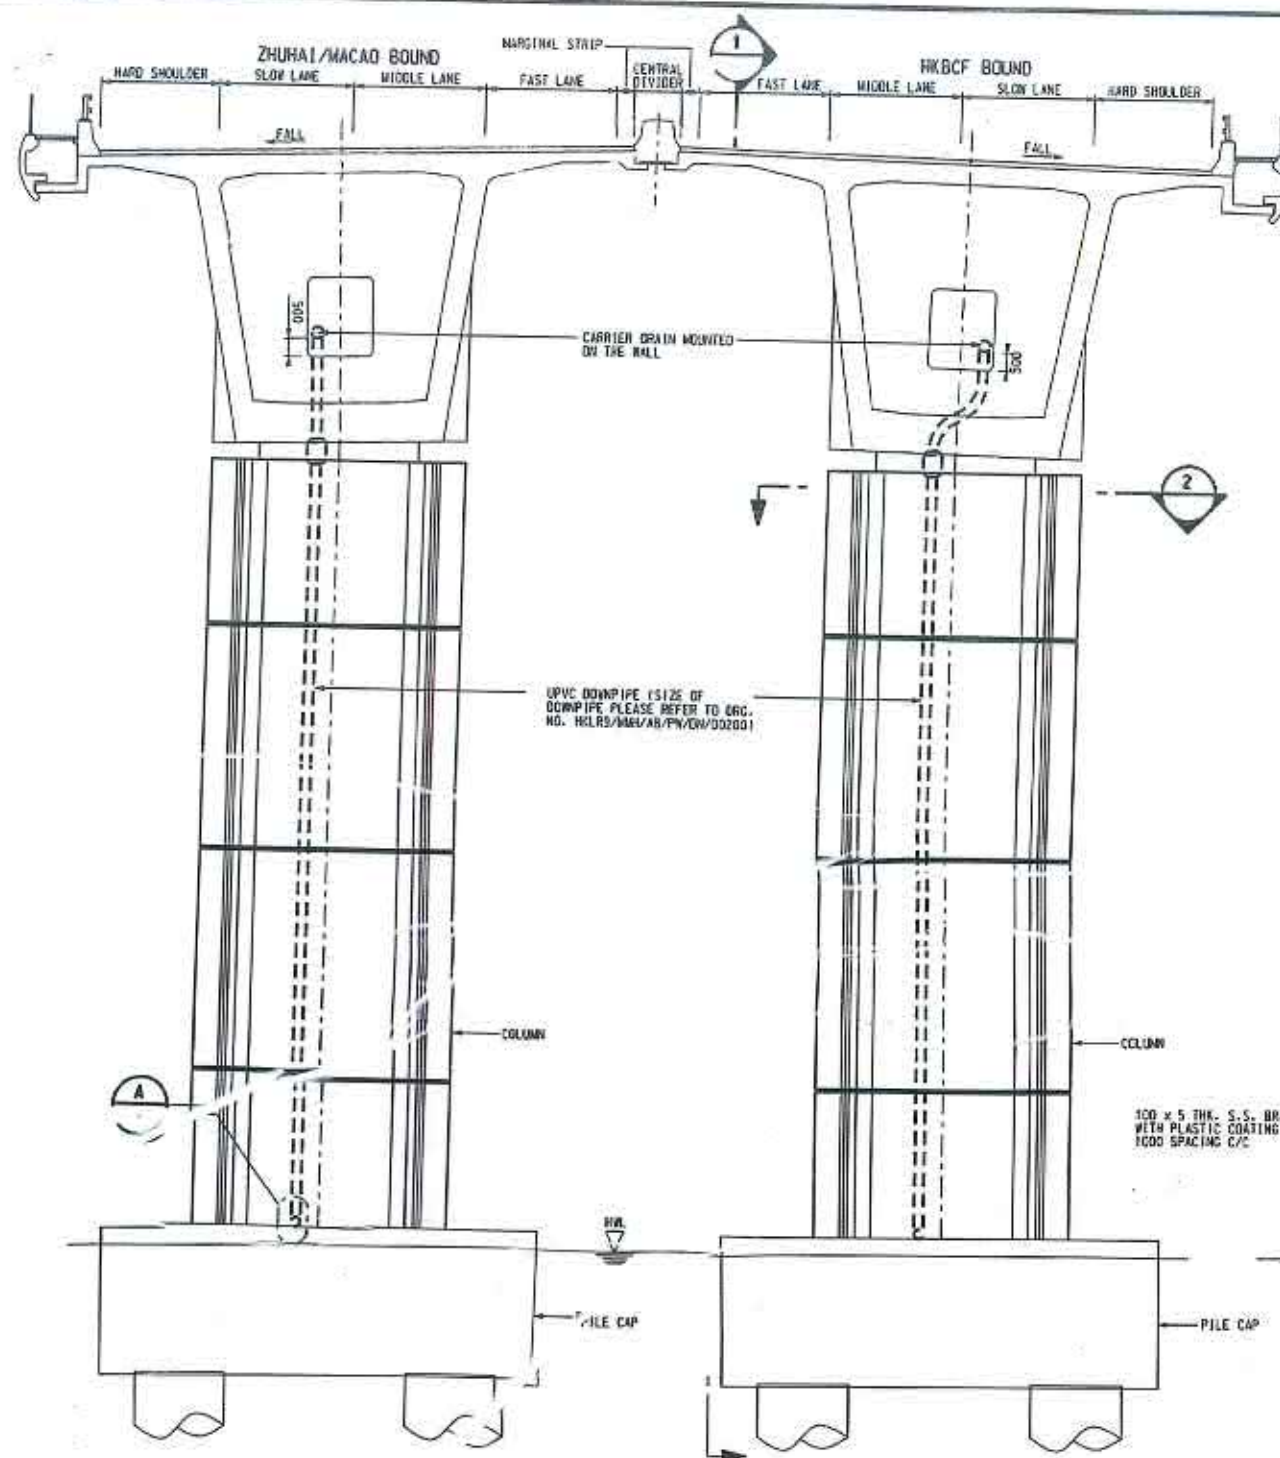


MONOLITHIC PIER AT NAVIGATION CHANNEL
(APPLICABLE TO PIER P17)
SCALE 1:100

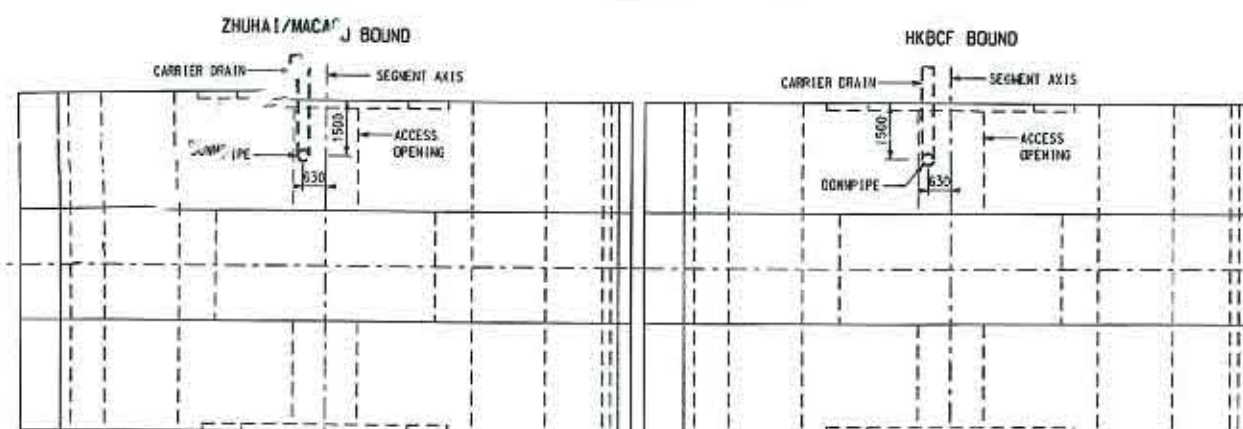


PLAN
SCALE 1:100

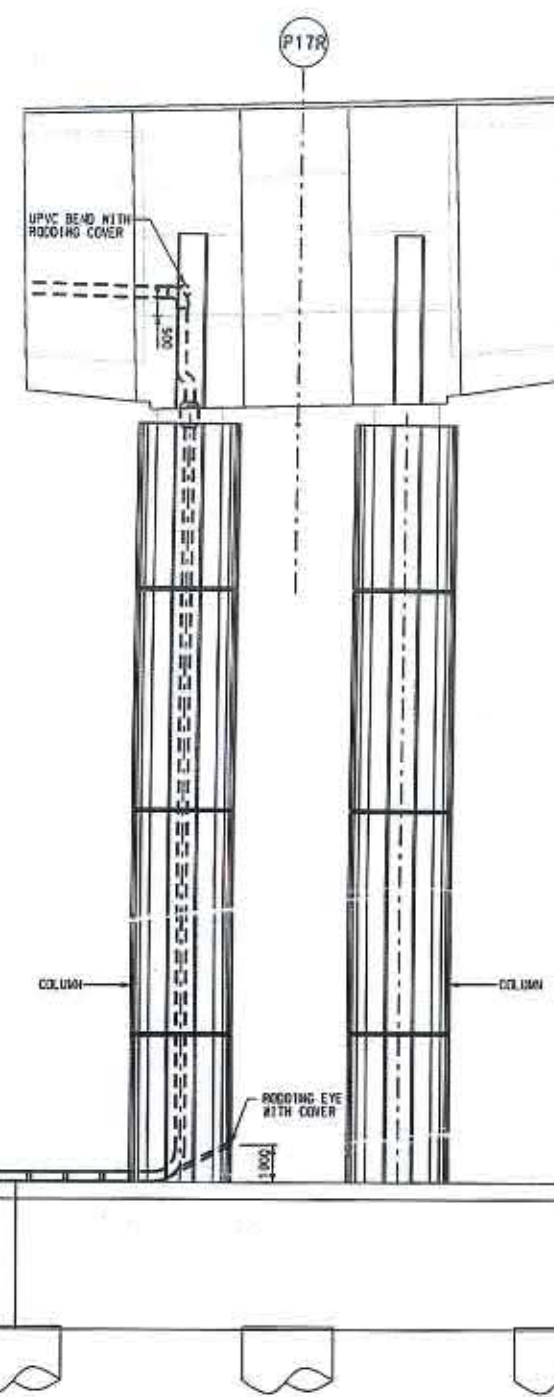


SECTION 1
SCALE 1:100

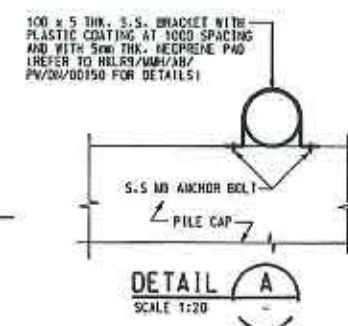

DETAIL A
SCALE 1:20

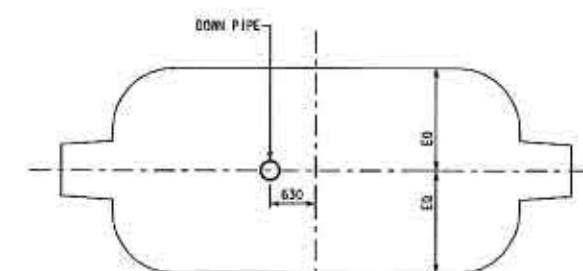

SECTION 2
SCALE 1:50

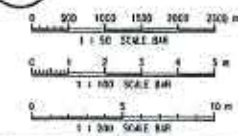

NOTES:

1. FOR GENERAL NOTES REFER TO DRG. NO. HKLR9/MMH/AB/PW/DN/00000.
2. THIS TYPE OF DRAINAGE ARRANGEMENT IS APPLICABLE TO PIER P17.
3. DETAILS OF ROODING EYE REFERS TO DRG. NO. HKLR9/MMH/AB/PW/DN/00125.
4. PIER STARTERS AT CROSSHEAD SHALL BE CRANKED TO ALLOW CARRIER DRAIN PASSING THROUGH TO THE PIER AREA IF NECESSARY.
5. THIS SIZE OF CARRIER DRAIN REFER TO DRG. NO. HKLR9/MMH/AB/PW/DN/00001-00003.
6. THE SIZE OF DOWNPIPE REFER TO DRG. NO. HKLR9/MMH/AB/PW/DN/00200.

As-built Drawing

Prepared by the Contractor "DCV/JV"

Mr. W.K. Poon
(Project Director)
Date 11/01/19

Checked by the Designer "Mott MacDonald"

Dr. H.T. Cheng
(Designer)
Date 11/01/19

Endorsed by the Design Checker "AECOM"

Mr. Charles Luk
(Design Checker)
Date 11/01/19



Dropages - China Harbour - VSL Joint Venture 英國-中國聯合-建築有限公司




Contract No. HY/2011/09
Hong Kong - Zhuhai - Macao Bridge
Hong Kong Link Road
Section Between HK SAR Boundary and Scenic Hill

TYPICAL DRAINAGE
DOWNPIPE ARRANGEMENT - PIER P17

Design No.	HKLR9/MMH/AB/PW/DN/00103	Rev.	-
Design	AL	SHL	HTC
Scale	1:100 (IN A1)	AS-BUILT	
Sheet No.	HKLR9	Sheet No.	1 OF 13


File Name: HKLR9_MMH_AB_PW_DN_00103.dgn
COPYRIGHT RESERVED



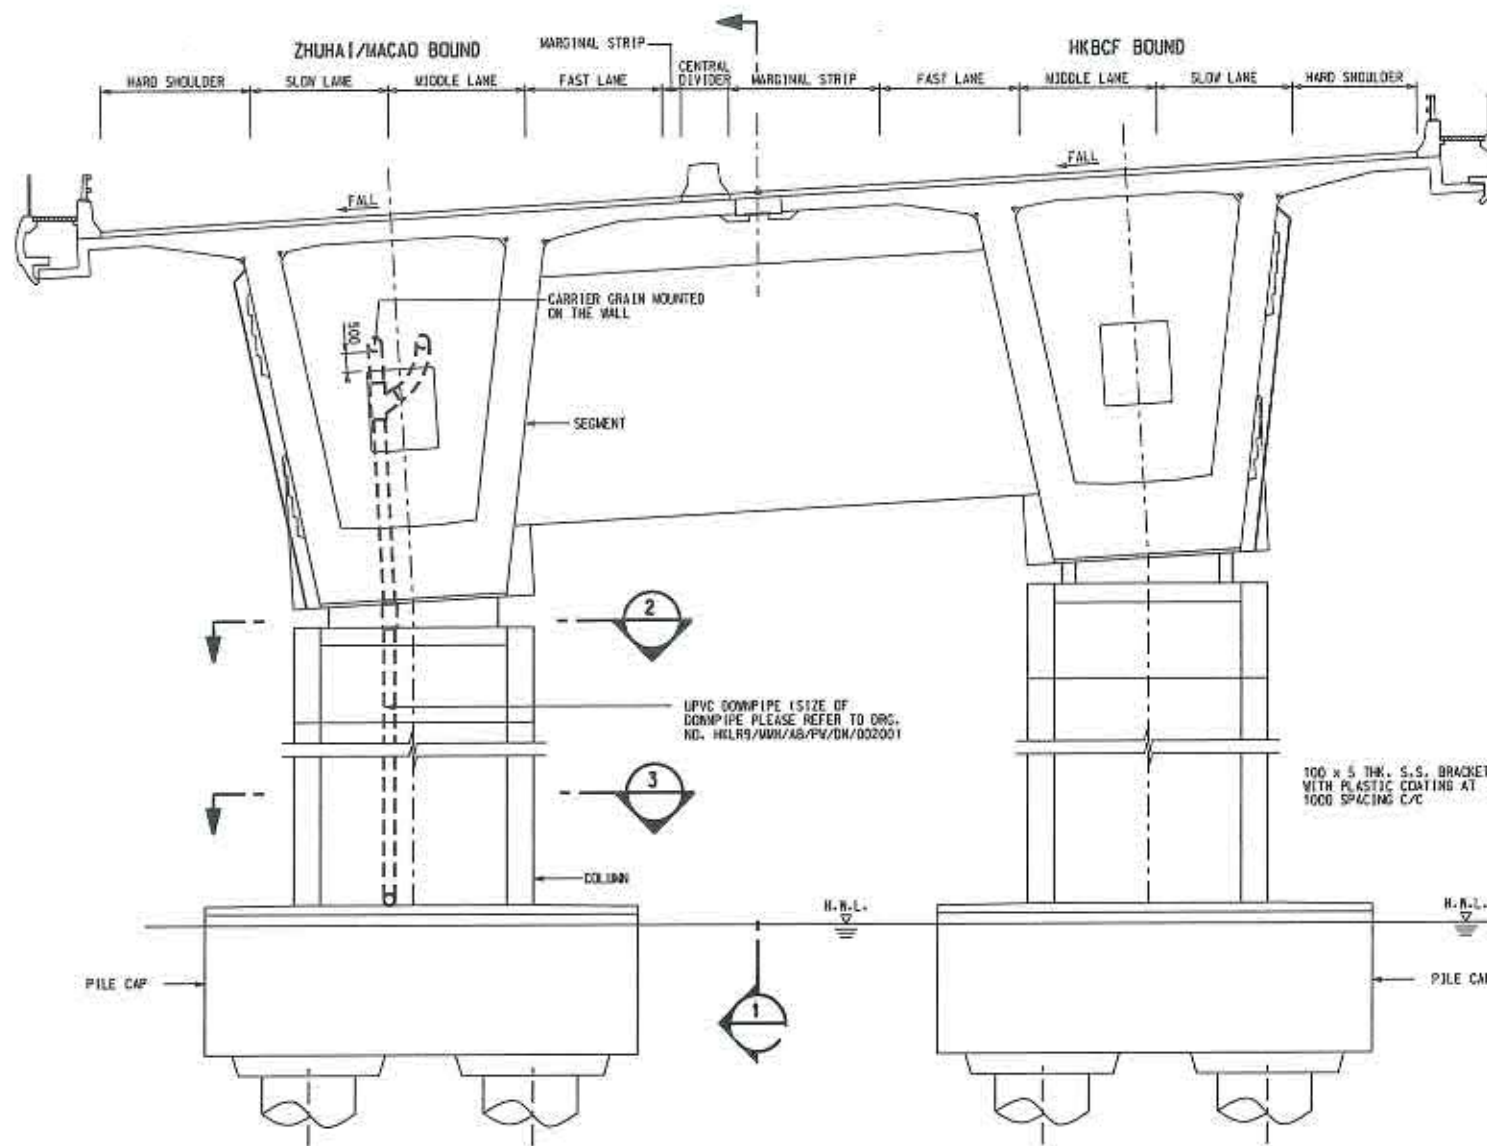


**MONOLITHIC PIERS AT AIRPORT CHANNEL
 (APPLICABLE TO PIER P79)**

SCALE 1:100

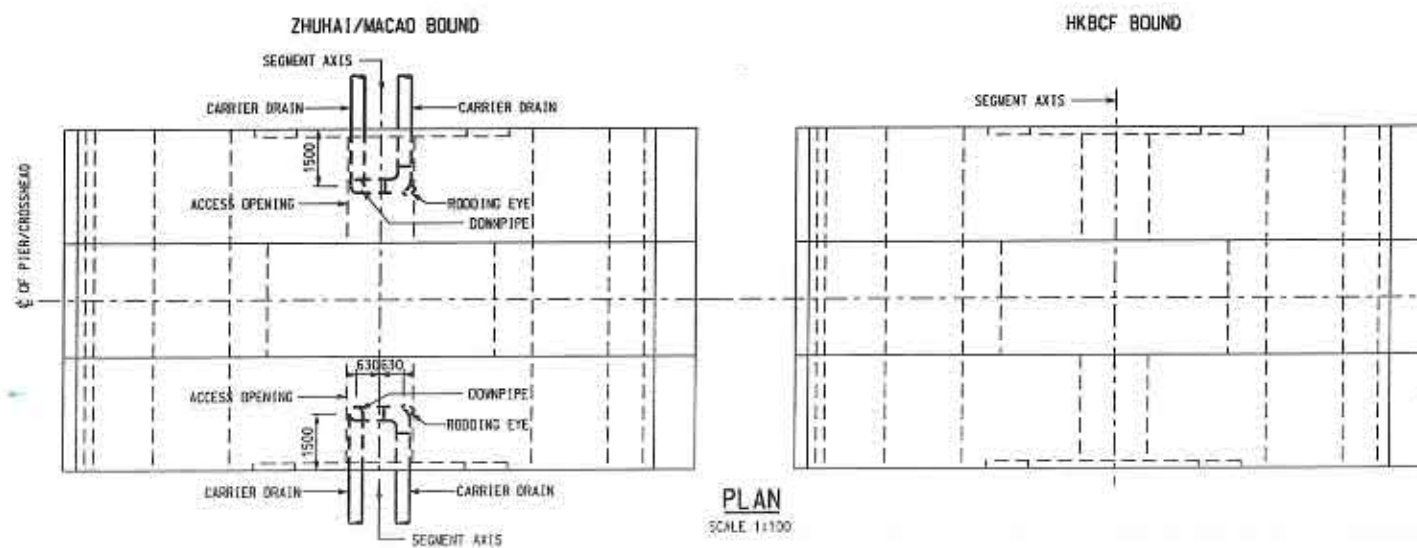


PLAN

SCALE 1:100

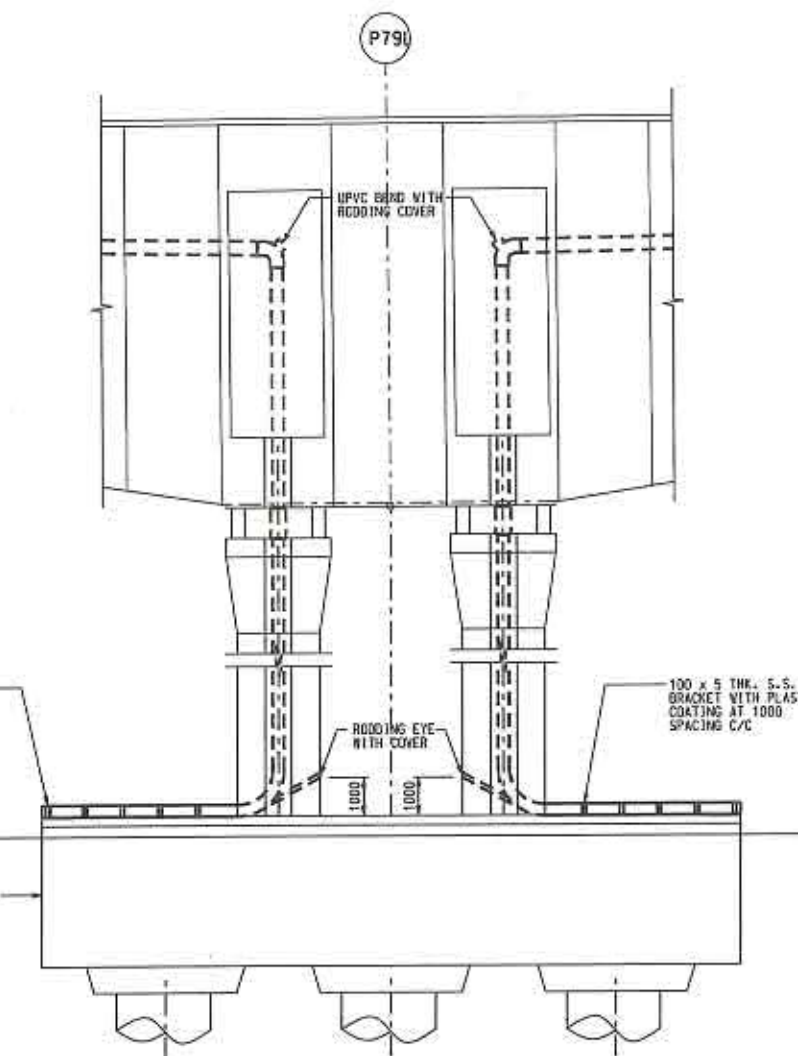


SECTION 1

SCALE 1:100

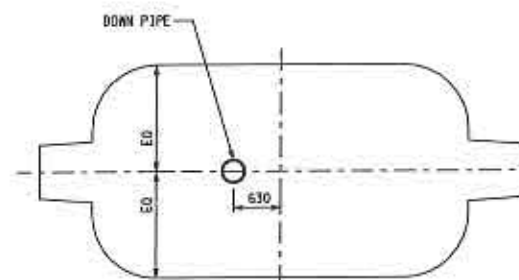


SECTION 2

SCALE 1:50

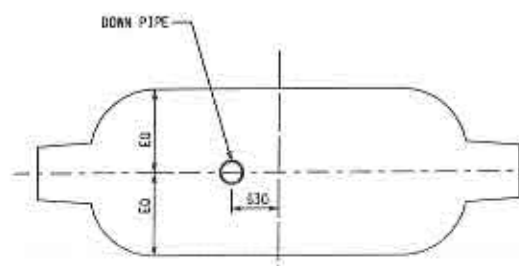


SECTION 3

SCALE 1:50

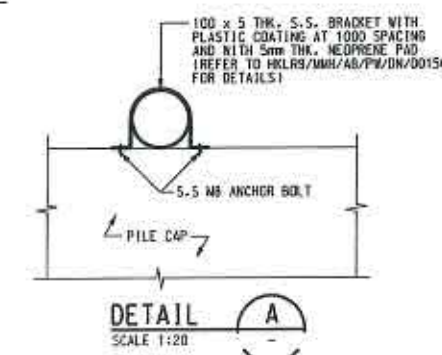

DETAIL A

SCALE 1:20

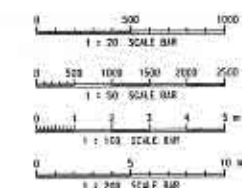

NOTES:

1. FOR GENERAL NOTES REFER TO DRG. NO. HKLR9/MMH/AB/PW/DN/00000.
2. THIS TYPE OF DRAINAGE ARRANGEMENT IS APPLICABLE TO PIERS P79.
3. DETAILS OF RODDING EYE REFERS TO DRG. NO. HKLR9/MMH/AB/PW/DN/00129.
4. PIER STARTERS AT CROSSHEAD SHALL BE CRANKED TO ALLOW CARRIER DRAIN PASSING THROUGH TO THE PIER AREA IF NECESSARY.
5. THIS SIZE OF CARRIER DRAIN REFER TO DRG. NO. HKLR9/MMH/AB/PW/DN/00001-00009.
6. THE SIZE OF DOWNPIPE REFER TO DRG. NO. HKLR9/MMH/AB/PW/DN/00200.

As-built Drawing

Prepared by the Contractor "DCVJ"

Mr. W. C. Poon
 (Project Director)
 Date 11/01/19

Checked by the Designer "Mott MacDonald"
 Dr. H.T. Cheng
 (Designer)
 Date 11/01/19

Enforced by the Design Checker "AECOM"
 Mr. Charles Luk
 (Design Checker)
 Date 11/01/19




Contract No. HY2011/09
Hong Kong - Zhuhai - Macao Bridge
Hong Kong Link Road
Section Between HKSAR Boundary and Scenic Hill


**TYPICAL DRAINAGE
 DOWNPIPE ARRANGEMENT - PIER P79**

Project No.	HKLR9/MMH/AB/PW/DN/00104	Rev.	-
Author	AL	Shl	HTC
Check	1:100 (IN A1)	Appr'd	AS-BUILT
Drawn by	HKLR9	Scale	2 OF 13
File name	HKLR9_MMH_AB_PW_DN_00104.dgn		
Copyright	RESERVED		




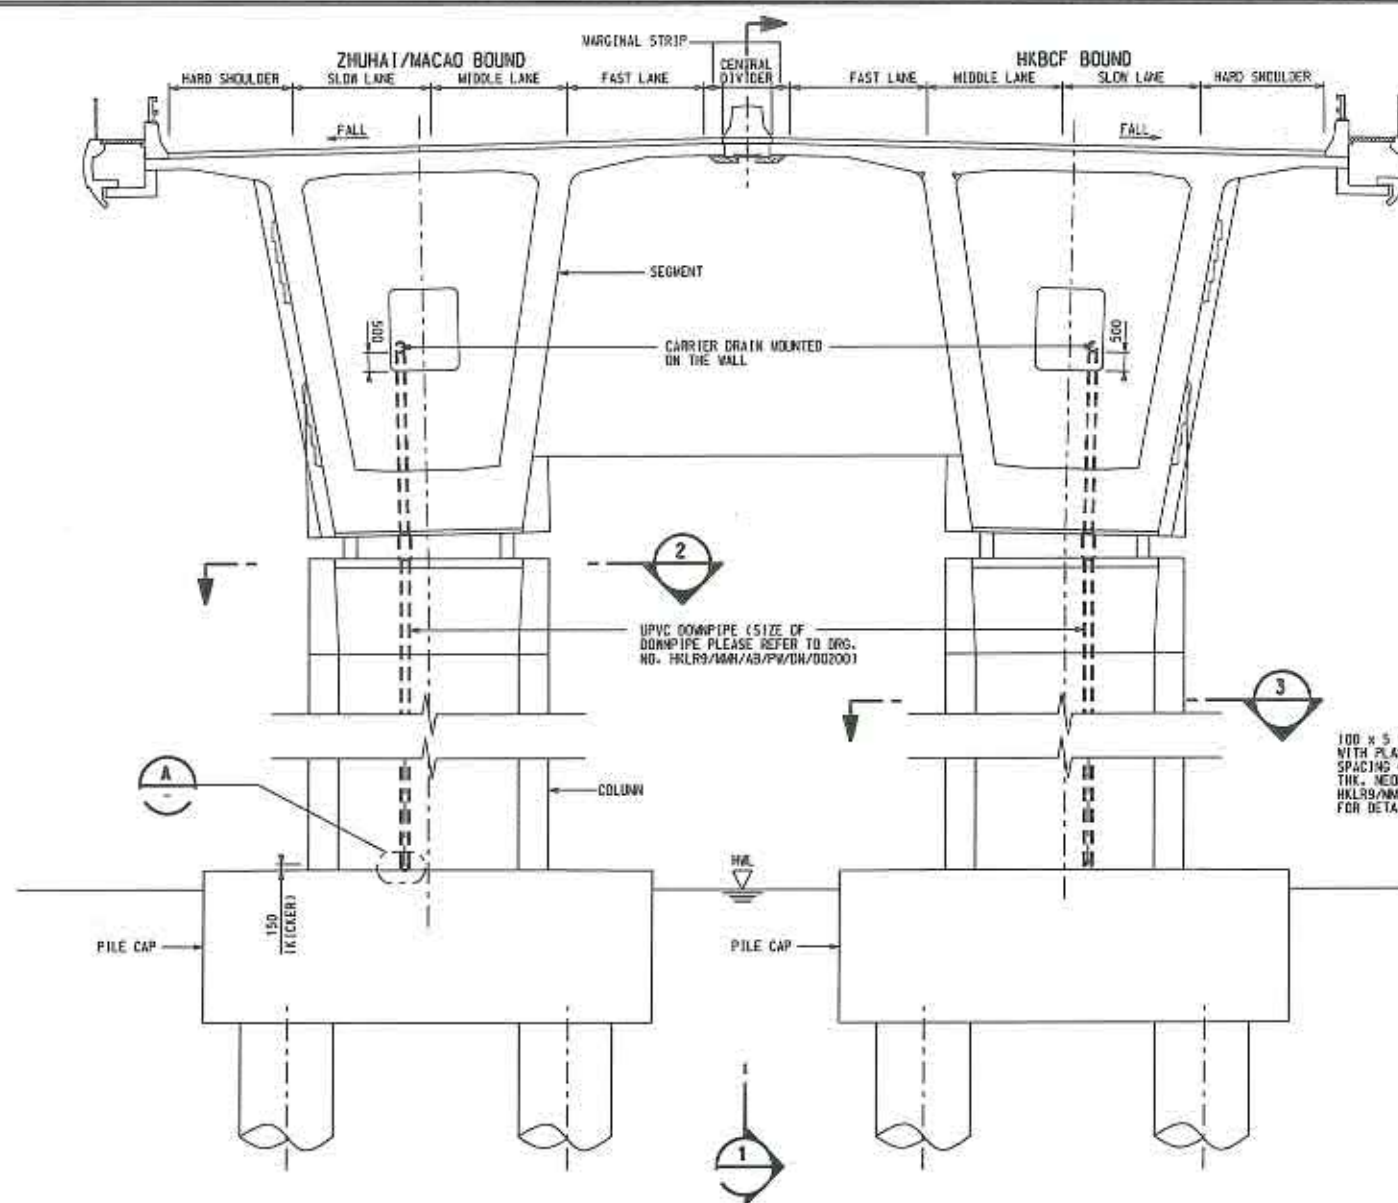

**MONOLITHIC PIERS AT AIRPORT CHANNEL
 (APPLICABLE TO PIER P68)**
 SCALE 1:100

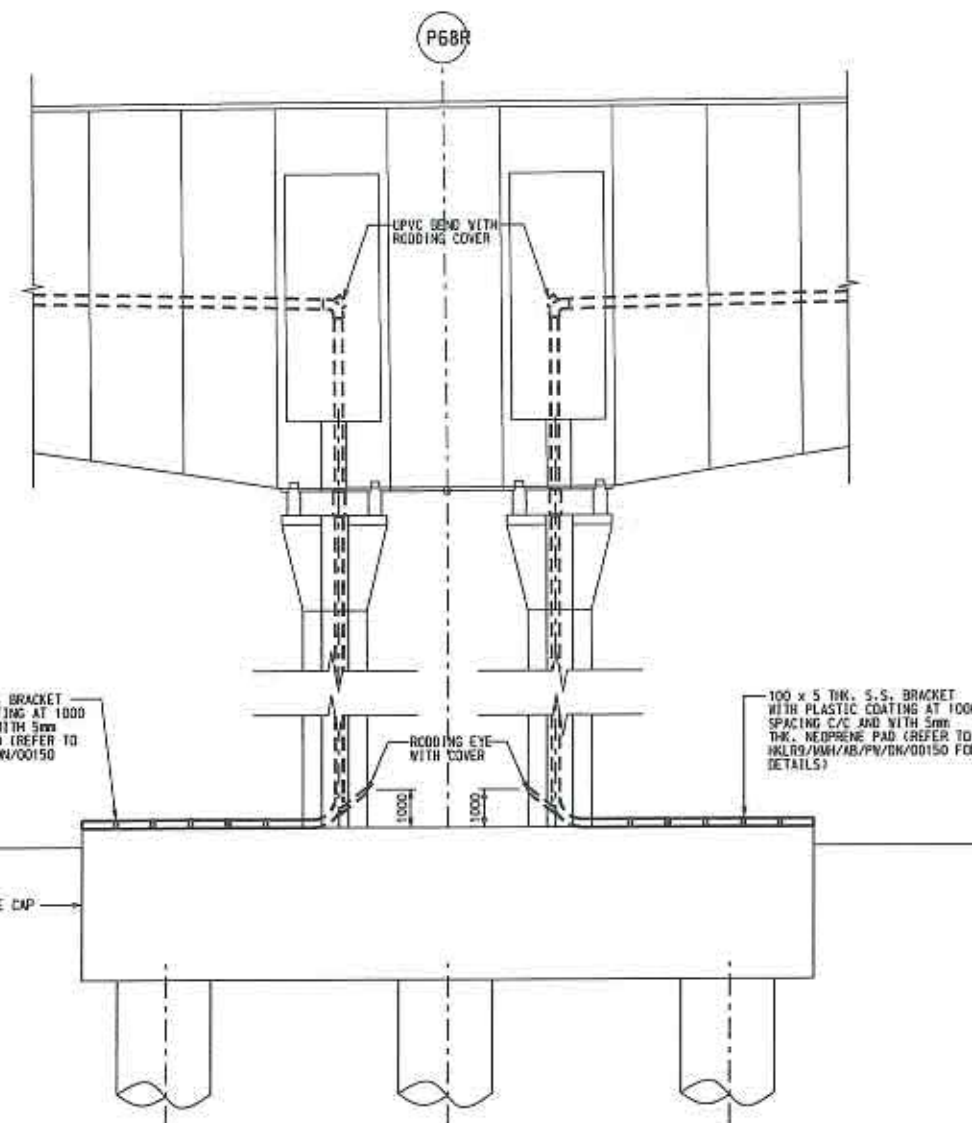


SECTION 1
 SCALE 1:100

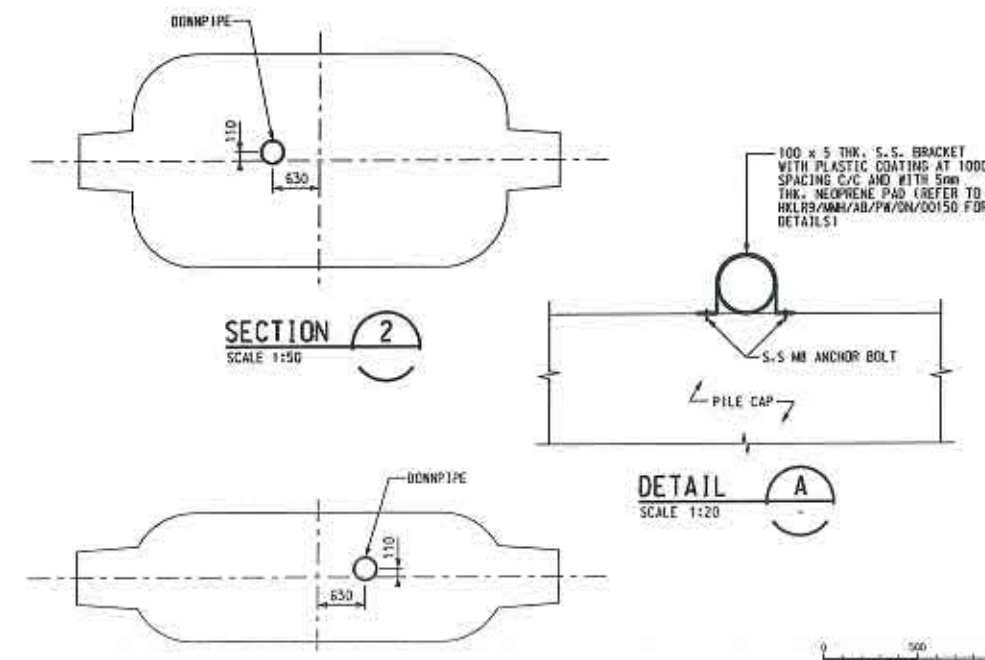

SECTION 2
 SCALE 1:50

DETAIL A
 SCALE 1:20

SECTION 3
 SCALE 1:50

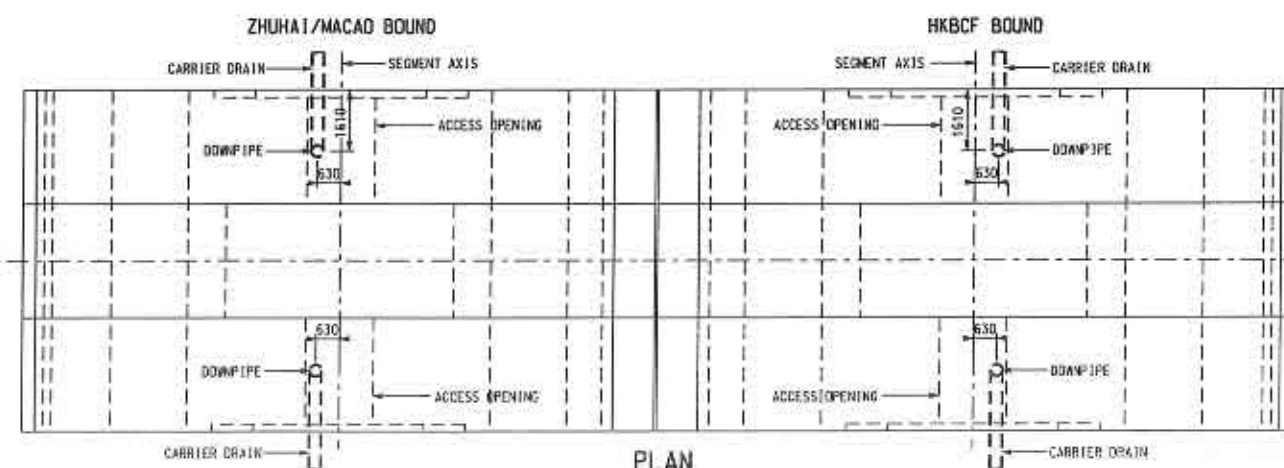

PLAN
 SCALE 1:100

NOTES:

1. FOR GENERAL NOTES REFER TO DRG. NO. HKLR9/MMH/AB/PW/DN/00000.
2. THIS TYPE OF DRAINAGE ARRANGEMENT IS APPLICABLE TO PIERS P68.
3. DETAILS OF RODDING EYE REFERS TO DRG. NO. HKLR9/MMH/AB/PW/DN/00125.
4. PIER STARTERS AT CROSSHEAD SHALL BE CRANKED TO ALLOW CARRIER DRAIN PASSING THROUGH TO THE PIER AREA IF NECESSARY.
5. THIS SIZE OF CARRIER DRAIN REFER TO DRG. NO. HKLR9/MMH/AB/PW/DN/00001-00009.
6. THE SIZE OF DOWNPIPE REFER TO DRG. NO. HKLR9/MMH/AB/PW/DN/00200.
7. STAINLESS STEEL FOR BRACKET SHALL BE GRADE 316 S33 AND STAINLESS STEEL ANCHOR BOLT SHALL BE GRADE A4-80.

As-built Drawing

Prepared by the Contractor "DCV JV"

Mr. W.K. Moon 11/01/19
 (Project Director) Date

Checked by the Designer "Mott MacDonald"

Dr. H.T. Chang 11/01/19
 (Designer) Date

Endorsed by the Design Checker "AECOM"

Mr. Charles Luk 11/01/19
 (Design Checker) Date



Contract No. HY/2011/09
Hong Kong - Zhuhai - Macao Bridge
Hong Kong Link Road
Section Between HKSAR Boundary and Scenic Hill

**TYPICAL DRAINAGE
 DOWNPIPE ARRANGEMENT - PIER P68**

Drawing No. **HKLR9/MMH/AB/PW/DN/00105**


Scale **1:100 (IN A1)**

Sheet No. **3 OF 13**


Copyright Reserved





Printed by : 1/30/2019
 File name : D:\HKL9\As-Built drawings\DDA 20\Final As-Built drawings\Part 1\HKL9_MMH_AB_PW_DN_00106.dgn
 D:\HKL9\As-Built drawings\DDA 20\Final As-Built drawings\Part 1\HKL9_MMH_AB_PW_DN_00106.dgn

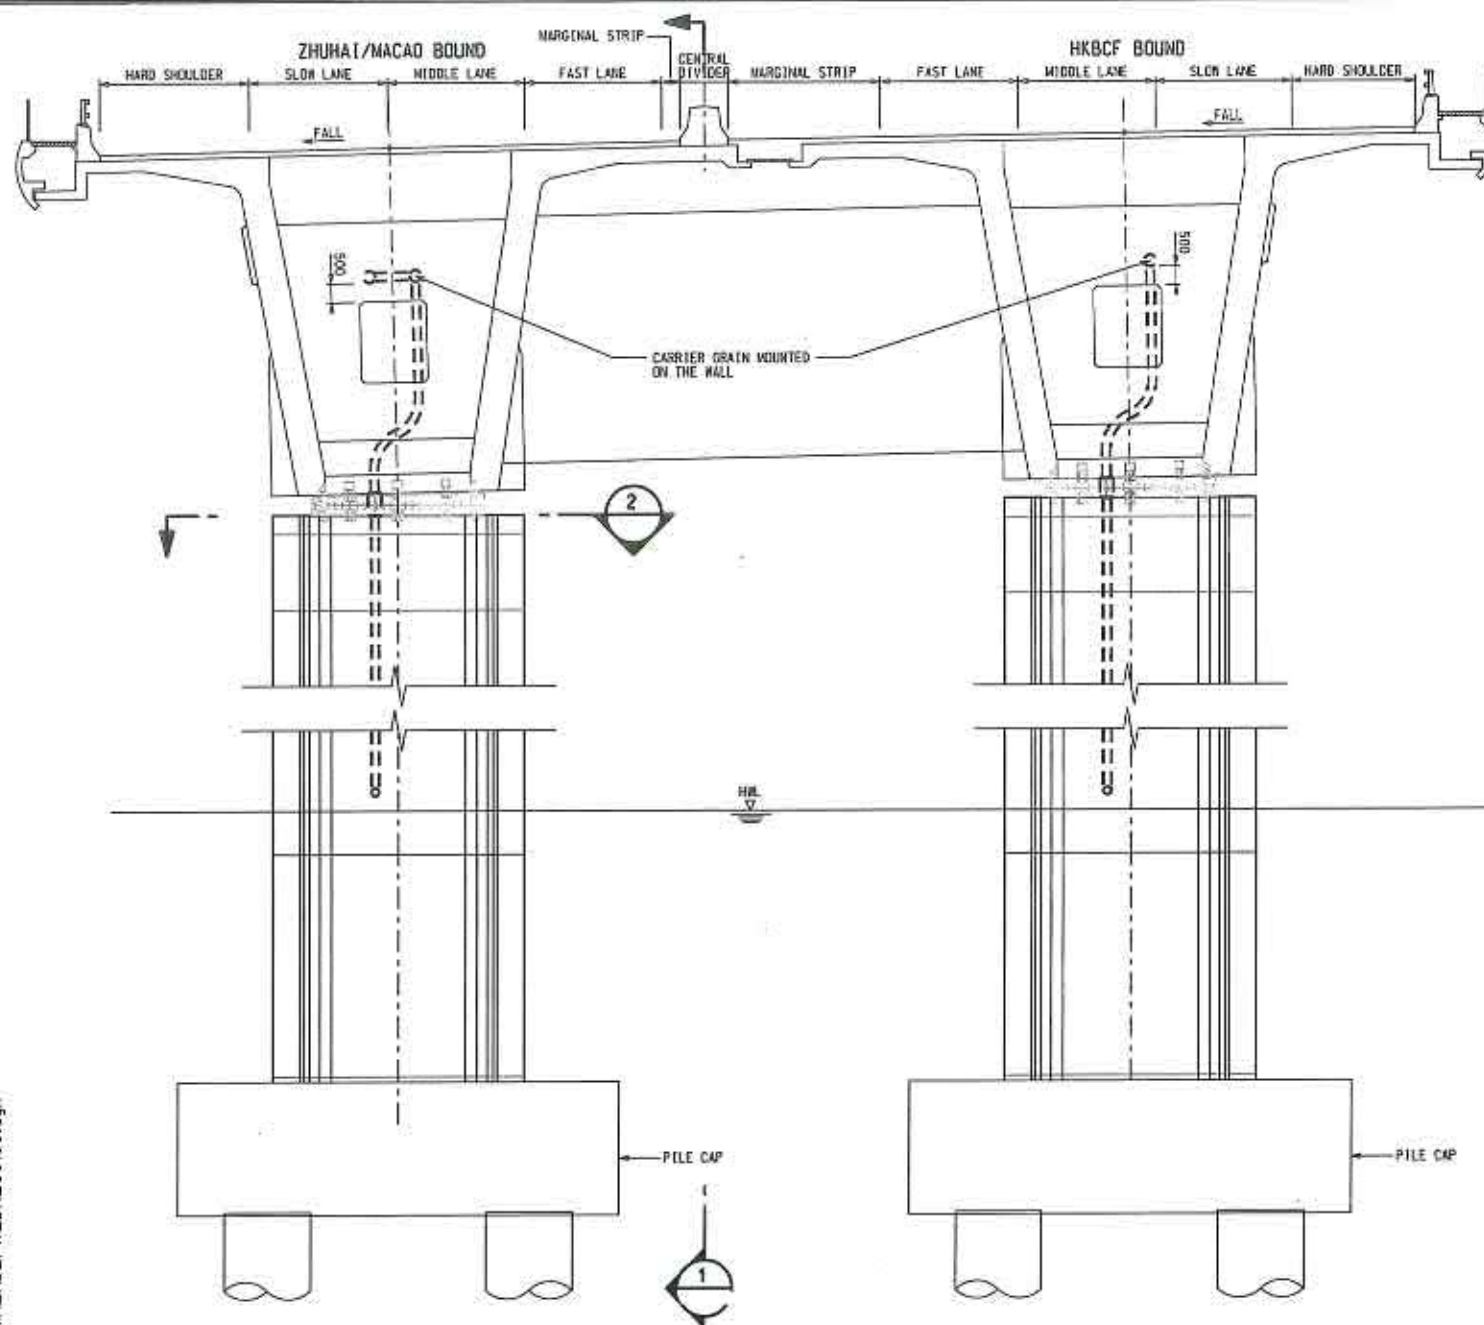


MONOLITHIC PIERS AT AIRPORT CHANNEL
 (APPLICABLE TO PIER P77)
 SCALE 1:100

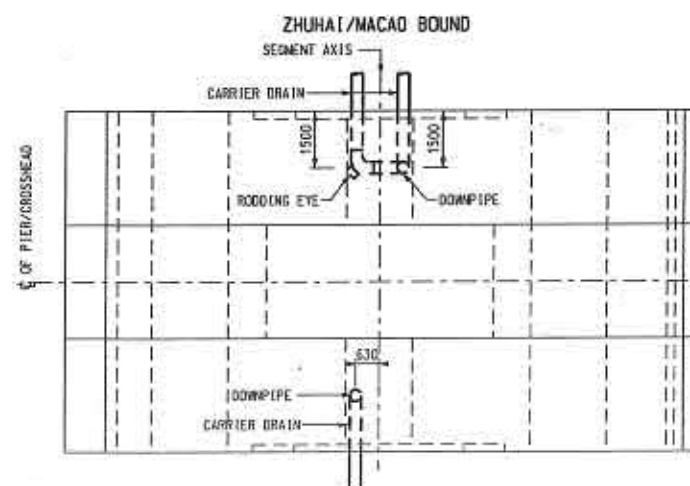


PLAN
 SCALE 1:100

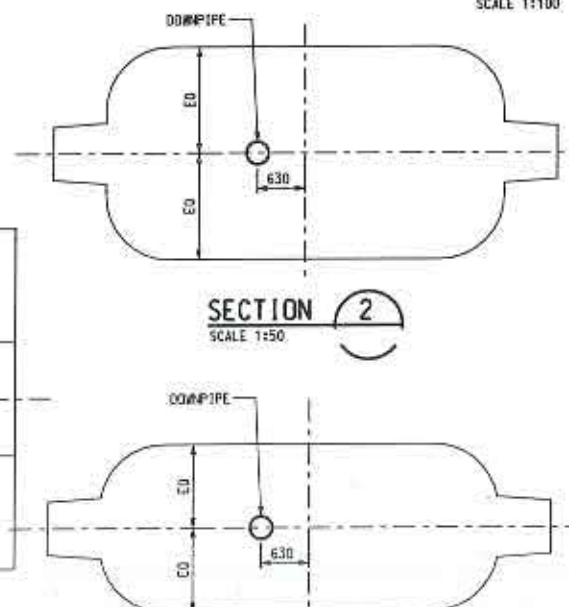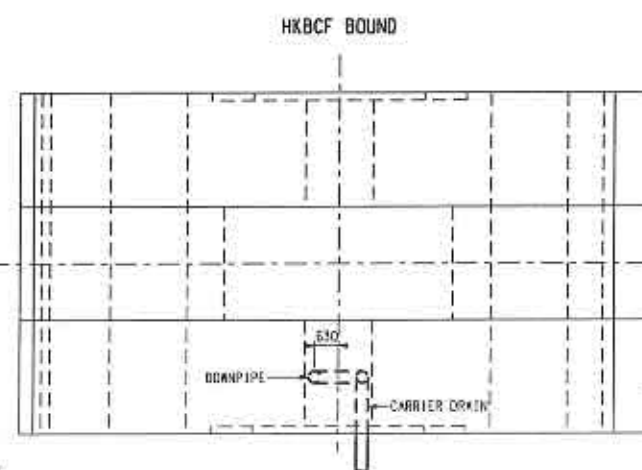


SECTION 2
 SCALE 1:50

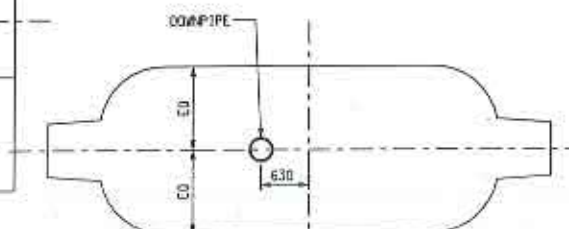


SECTION 3
 SCALE 1:50

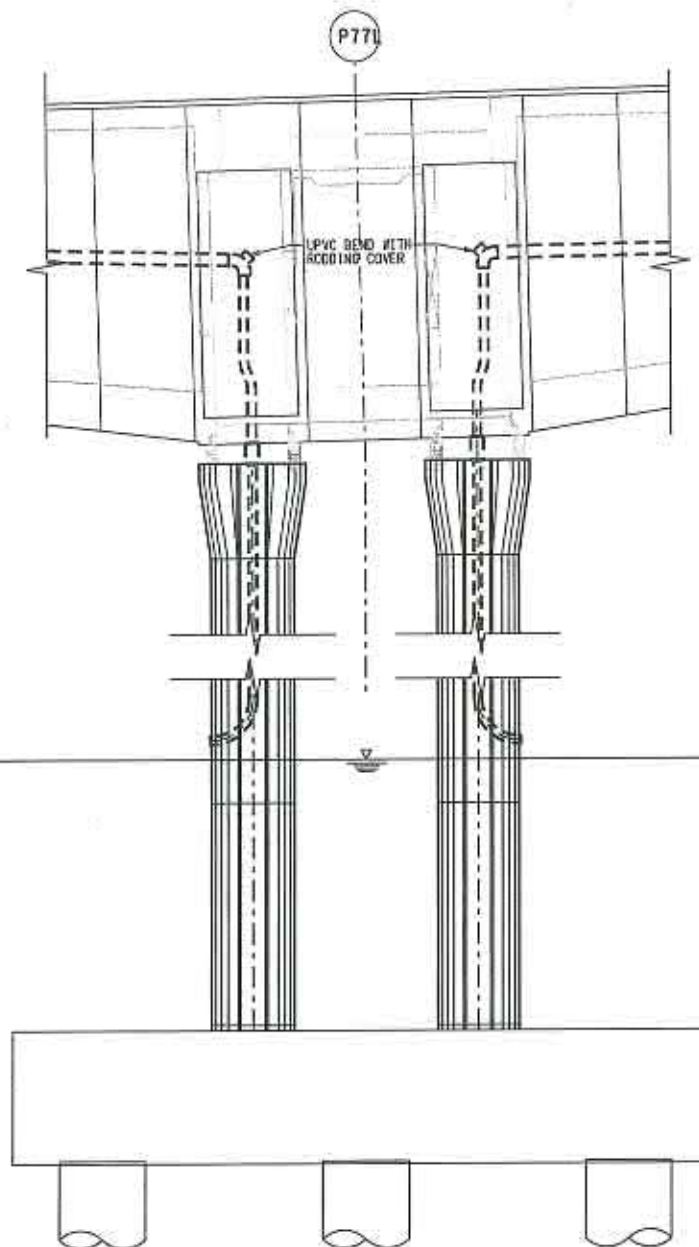

SECTION 1
 SCALE 1:100

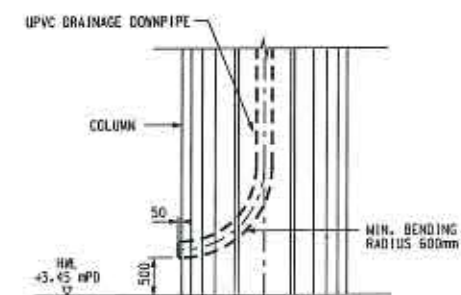

DETAIL A
 SCALE 1:50

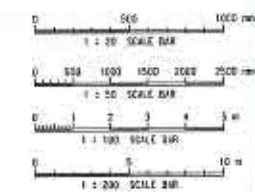

- NOTES:**
- FOR GENERAL NOTES REFER TO DRG NO. HKLR9/MMH/AB/PW/DN/00000.
 - THIS TYPE OF DRAINAGE ARRANGEMENT IS APPLICABLE TO PIER P77.
 - PIER STARTERS AT CROSSHEAD SHALL BE CRANKED TO ALLOW CARRIER DRAIN PASSING THROUGH TO THE PIER AREA IF NECESSARY.
 - THIS SIZE OF CARRIER DRAIN REFER TO DRG NO. HKLR9/MMH/AB/PW/DN/00001-00009.
 - THE SIZE OF DOWNPIPE REFER TO DRG NO. HKLR9/MMH/AB/PW/DN/00200.

As-built Drawing
 Prepared by the Contractor "DCV/M"
 Mr. W.K. Poon (Project Director) 11/01/19 Date
 Checked by the Designer "Mott MacDonald"
 Dr. H.T. Cheng (Designer) 11/01/19 Date
 Endorsed by the Design Checker "AECOM"
 Mr. Charles Luk (Design Checker) 11/01/19 Date

Contractor

 Designer - China Harbour - VSL Joint Venture 廣東-中國港務-施維利聯合
Contractor's Designer

Mott MacDonald
YWL Engineering


Consultant

ARUP 奧雅納工程顧問
 Ove Arup & Partners Hong Kong Limited
Contract No. HY/2011/09
Hong Kong - Zhuhai - Macao Bridge
Hong Kong Link Road
Section Between HKSAR Boundary and Scenic Hill


TYPICAL DRAINAGE DOWNPIPE ARRANGEMENT - PIER P77

Drawing no.	HKLR9/MMH/AB/PW/DN/00106	Rev.	-
Design	AL	SHL	HTC
Check	AL	SHL	HTC
Scale	1:100 (IN A1)	Sheet no.	4 OF 13
File name	HKLR9_MMH_AB_PW_DN_00106.dgn	Copyright	RESERVED


路政署
HIGHWAYS DEPARTMENT

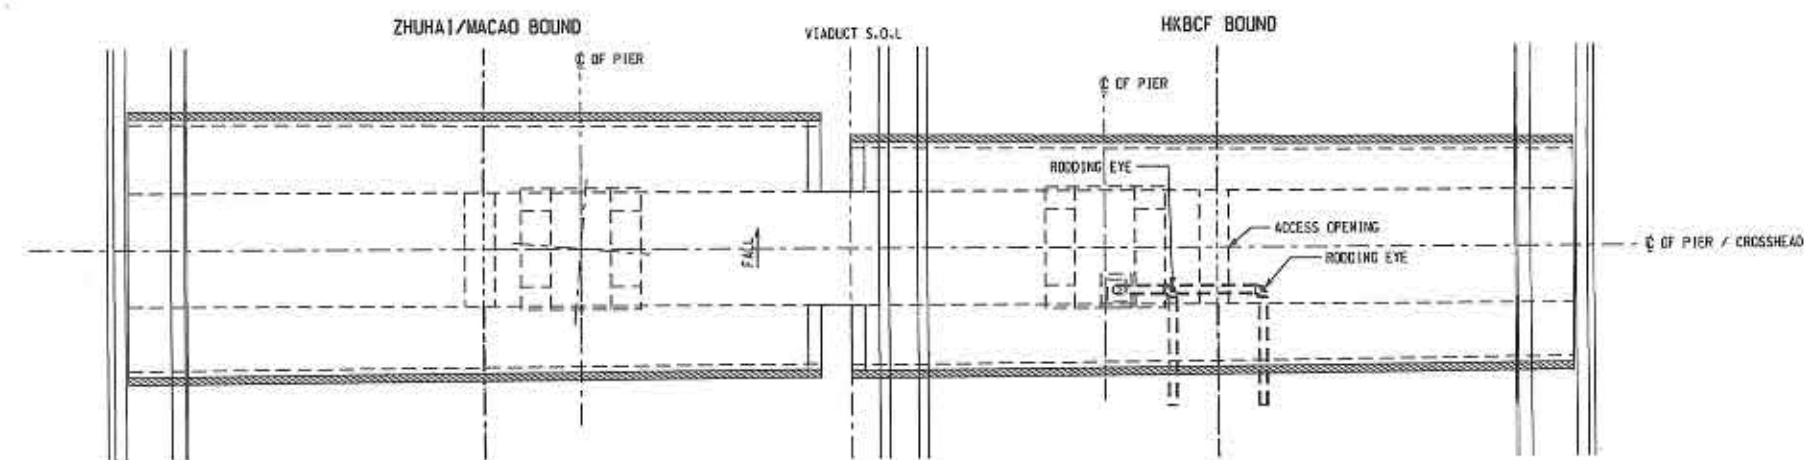


PLAN
SCALE 1:100

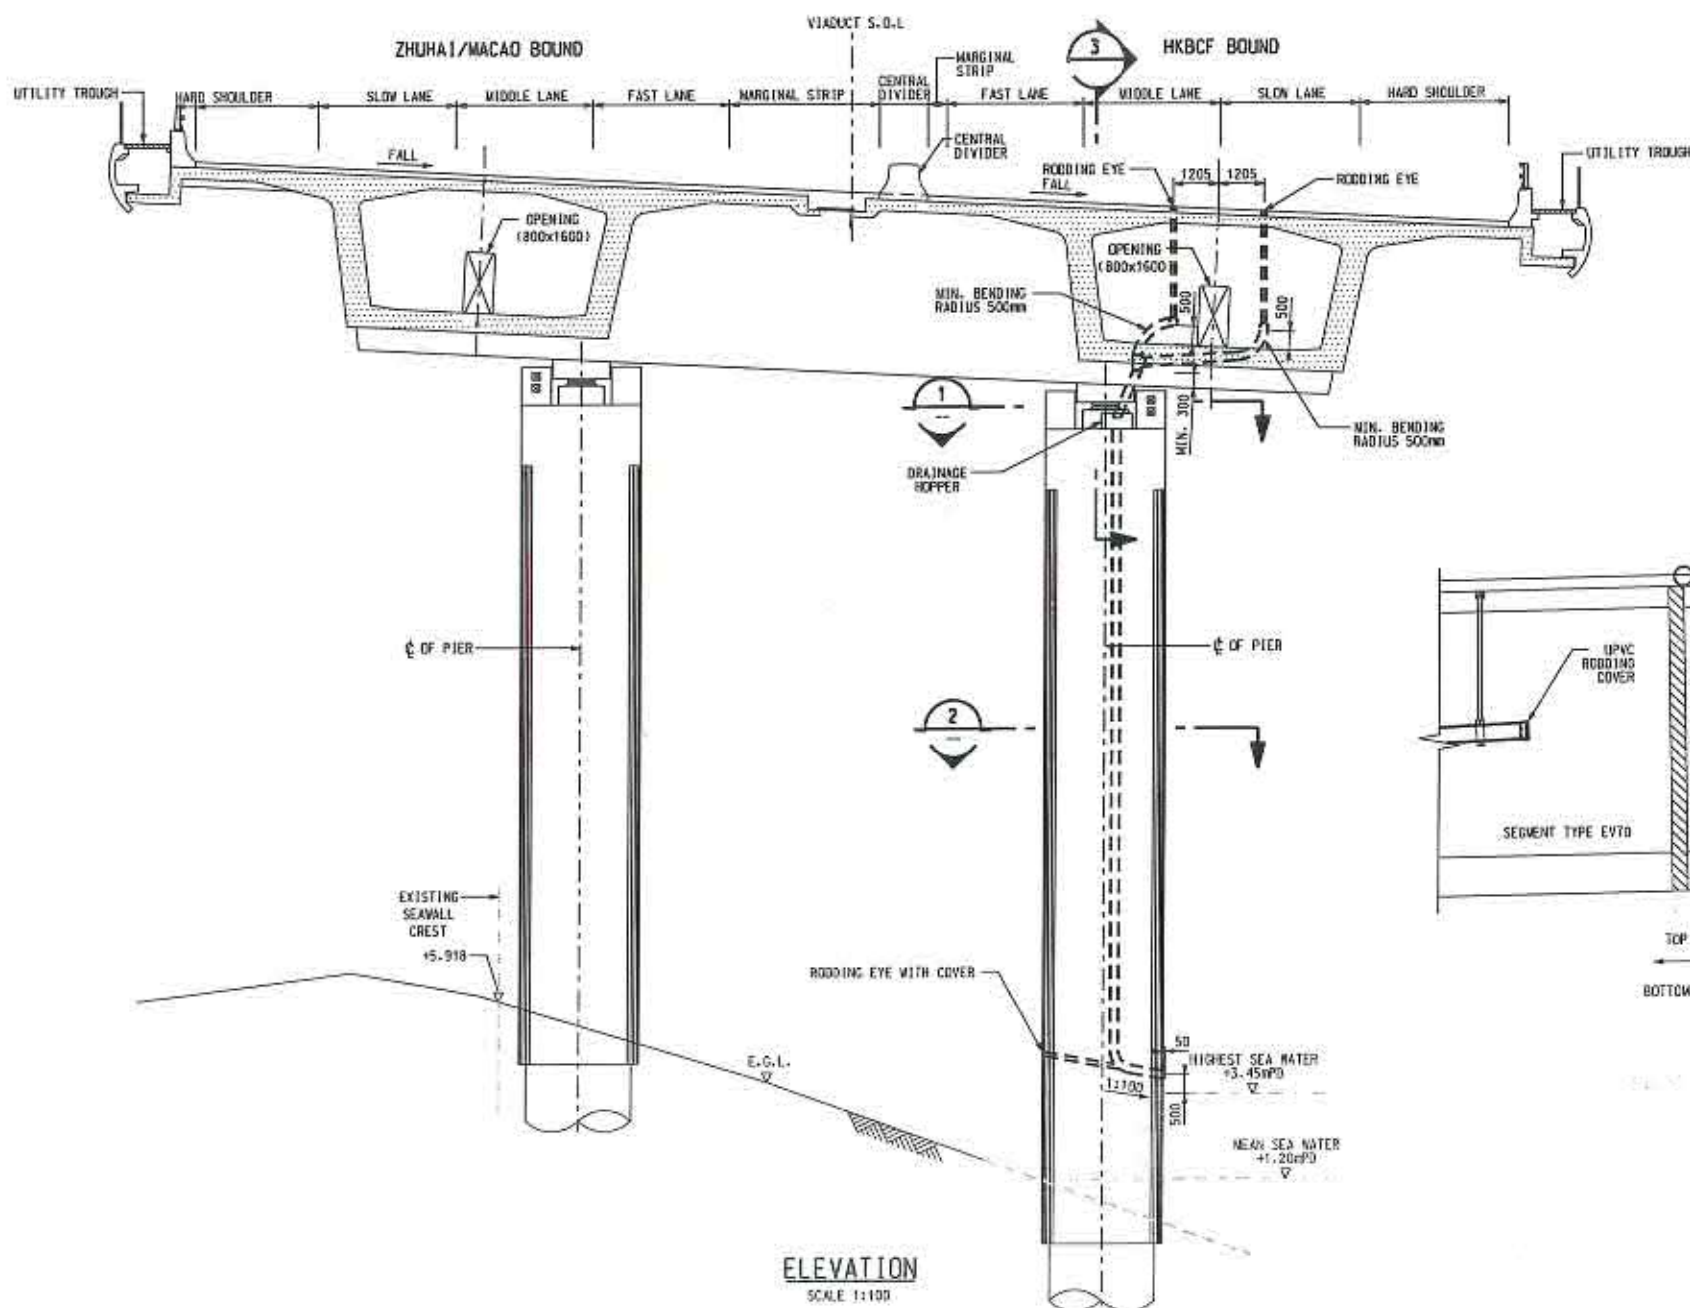


ELEVATION
SCALE 1:100

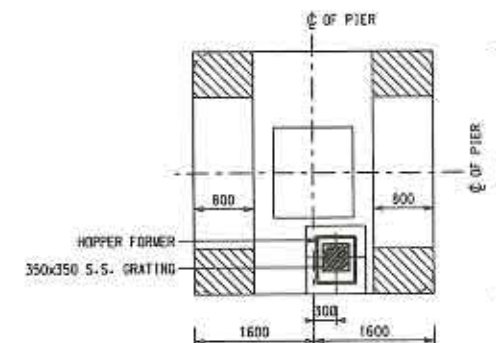


SECTION 1
SCALE 1:50

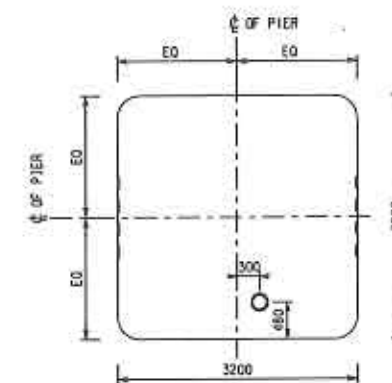

SECTION 2
SCALE 1:50

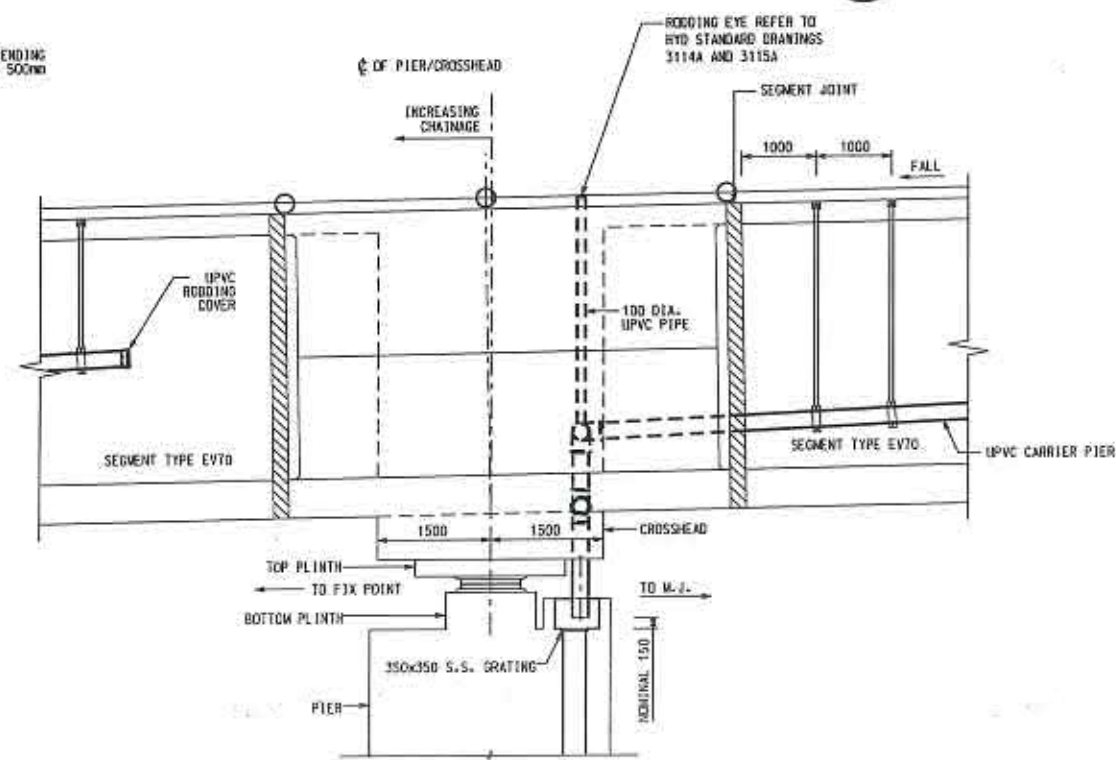

SECTION 3
SCALE 1:50

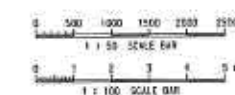

NOTES:

- FOR GENERAL NOTES REFER TO DRG. NO. HKLR9/MMH/AB/PW/DN/00000.
- THIS TYPE OF DRAINAGE IS APPLICABLE TO PIER P85.
- DETAILS OF RODDING EYE REFERS TO DRG. NO. HKLR9/MMH/AB/PW/DN/00125.
- DETAILS OF DRAINAGE HOPPER REFERS TO DRG. NO. HKLR9/MMH/AB/PW/DN/00130.
- PIER STARTERS AT CROSSHEAD SHALL BE CRANKED TO ALLOW CARRIER DRAIN PASSING THROUGH TO THE PIER AREA IF NECESSARY.
- THIS SIZE OF CARRIER DRAIN REFER TO DRG. NO. HKLR9/MMH/AB/PW/DN/00001-00009.
- THE SIZE OF DOWNPIPE REFER TO DRG. NO. HKLR9/MMH/AB/PW/DN/00200.

As-built Drawing
 Prepared by the Contractor "DCVJV"
 Mr. V.K. Foon
 (Project Director)
 Checked by the Designer "Mott MacDonald"
 Dr. H.T. Cheng
 (Designer)
 Endorsed by the Design Checker "AECOM"
 Mr. Charles Luk
 (Design Checker)



Contractor's Designer
Mott MacDonald
YWL Engineering

ARUP
 奧雅納工程顧問
 Ove Arup & Partners Hong Kong Limited

Contract No. HY/2011/09
 Hong Kong - Zhuhai - Macao Bridge
 Hong Kong Link Road
 Section Between HKSAR Boundary and Scenic Hill


TYPICAL DRAINAGE
 DOWNPIPE ARRANGEMENT - PIER P85

Drawing No.	HKL9/MMH/AB/PW/DN/00107	Rev.	
Author	AL	Checked	HTC
Drawn	AS SHOWN (IN AT)	Approved	
Drawn By	HKL9	Sheet No.	5 OF 13
File Name	HKL9_MMH_AB_PW_DN_00107.dgn		

路政署
 HIGHWAYS DEPARTMENT



SCALE 1:100

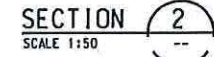

- delete

Prepared by the Contractor "DCVJV"

Mr. W.K.Poon
(Project Director)

Checked by the Designer "Mott MacDonald"

Dr. H.T.Cheng
(Designer)

Endorsed by the Design Checker "AECOM"

.....
 Ir. Charles Luk
 (Design Checker)

Mott MacDonald **YWL Engineering**

ARUP 奧雅納工程顧問
Ove Arup & Partners Hong Kong Limited

Contract No. HY/2011/09
Hong Kong - Zhuhai - Macao Bridge
Hong Kong Link Road
Section Between HKSAR Boundary
and Scenic Hill

TYPICAL DRAINAGE
DOWNPIPE ARRANGEMENT
PIER P88, P89, P90,
P94, P95, P97 AND P10

Item	Item	Assigned	Site
1	2	3	4

AL	PL	HTC	
----	----	-----	--

AS SHOWN (IN A1)	APPROVED	-
------------------	----------	---

CO No.	HKLR9	Sheet No.	6 OF
--------	-------	-----------	------

FILE NO. HK189 10/11 AB PM 00 00108 doc





COPYRIGHT RESERVED

Source: <http://www.fishbase.org>

路政署


HIGHWAYS DEPARTMENT

HIGHWAYS DEPAR

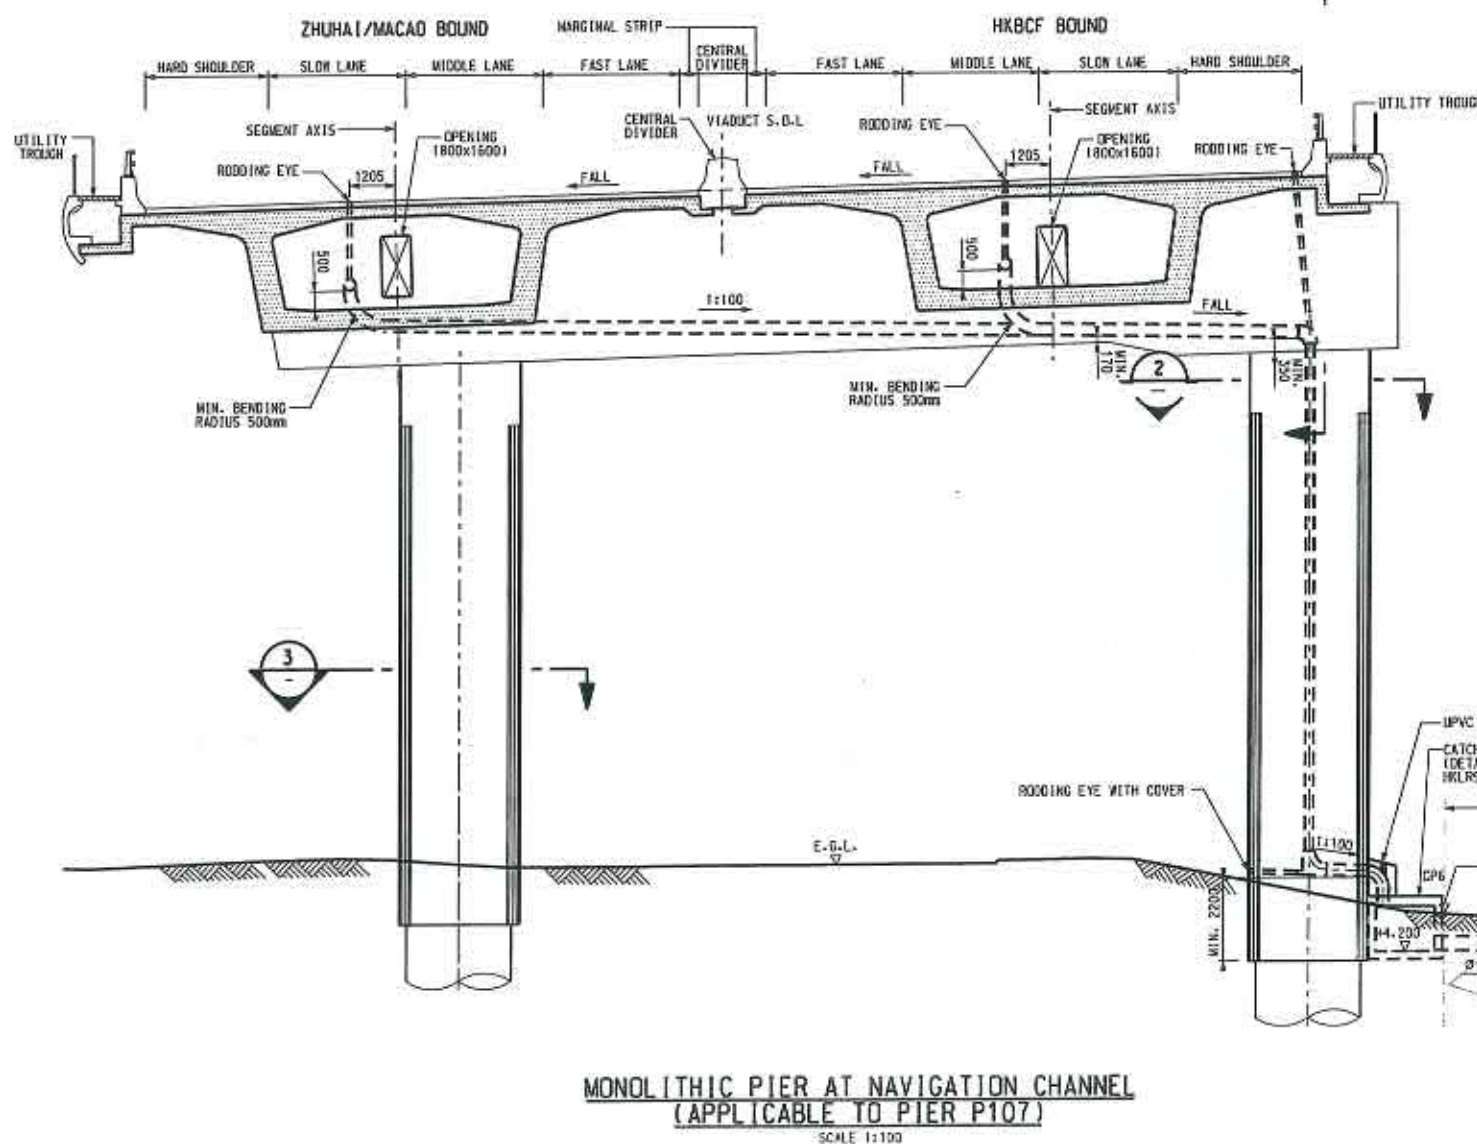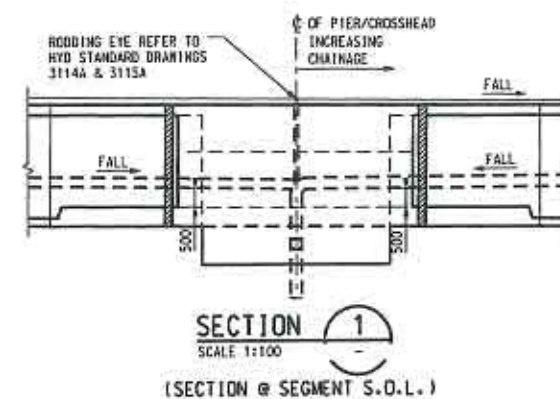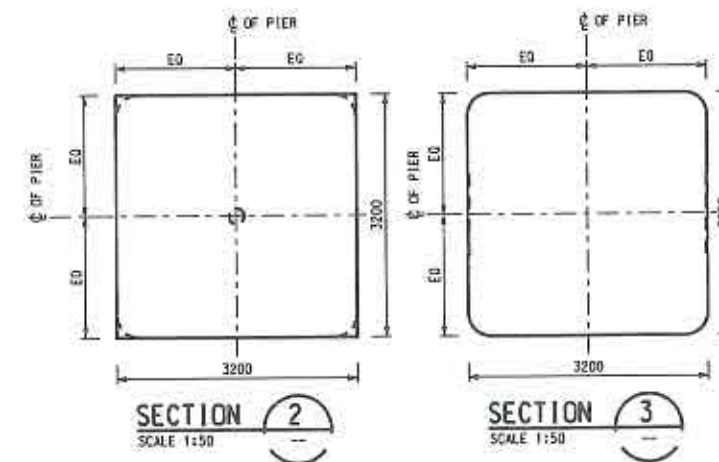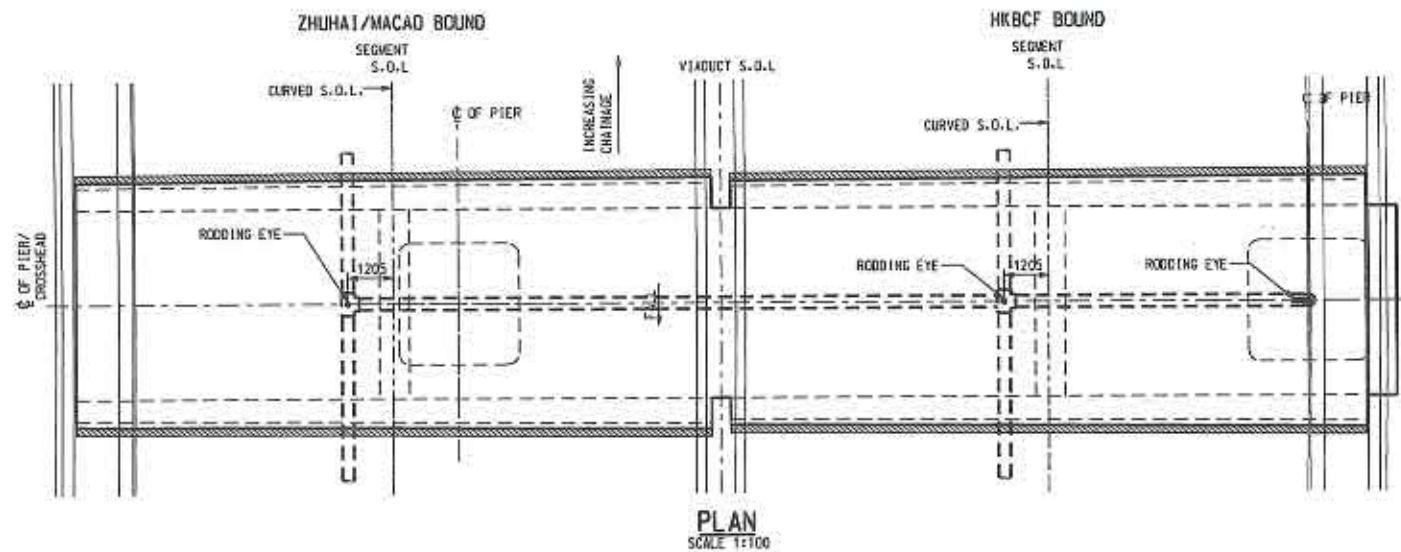

NOTES:

- FOR GENERAL NOTES REFER TO DRG. NO. HKLR9/MMH/AB/PW/DN/00000.
- THIS TYPE OF DRAINAGE IS APPLICABLE TO PIER P107.
- FOUNDATION: FOUNDATION OF MANHOLE VARIES WITH SITE CONDITION. THEREFORE, IT SHOULD BE DETERMINED ON SITE BY THE ENGINEER.
- COVER AND FRAME NOT SHOWN ON PLAN FOR CLARITY.
- DETAILS OF RODDING EYE REFER TO DRG. NO. HKLR9/MMH/AB/PW/DN/00125.
- PIER STARTERS AT CROSSHEAD SHALL BE CRANKED TO ALLOW CARRIER DRAIN PASSING THROUGH TO THE PIER AREA IF NECESSARY.
- THIS SIZE OF CARRIER DRAIN REFER TO DRG. NO. HKLR9/MMH/AB/PW/DN/00001-00009.
- THE SIZE OF DOWNPIPE REFER TO DRG. NO. HKLR9/MMH/AB/PW/DN/00200.

As-built Drawing

Prepared by the Contractor "DCV JV"

Mr. W.K. Poon
 (Project Director)
 Date 11/01/19

Checked by the Designer "Mott MacDonald"

Dr. H.T. Cheng
 (Designer)
 Date 11/01/19

Endorsed by the Design Checker "AECOM"

Mr. Charles Luk
 (Design Checker)
 Date 11/01/19








Contract No. HY/2011/09
 Hong Kong - Zhuhai - Macao Bridge
 Hong Kong Link Road
 Section Between HKSAR Boundary and Scenic Hill

TYPICAL DRAINAGE DOWNPIPE ARRANGEMENT - PIER P107

Project No.	HKL9/MMH/AB/PW/DN/00109	Rev.	-
Author	AL	Checked	PL
Drawn	AS SHOWN (IN A1)	Reviewed	HTC
Scale	HKL9	Sheet No.	7 OF 13
File name	HKL9_MMH_AB_PW_DN_00109.dgn		



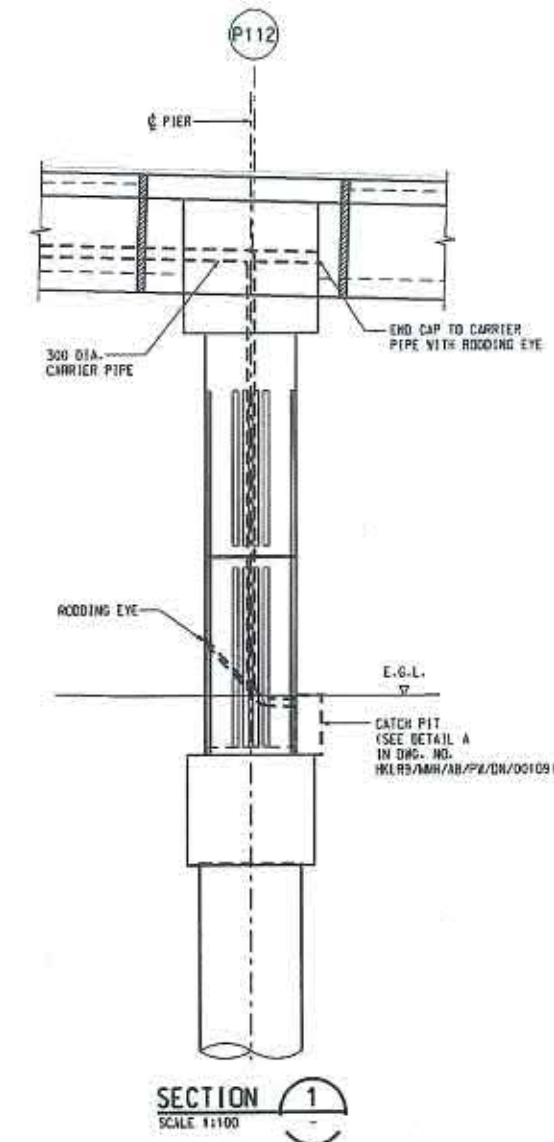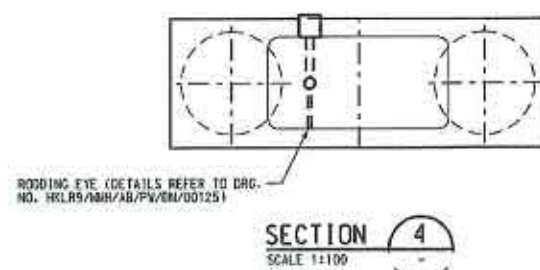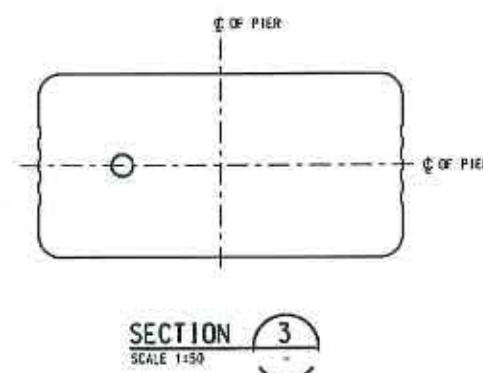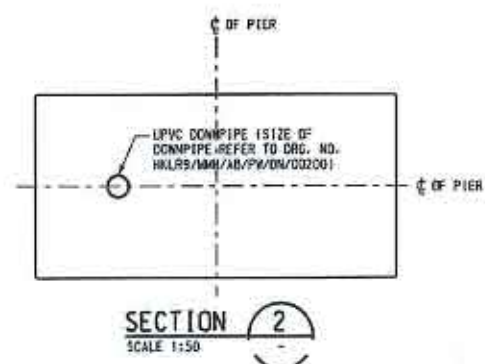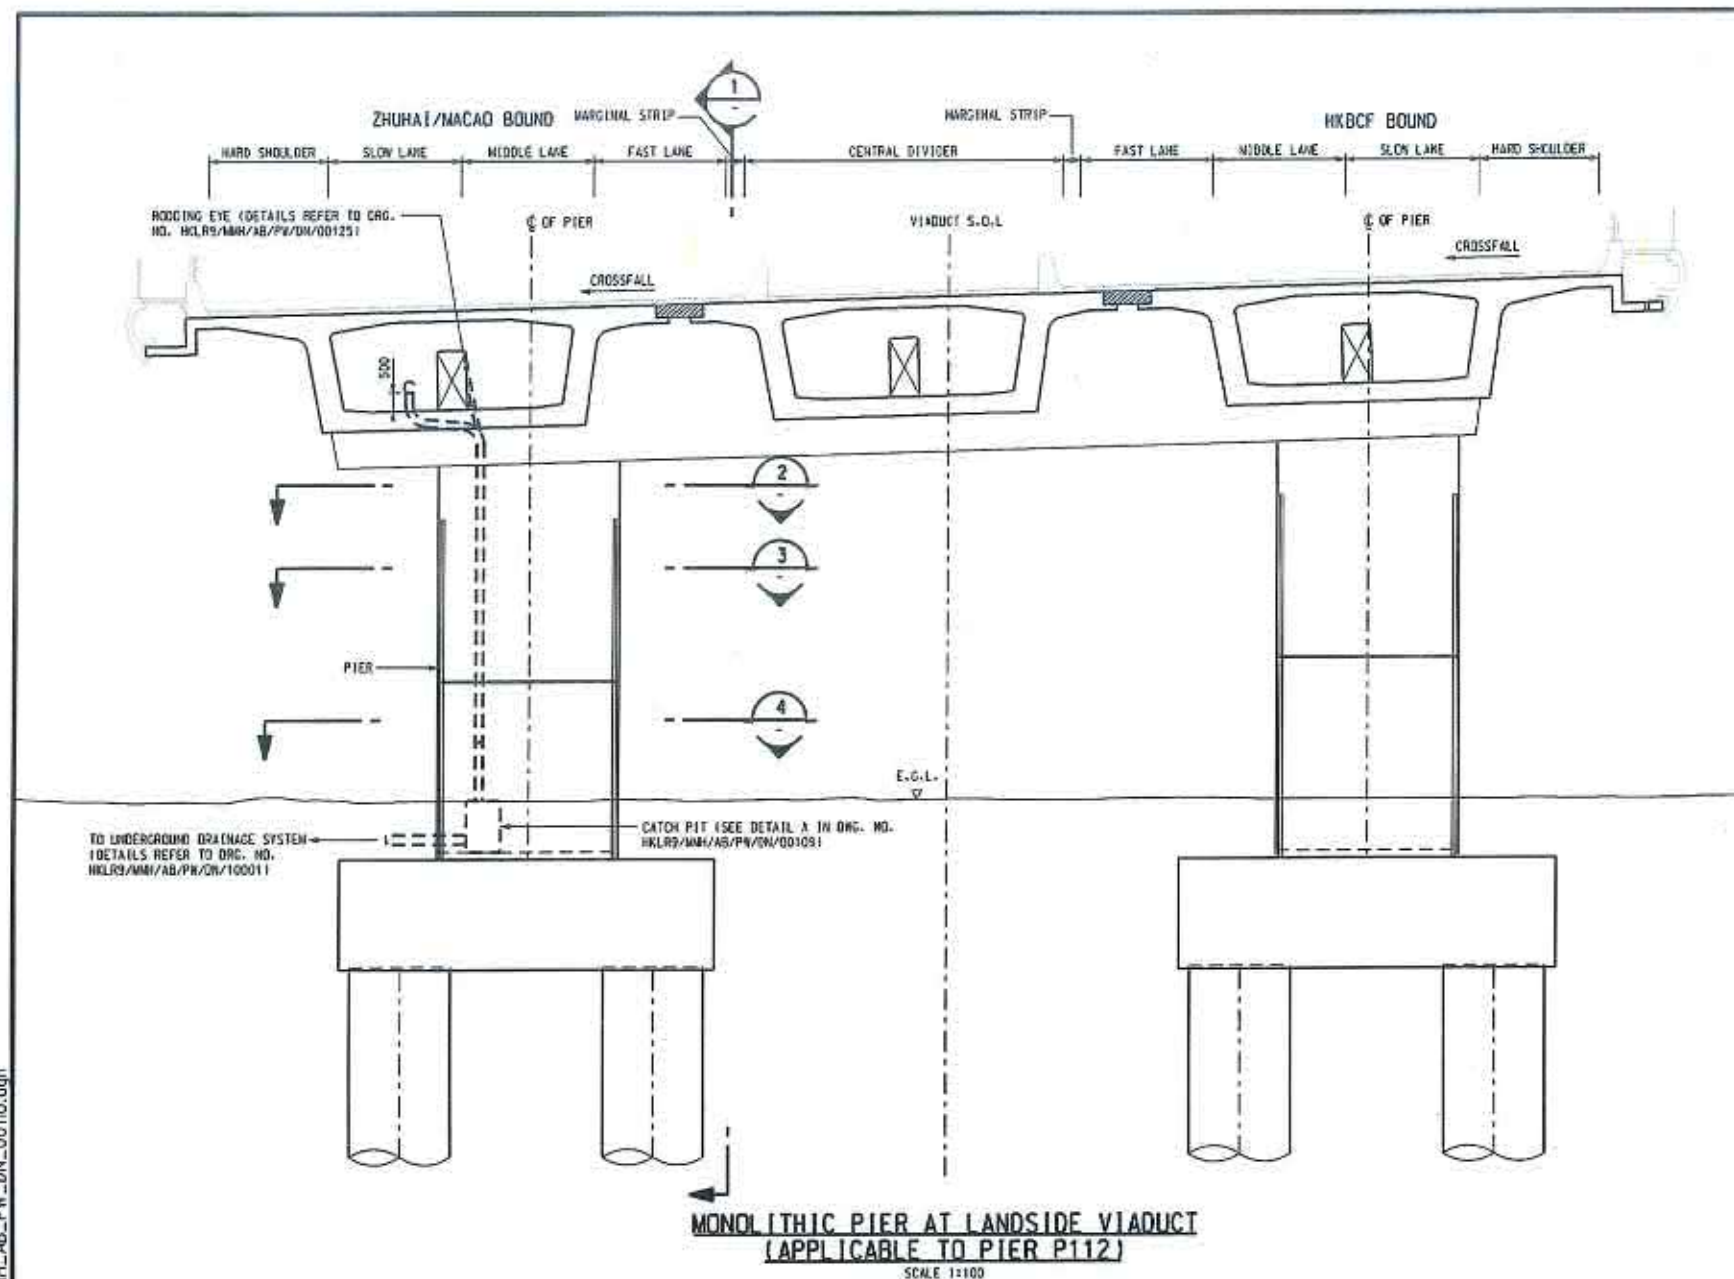

NOTES:

- FOR GENERAL NOTES REFER TO DRG. NO. HKLR9/MMH/AB/PW/DN/00000.
- THIS TYPE OF DRAINAGE IS APPLICABLE TO PIER P.112.


As-built Drawing	
Prepared by the Contractor "DCVJV"	
Mr. W.K. Poon (Project Director)	11/01/19 Date
Checked by the Designer "Mott MacDonald"	
Dr. H.T. Cheng (Designer)	11/01/19 Date
Endorsed by the Design Checker "AECOM"	
Mr. Charles Luk (Design Checker)	11/01/19 Date




Contract No. HY/2011/09
 Hong Kong - Zhuhai - Macao Bridge
 Hong Kong Link Road
 Section Between HKSAR Boundary
 and Scenic Hill


TYPICAL DRAINAGE
 DOWNPIPE ARRANGEMENT

HKLR9/MMH/AB/PW/DN/00110	
AL	PL
HTC	AS-03/1.1
AS SHOWN (IN A1)	
HKLR9	8 OF 13
HKLR9_MMH_AB_PW_DN_00110.dgn	
COPYRIGHT RESERVED	

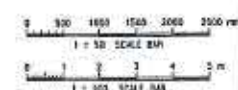


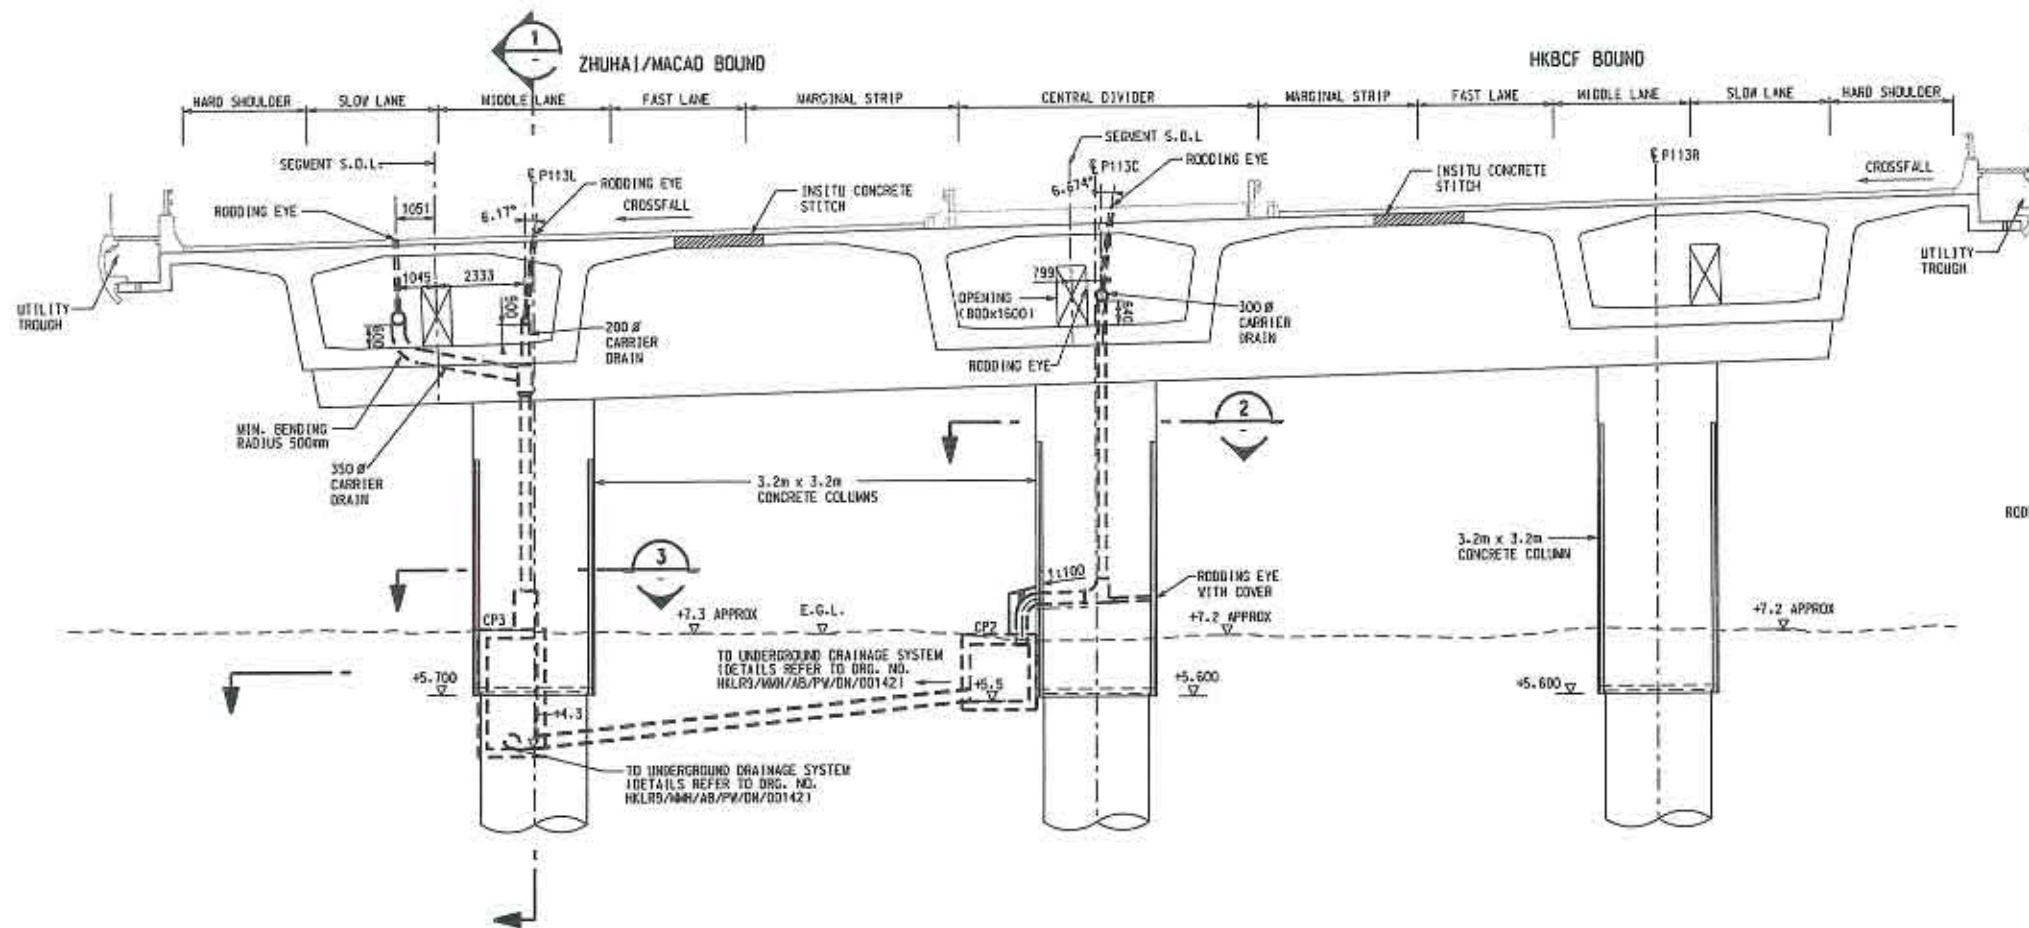


PIER 113
 SCALE 1:100

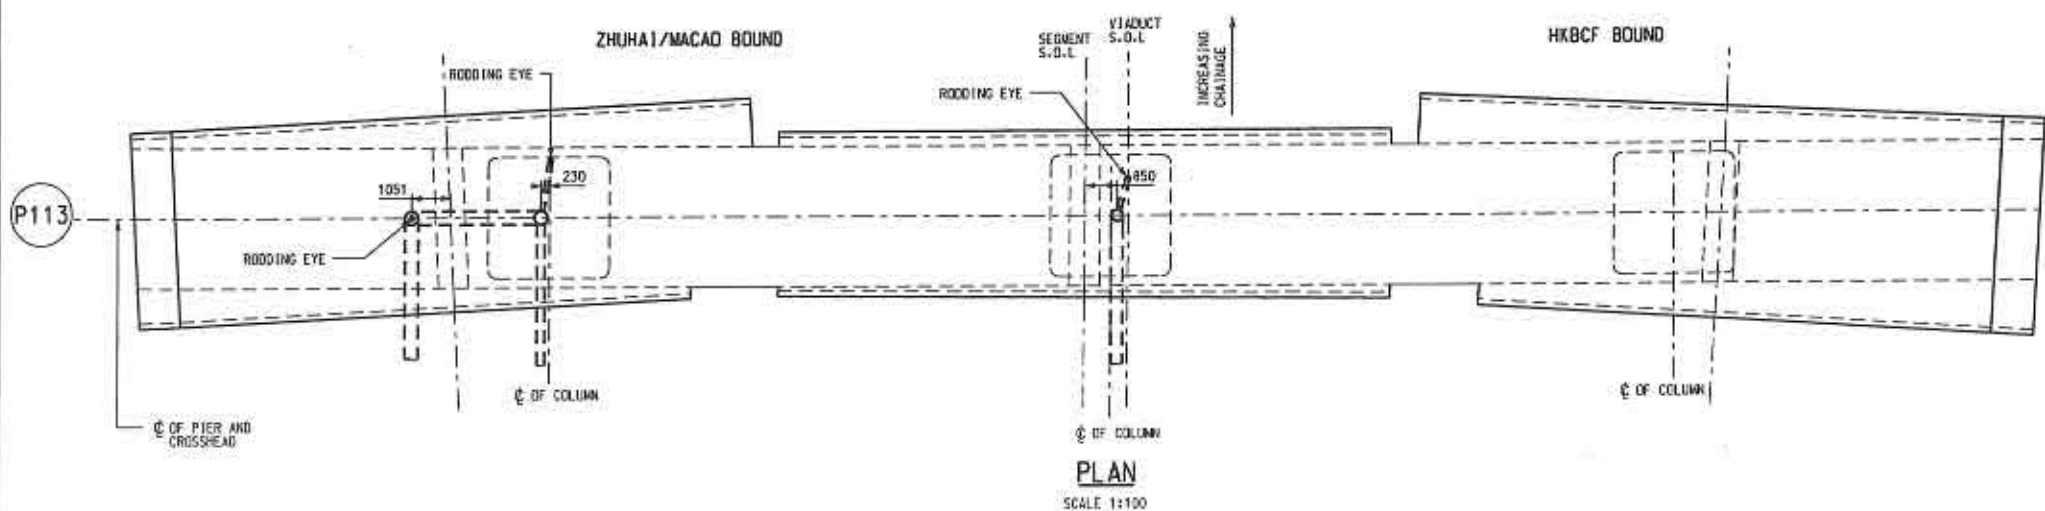


PLAN
 SCALE 1:100

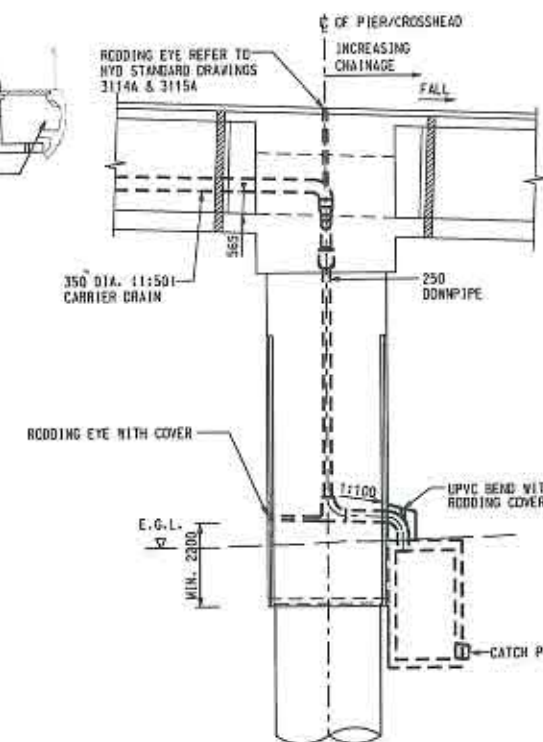


SECTION 1
 SCALE 1:100

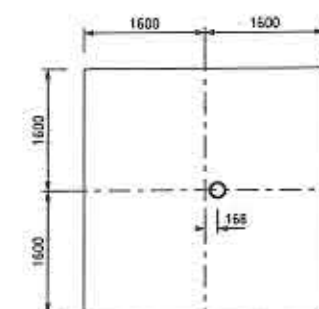

SECTION 2
 SCALE 1:50

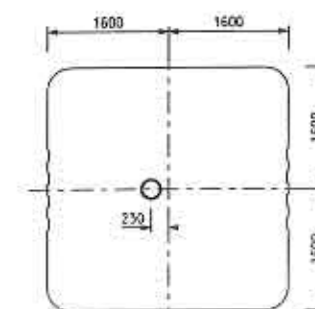

SECTION 3
 SCALE 1:50

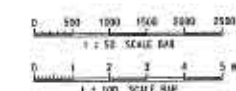

NOTES:

- FOR GENERAL NOTES REFER TO DRG. NO. HKLR9/MMH/AB/PW/DN/00000.
- THIS TYPE OF DRAINAGE IS APPLICABLE TO PIER P.113.
- DETAILS OF RODDING EYE PETERS TO DRG. NO. HKLR9/MMH/AB/PW/DN/00125.
- PIER STARTERS AT CROSSHEAD SHALL BE CRANKED TO ALLOW CARRIER DRAIN PASSING THROUGH TO THE PIER AREA IF NECESSARY.
- THIS SIZE OF CARRIER DRAIN REFER TO DRG. NO. HKLR9/MMH/AB/PW/DN/00001-00009.
- THE SIZE OF DOWNPIPE REFER TO DRG. NO. HKLR9/MMH/AB/PW/DN/00200.

As-built Drawing
 Prepared by the Contractor "DCV/J"

Mr. Wai C. Poon 11/01/19
 (Project Director) Date

Checked by the Designer "Mott MacDonald"

Dr. H.T. Cheng 11/01/19
 (Designer) Date

Endorsed by the Design Checker "AECOM"

Mr. Charles Luk 11/01/19
 (Design Checker) Date

DRAGAGES - CHINA PARTNER - VSL Joint Venture
 拖格 - 中國夥伴 - 維斯利聯合建築師事務所

Mott MacDonald
 Mott MacDonald Engineering

ARUP
 奧雅納工程顧問
 Ove Arup & Partners Hong Kong Limited

Contract No. HY/2011/09
Hong Kong - Zhuhai - Macao Bridge
Hong Kong Link Road
Section Between HKSAR Boundary and Scenic Hill







TYPICAL DRAINAGE
DOWNPIPE ARRANGEMENT - PIER P113

Drawing No.	HKLR9/MMH/AB/PW/DN/00111	Rev.	-
Author	AL	Shr	HTC
Check	AS SHOWN (IN A1)	Approved	AS-BUILT
Drawn by	HKLR9	Sheet No.	9 OF 13

File name: HKLR9_MMH_AB_PW_DN_00111.dgn
 COPYRIGHT RESERVED

路政署
HIGHWAYS DEPARTMENT

Printed by : 6/4/2019
Filename : D:\HKLR9\As-Built drawings\DDA 20\Final As-Built drawings\Part 1\HKLR9_MMH_AB_PW_DN_00112.dgn

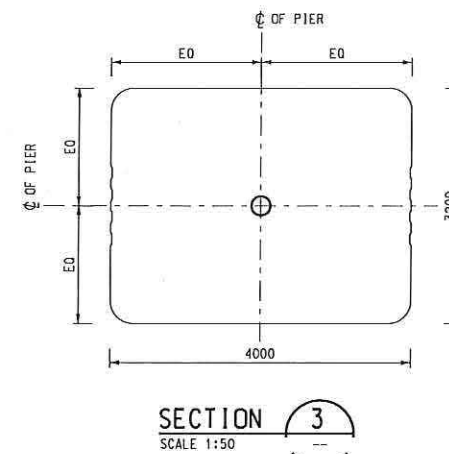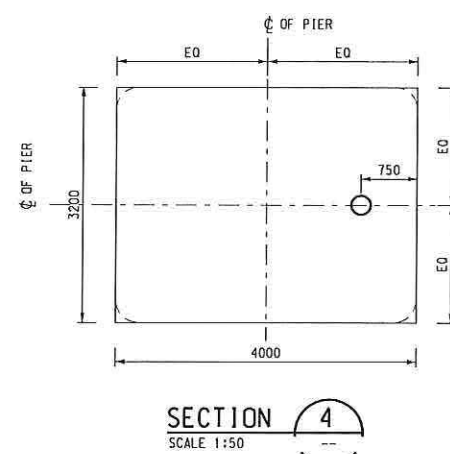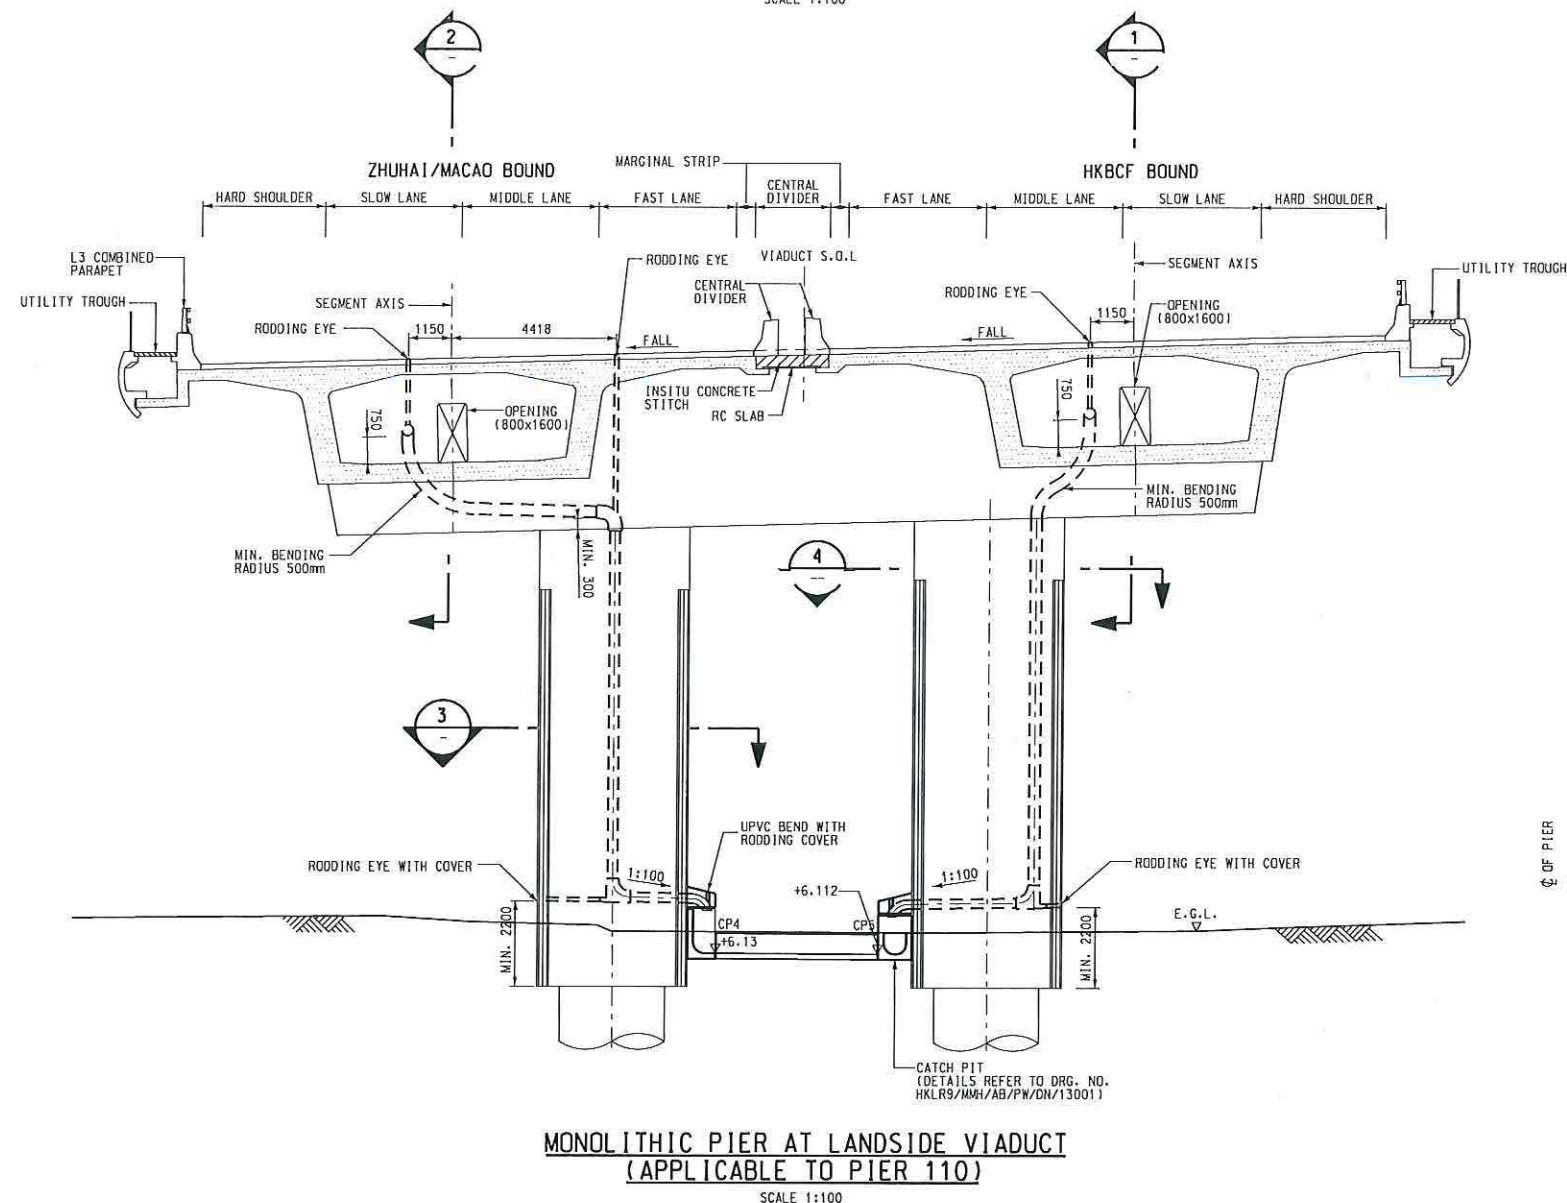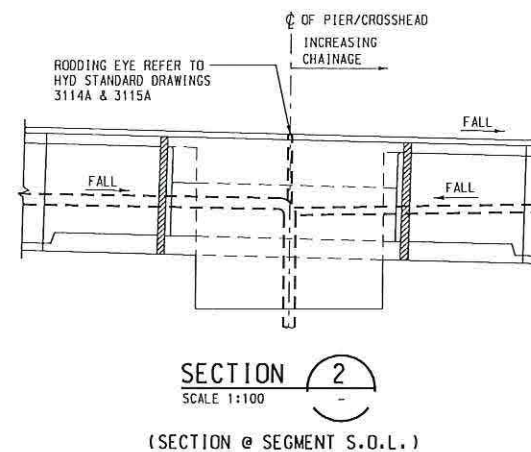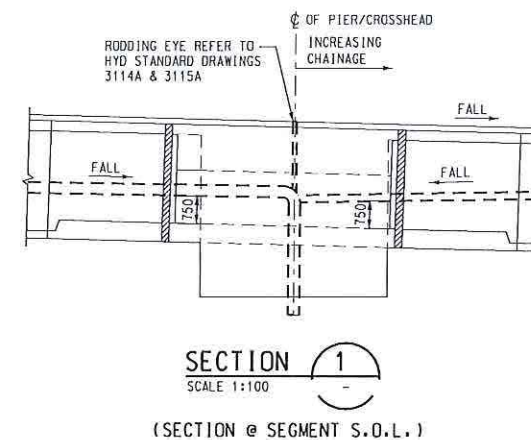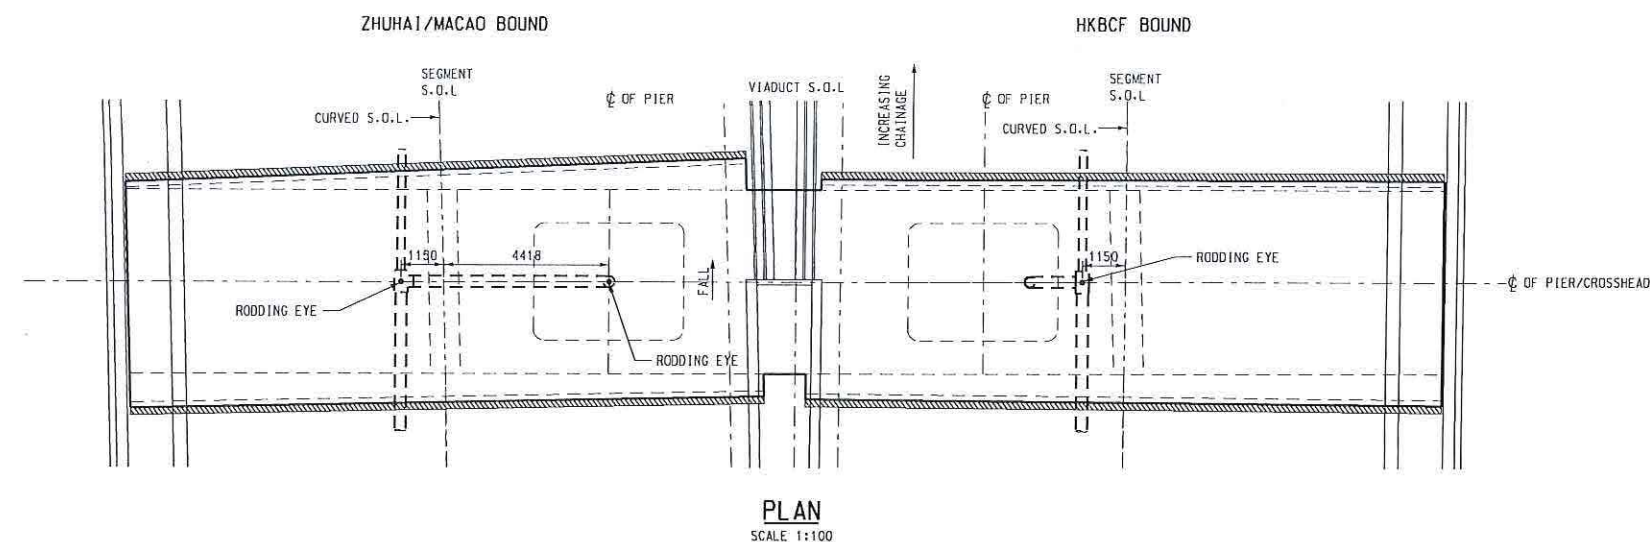

NOTES:

1. FOR GENERAL NOTES REFER TO DRG. NO. HKLR9/MMH/AB/PW/DN/00000.
2. THIS TYPE OF DRAINAGE ARRANGEMENT IS APPLICABLE TO PIER P110.
3. DETAILS OF RODDING EYE RETERS TO DRG. NO. HKLR9/MMH/AB/PW/DN/00125.
4. PIER STARTERS AT CROSSHEAD SHALL BE CRANKED TO ALLOW CARRIER DRAIN PASSING THROUGH TO THE PIER AREA IF NECESSARY.
5. THIS SIZE OF CARRIER DRAIN REFER TO DRG. NO. HKLR9/MMH/AB/PW/DN/00001-00009.
6. THE SIZE OF DOWNPIPE REFER TO DRG. NO. HKLR9/MMH/AB/PW/DN/00200.

As-built Drawing

Prepared by the Contractor "DCVJV"

Mr. W.K.Poon 04JUN2019
(Project Director) Date

Checked by the Designer "Mott MacDonald"

Dr. H.T.Cheng 04JUN2019
(Designer) Date

Endorsed by the Design Checker "AECOM"

Mr. Charles Luk 04JUN2019
(Design Checker) Date

Main Contractor



Contractor's Designer



Consultant

ARUP 奧雅納工程顧問
Ove Arup & Partners Hong Kong Limited

Project Title

Contract No. HY/2011/09
Hong Kong - Zhuhai - Macao Bridge
Hong Kong Link Road
Section Between HKSAR Boundary
and Scenic Hill

Drawing Title

TYPICAL DRAINAGE
DOWNPIPE ARRANGEMENT - PIER P110

Drawing No.

HKLR9/MMH/AB/PW/DN/00112


Design AL Drawn PL Approved HTC Status AS-BUILT

Scale AS SHOWN (IN A1) Approved








Doc No. HKLR9 Sheet No. 10 OF 13

Title name HKLR9_MMH_AB_PW_DN_00112.dgn

COPYRIGHT RESERVED

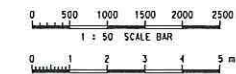

Printed by : 6/4/2019
Filename : D:\HKL9\As-Built drawings\DDA 20\Final As-Built drawings\Part 1\HKL9_MMH_AB_PW_DN_00113.dgn

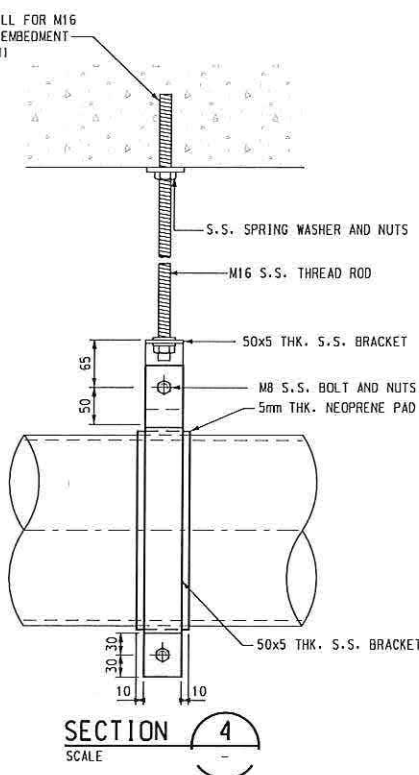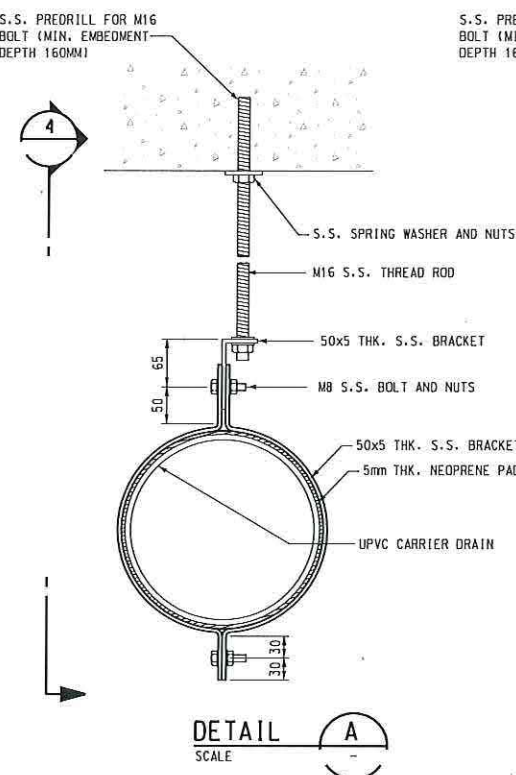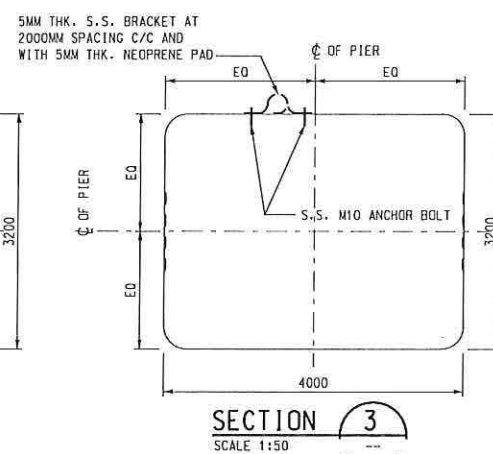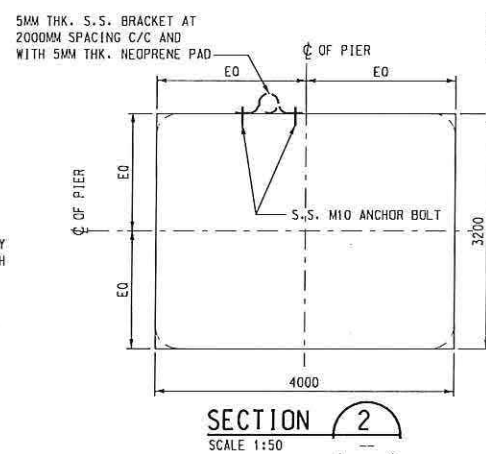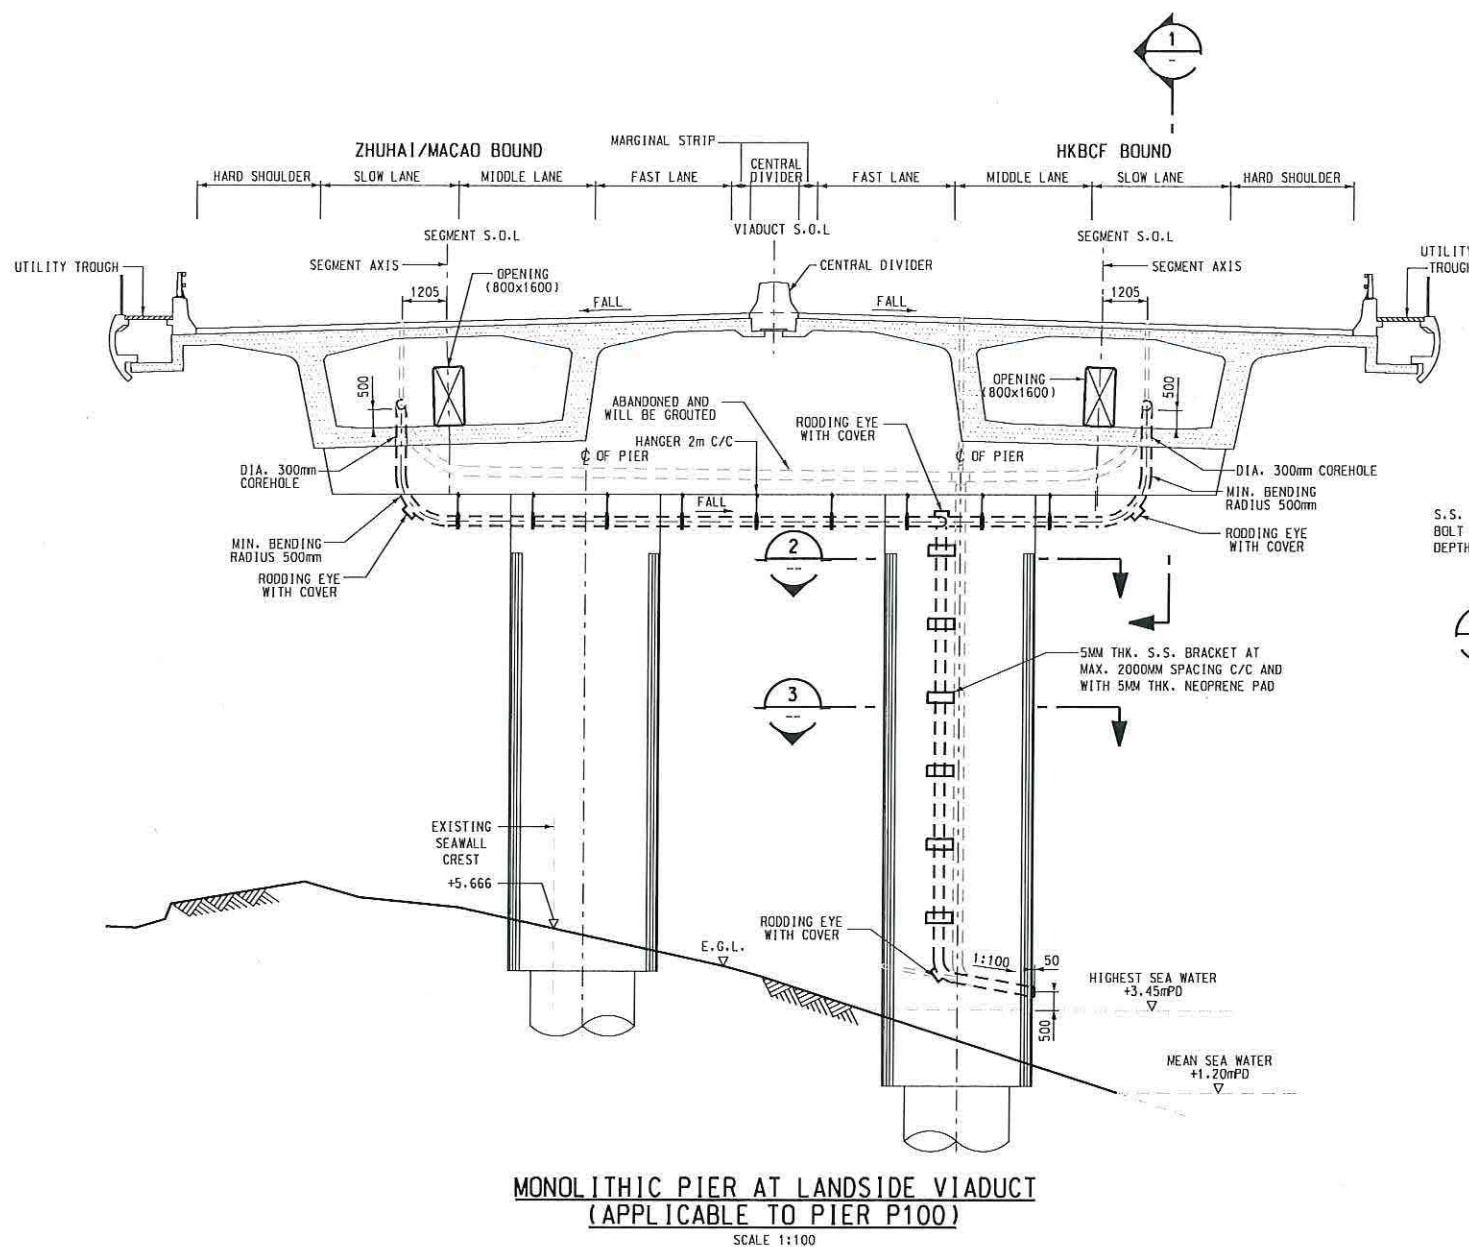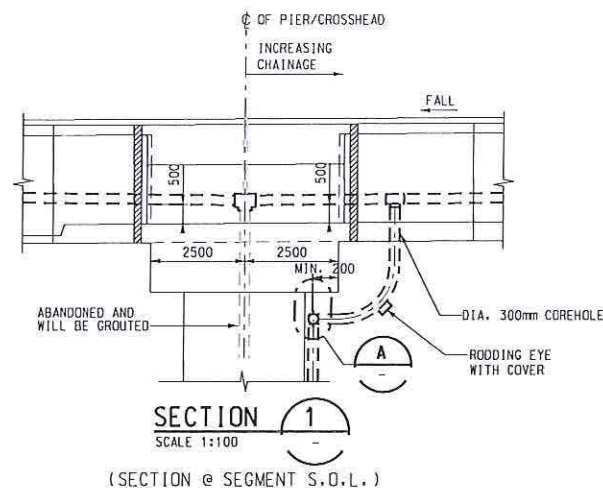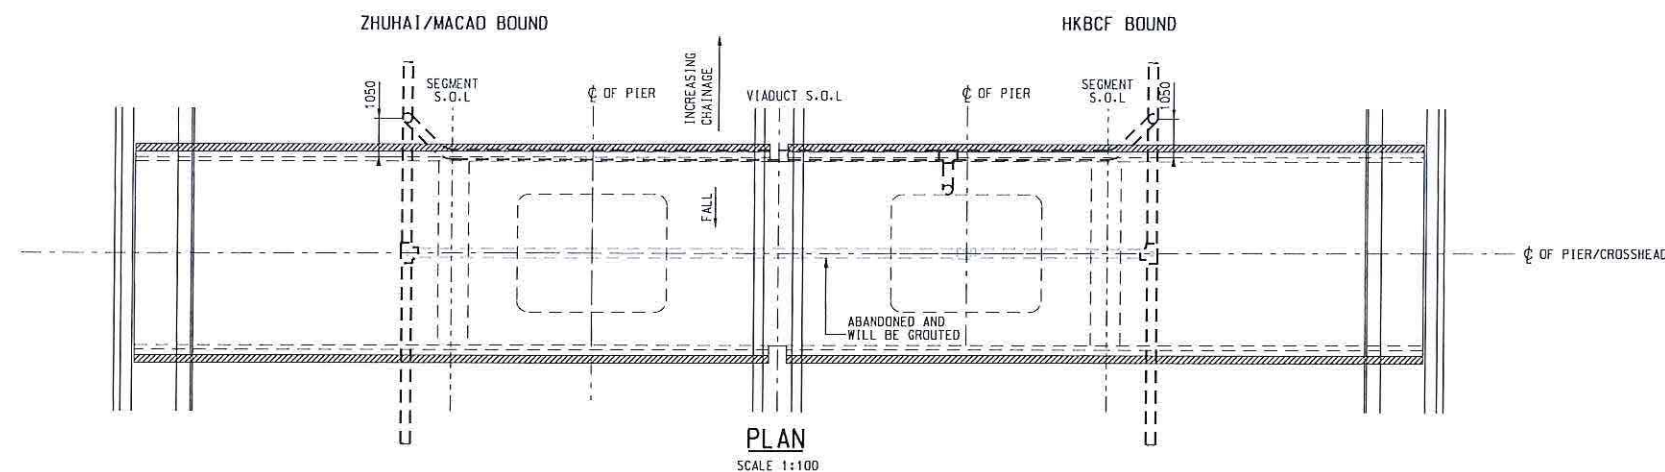

NOTES:

1. FOR GENERAL NOTES, SEE DWG NO. HKLR9/MMH/AB/PW/DN/0000.
2. THIS TYPE OF DRAINAGE ARRANGEMENT IS APPLICABLE TO PIER P100.
3. DETAILS OF RODDING EYE REFERS TO DWG. NO. HKLR9/MMH/AB/PW/DN/00125.
4. PIER STARTERS AT CROSSHEAD SHALL BE CRANKED TO ALLOW CARRIER DRAIN PASSING THROUGH TO THE PIER AREA IF NECESSARY.
5. THIS SIZE OF CARRIER DRAIN REFER TO DRG. NO. HKLR9/MMH/AB/PW/DN/00001-00009.
6. THE SIZE OF DOWNPIPE REFER TO DRG. NO. HKLR9/MMH/AB/PW/DN/00200.

As-built Drawing

Prepared by the Contractor "DCVJV"

04JUN2019

Mr. W.K.Poon

(Project Director)

Checked by the Designer "Mott MacDonald"

04JUN2019

Dr. H.T.Cheng

(Designer)

Endorsed by the Design Checker "AECOM"

04JUN2019

Mr. Charles Luk

(Design Checker)


Client



Contractor's Designer



Consultant

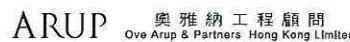

Contract No. HY/2011/09
Hong Kong - Zhuhai - Macao Bridge
Hong Kong Link Road
Section Between HKSAR Boundary and Scenic Hill

**TYPICAL DRAINAGE
DOWNPIPE ARRANGEMENT - PIER P100**

Drawing No. HKLR9/MMH/AB/PW/DN/00113

Design AL PL Approved HTC Status AS-BUILT




Scale AS SHOWN (IN A1) Approved

Job No. HKLR9 Sheet No. 11 OF 13




File Name HKLR9_MMH_AB_PW_DN_00113.dgn

COPYRIGHT RESERVED



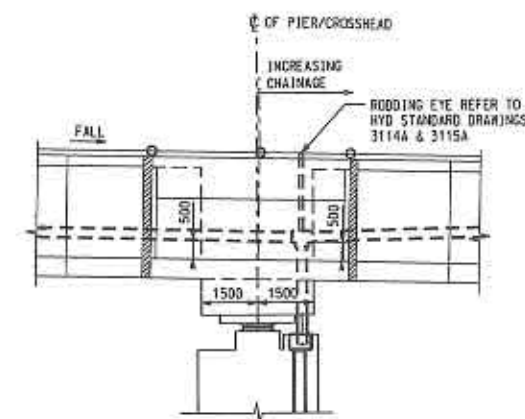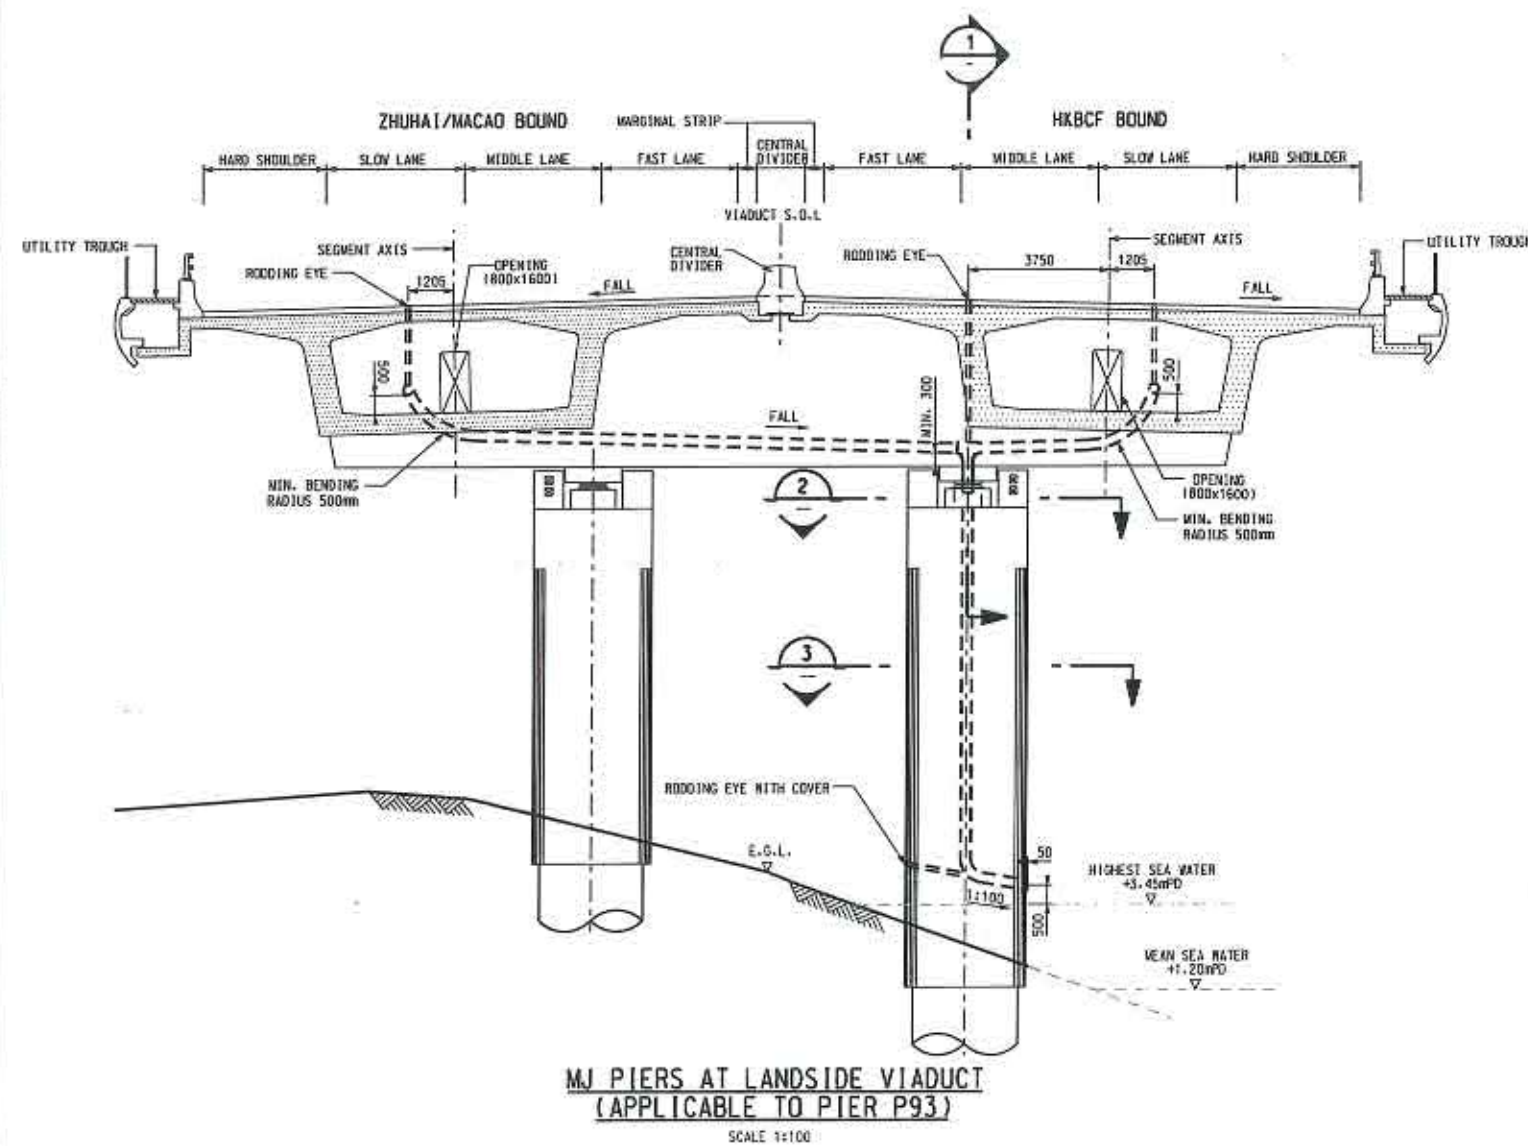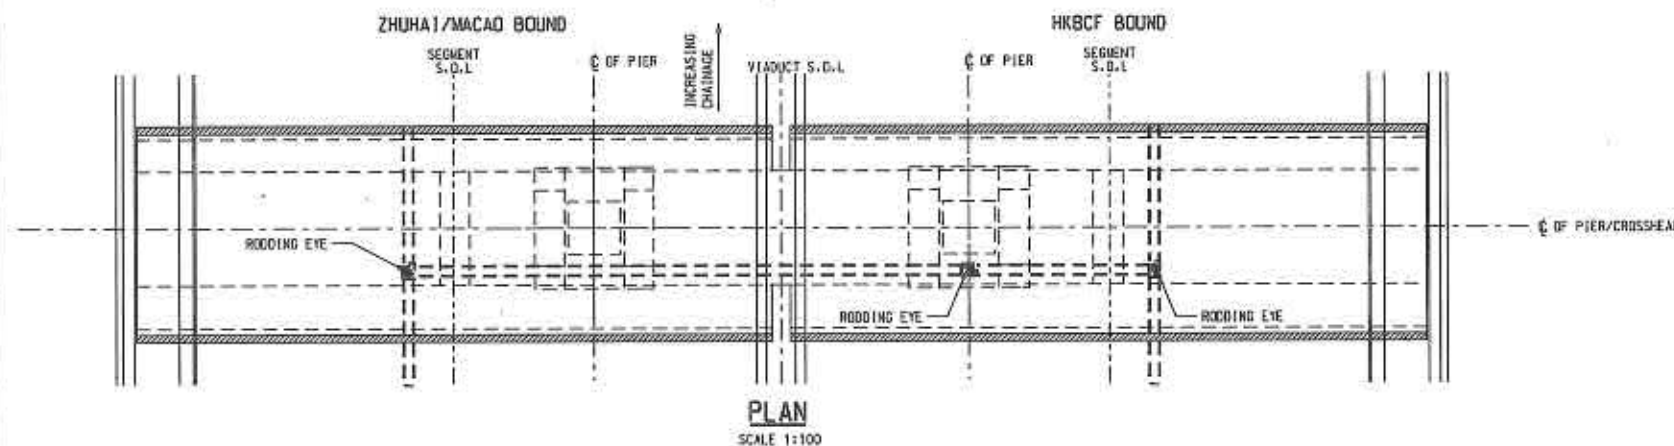

(SECTION @ SEGMENT S.O.L.)

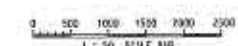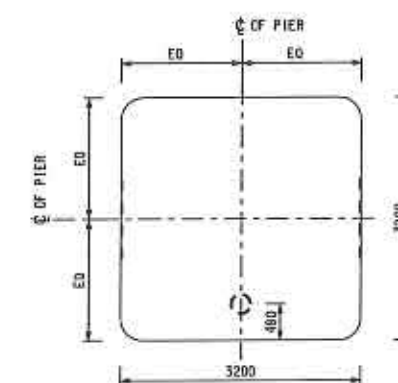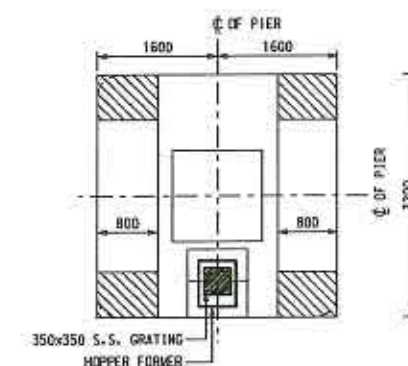

NOTES:

- FOR GENERAL NOTES REFER TO DRG. NO. HKLR9/MMH/AB/PW/DN/00000.
- THIS TYPE OF DRAINAGE ARRANGEMENT IS APPLICABLE TO PIER P93.
- DETAILS OF RODDING EYE PETERS TO DRG. NO. HKLR9/MMH/AB/PW/DN/00125.
- DETAILS OF DRAINAGE HOPPER PETERS TO DRG. NO. HKLR9/MMH/AB/PW/DN/00130.
- PIER STARTERS AT CROSSHEAD SHALL BE CRANKED TO ALLOW CARRIER DRAIN PASSING THROUGH TO THE PIER AREA IF NECESSARY.
- THIS SIZE OF CARRIER DRAIN REFER TO DRG. NO. HKLR9/MMH/AB/PW/DN/00001-00009.
- THE SIZE OF DOWNPIPE REFER TO DRG. NO. HKLR9/MMH/AB/PW/DN/00200.

As-built Drawing
 Prepared by the Contractor "DCVJV"

11/01/19
 Mr. W.K. Foon
 (Project Director)
 Date

11/01/19
 Dr. H.T. Cheng
 (Designer)
 Date

11/01/19
 Mr. Charles Luk
 (Design Checker)
 Date

Checked by the Designer "Mott MacDonald"

Endorsed by the Design Checker "AECOM"



Dragages - China Harbour - VSL Joint Venture 拖格-中國海港-維多利亞





Contract No. HY/2011/09
 Hong Kong - Zhuhai - Macao Bridge
 Hong Kong Link Road
 Section Between HKSAR Boundary
 and Scenic Hill

TYPICAL DRAINAGE DOWNPIPE ARRANGEMENT - PIER P93

Project No.	HKLR9/MMH/AB/PW/DN/00114	Rev.	-
Design	AL	PL	HTC
AS SHOWN (IN A1)			
Drawn By	HKLR9	Sheet No.	12 OF 13

File Name: HKLR9_MMH_AB_PW_DN_00114.dgn
 COPYRIGHT RESERVED



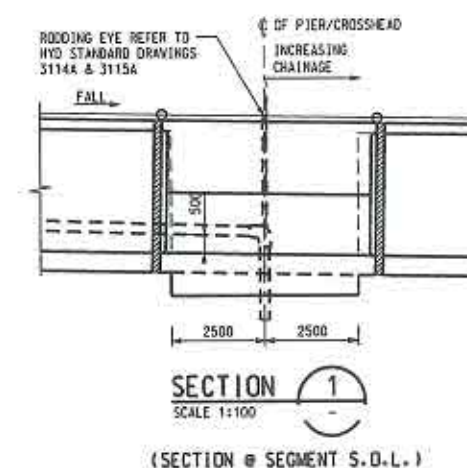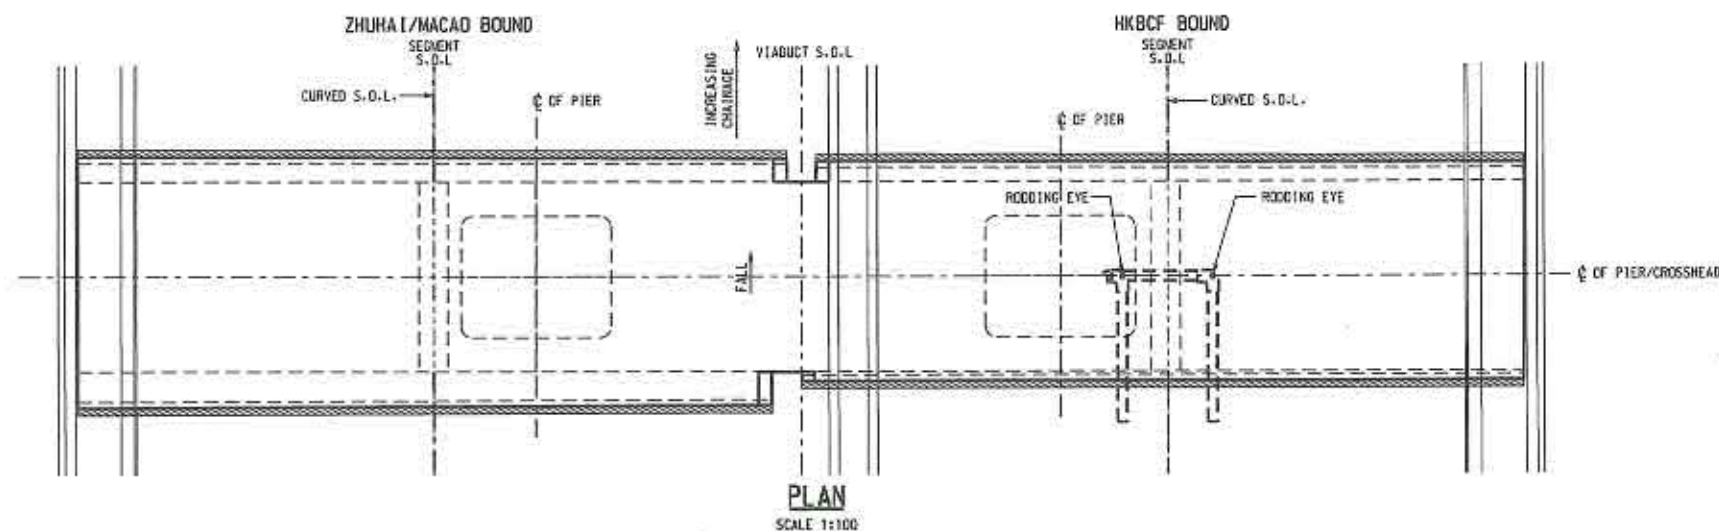

- NOTES:**
- FOR GENERAL NOTES REFER TO DRG. NO. HKLR9/MMH/AB/PW/DN/00000.
 - THIS TYPE OF DRAINAGE ARRANGEMENT IS APPLICABLE TO PIER P86.
 - DETAILS OF RODDING EYE RETERS TO DRG. NO. HKLR9/MMH/AB/PW/DN/00125.
 - PIER STARTERS AT CROSSHEAD SHALL BE CRANKED TO ALLOW CARRIER DRAIN PASSING THROUGH TO THE PIER AREA IF NECESSARY.
 - THIS SIZE OF CARRIER DRAIN REFER TO DRG. NO. HKLR9/MMH/AB/PW/DN/00001-00009.
 - THE SIZE OF DOWNPIPE REFER TO DRG. NO. HKLR9/MMH/AB/PW/DN/00200.

As-built Drawing
 Prepared by the Contractor "DCVJV"

11/01/19
 Mr. W.K. Poon
 (Project Director)

11/01/19
 Dr. H.T. Cheng
 (Designer)

11/01/19
 Mr. Charles Luk
 (Design Checker)

Checked by the Designer "Mott MacDonald"


Endorsed by the Design Checker "AECOM"









Contract No. HY/2011/09
 Hong Kong - Zhuhai - Macao Bridge
 Hong Kong Link Road
 Section Between HKSAR Boundary and Scenic Hill

**TYPICAL DRAINAGE
 DOWNPIPE ARRANGEMENT - PIER P86**

Project No.	HKLR9/MMH/AB/PW/DN/00115	Rev.	-
Author	AL	Check	PL
Design	HTC	Drawn	AS-BUILT
AS SHOWN (IN A1)			
Drawn	HKLR9	Sheet No.	13 OF 13
File Name	HKLR9_MMH_AB_PW_DN_00115.dgn		
COPYRIGHT RESERVED			

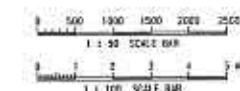

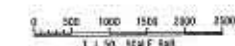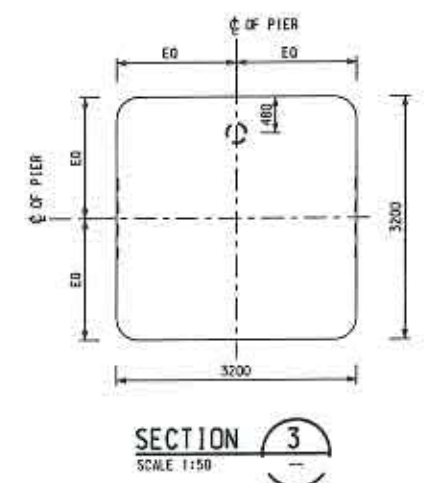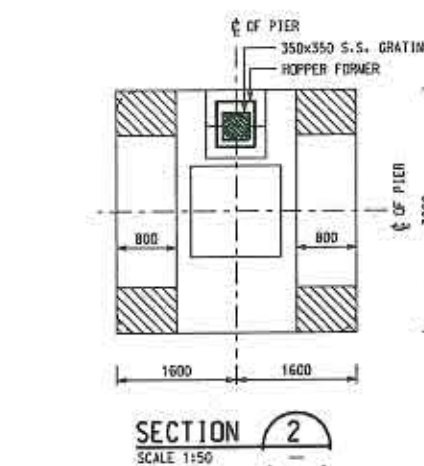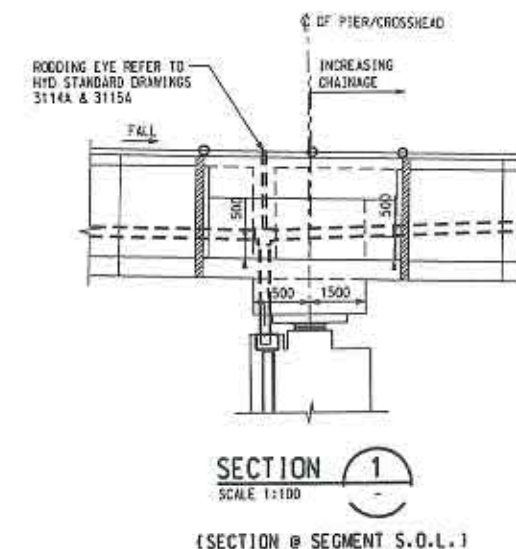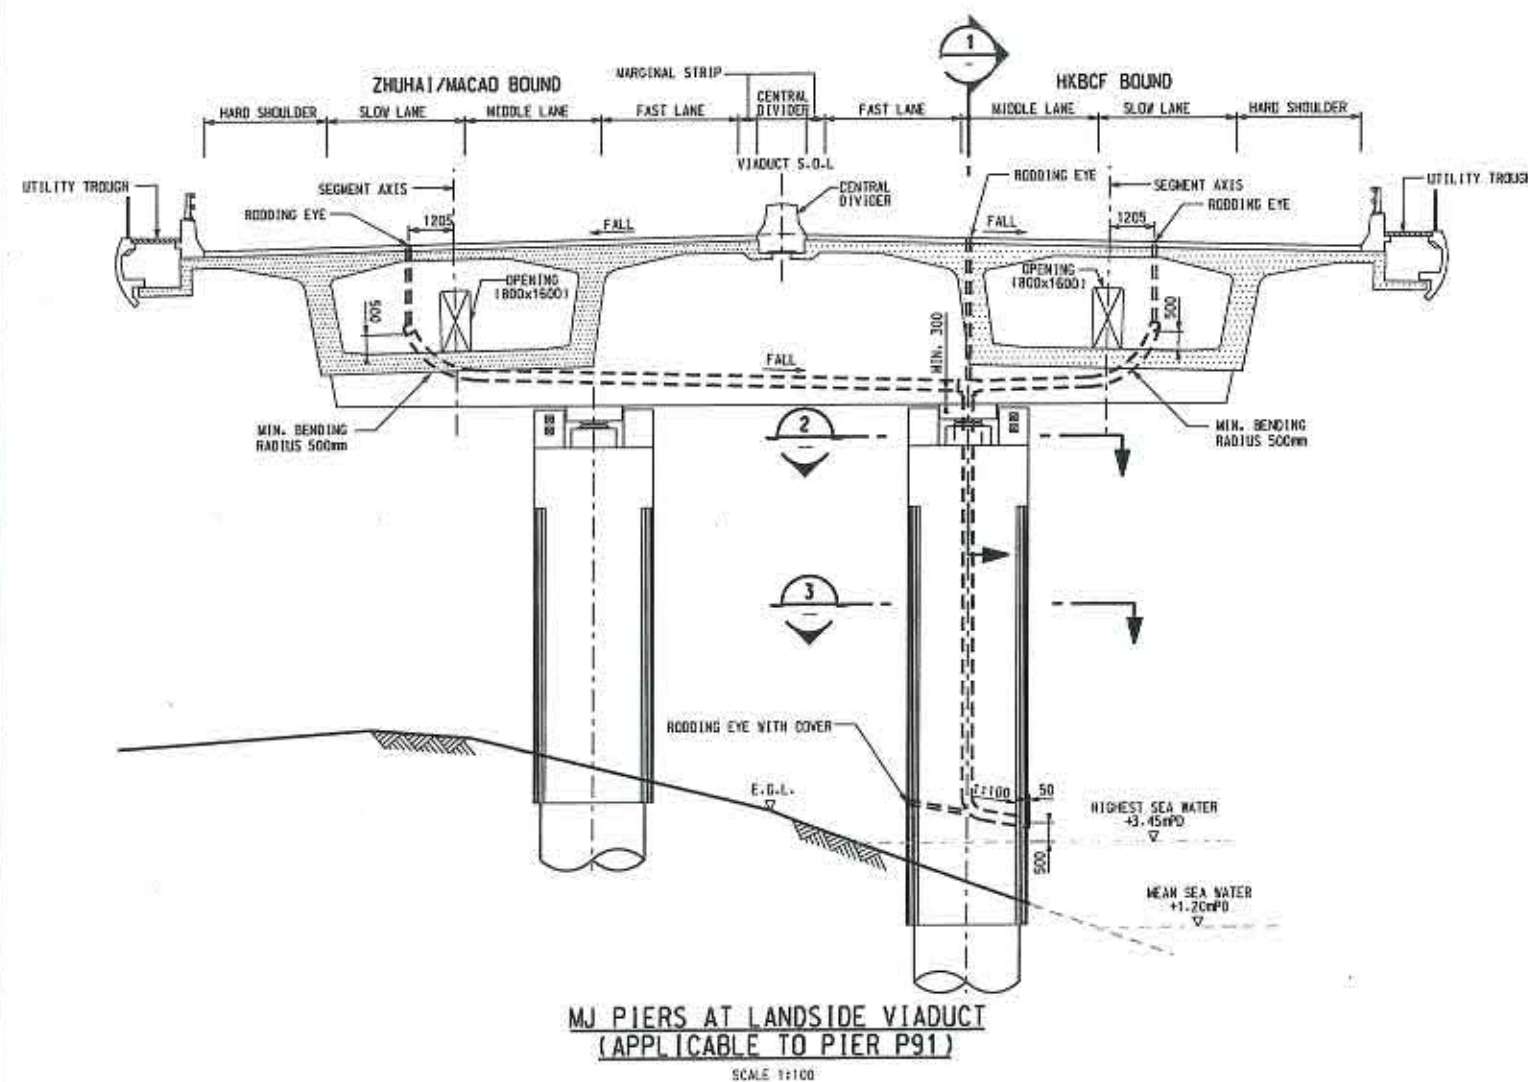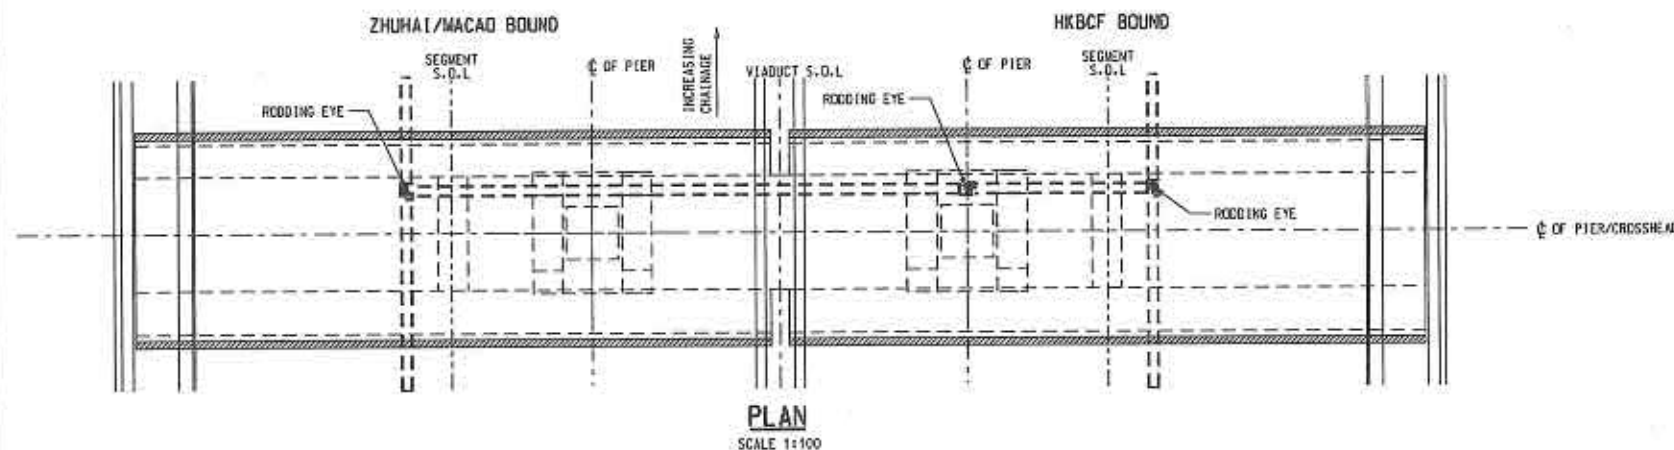

NOTES:

- FOR GENERAL NOTES REFER TO DRG. NO. HKLR9/MMH/AB/PW/DN/00000.
- THIS TYPE OF DRAINAGE ARRANGEMENT IS APPLICABLE TO PIER P91.
- DETAILS OF RODDING EYE RETERS TO DRG. NO. HKLR9/MMH/AB/PW/DN/00125.
- DETAILS OF DRAINAGE HOPPER RETERS TO DRG. NO. HKLR9/MMH/AB/PW/DN/00130.
- PIER STARTERS AT CROSSHEAD SHALL BE CRANKED TO ALLOW CARRIER DRAIN PASSING THROUGH TO THE PIER AREA IF NECESSARY.
- THIS SIZE OF CARRIER DRAIN REFER TO DRG. NO. HKLR9/MMH/AB/PW/DN/00001-00009.
- THE SIZE OF DOWPIPE REFER TO DRG. NO. HKLR9/MMH/AB/PW/DN/00200.

As-built Drawing

Prepared by the Contractor "DCV JV"

Mr. W.K. Loon
(Project Director)
Date 11/01/19

Checked by the Designer "Mott MacDonald"

Dr. H.T. Cheng
(Designer)
Date 11/01/19

Endorsed by the Design Checker "AECOM"

Mr. Charles Luk
(Design Checker)
Date 11/01/19




Contract No. HY/2011/09
 Hong Kong - Zhuhai - Macao Bridge
 Hong Kong Link Road
 Section Between HKSAR Boundary and Scenic Hill

TYPICAL DRAINAGE DOWPIPE ARRANGEMENT - PIER P91


Drawn by:	HKLR9/MMH/AB/PW/DN/00116	Scale:	-
Checked by:	AL	Approved by:	HTC
AS SHOWN (IN A1)	PL	AS-BUILT	
Drawn by:	HKLR9	Sheet No.:	1 OF 1

File name: HKLR9_MMH_AB_PW_DN_00116.dgn
 COPYRIGHT RESERVED





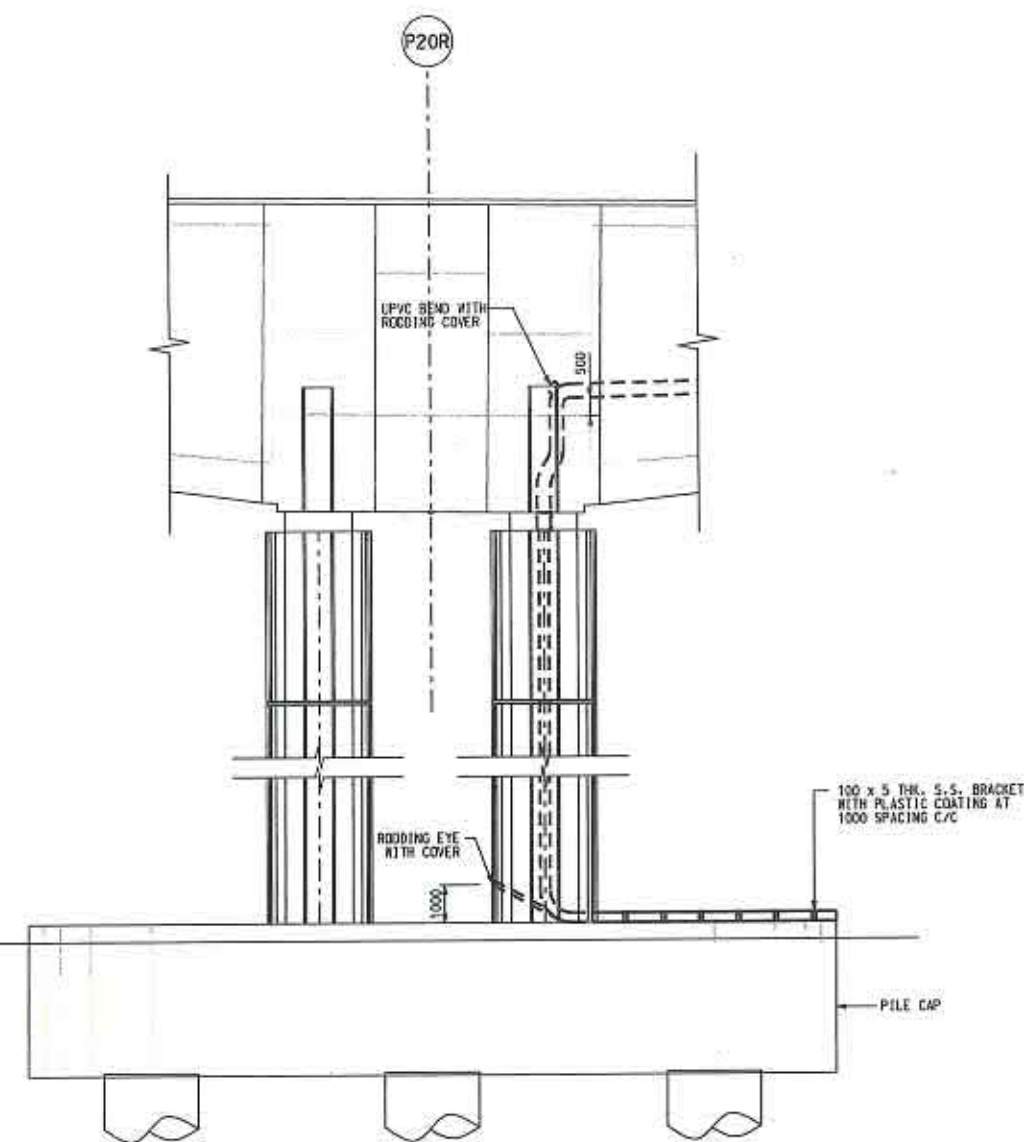


SECTION 1
SCALE 1:100

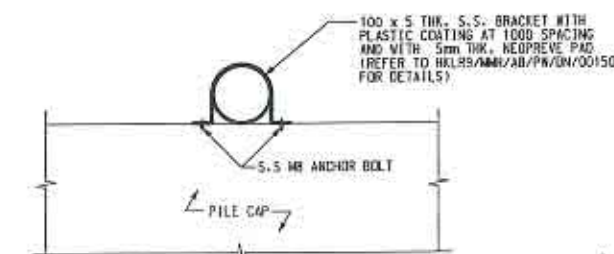


DETAIL  A
SCALE 1:20

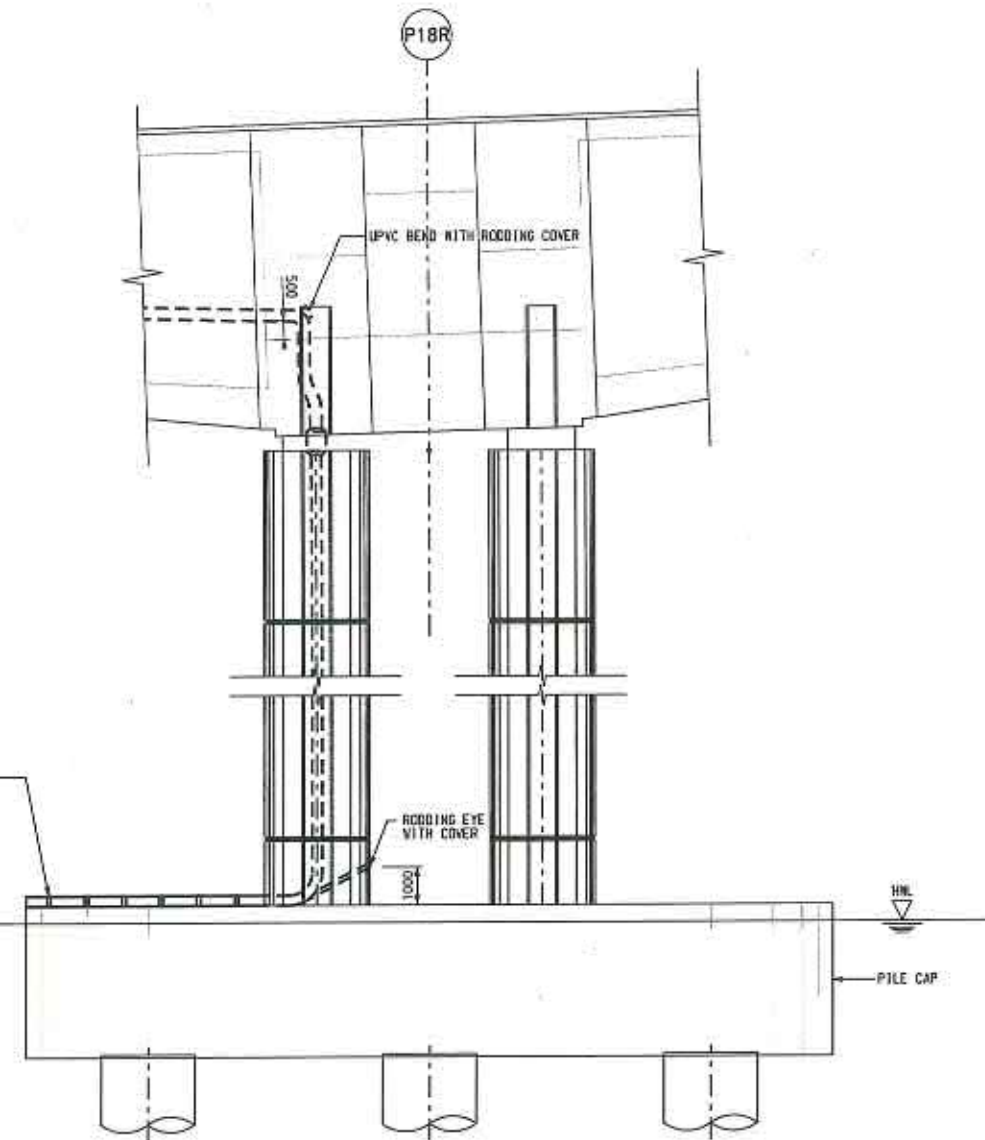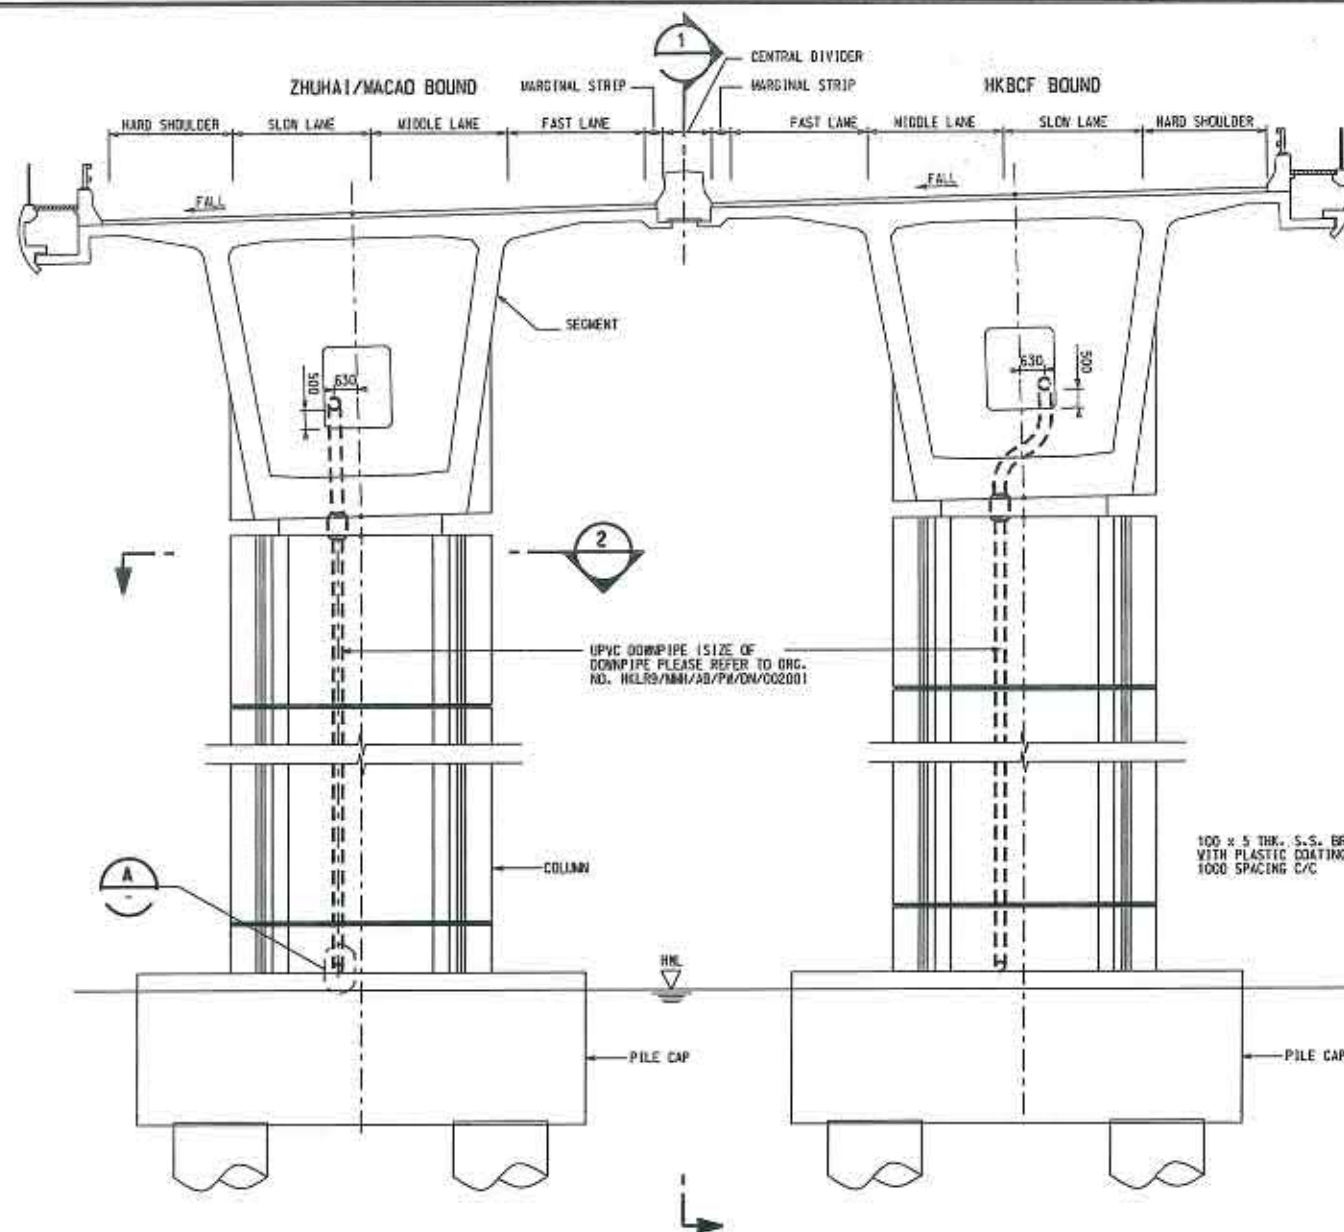



SECTION 1
 SCALE 1:100

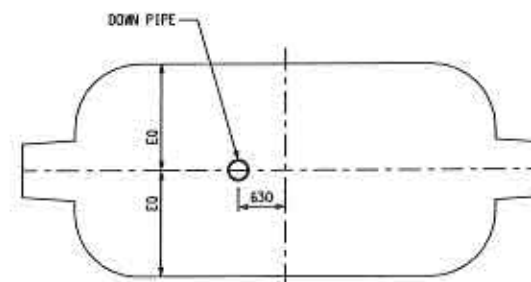

SECTION 2
 SCALE 1:50

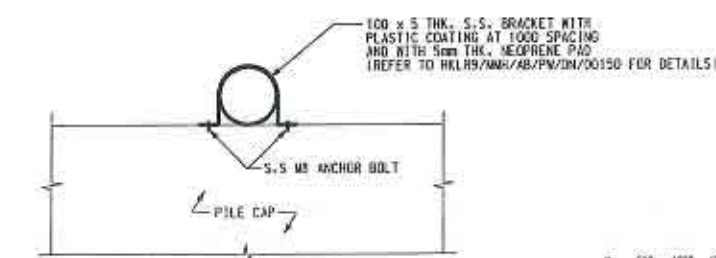

DETAIL A
 SCALE 1:20

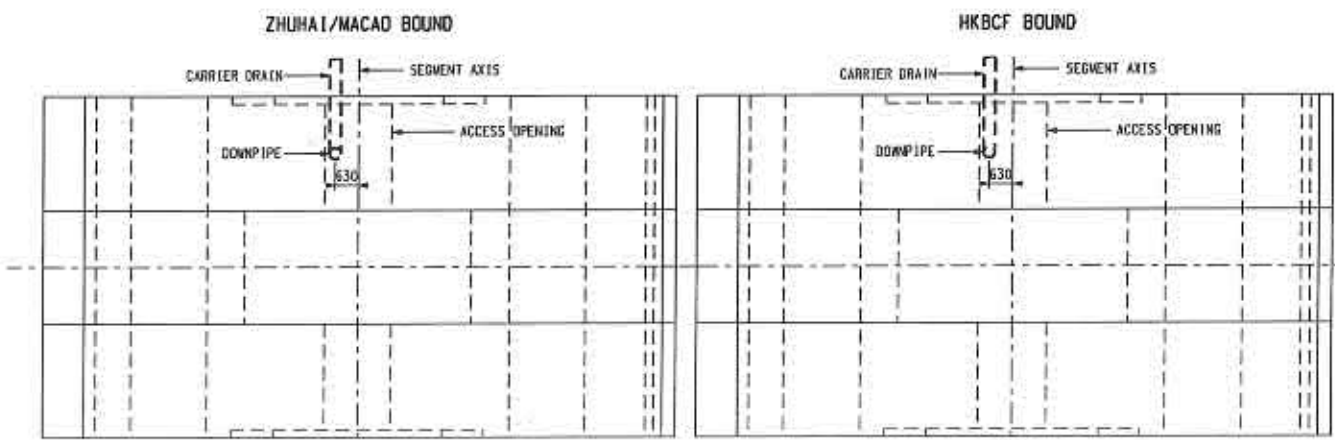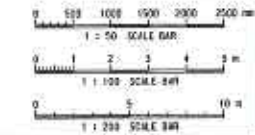

PLAN
 SCALE 1:100

NOTES:

1. FOR GENERAL NOTES REFER TO DRG. NO. HKLR9/MMH/AB/PW/DN/00000.
2. THIS TYPE OF DRAINAGE ARRANGEMENT IS APPLICABLE TO PIER P18.
3. DETAILS OF RODDING EYE REFERS TO DRG. NO. HKLR9/MMH/AB/PW/DN/00125.
4. PIER STARTERS AT CROSSHEAD SHALL BE CRANKED TO ALLOW CARRIER DRAIN PASSING THROUGH TO THE PIER AREA IF NECESSARY.
5. THIS SIZE OF CARRIER DRAIN REFER TO DRG. NO. HKLR9/MMH/AB/PW/DN/00001-00009.
6. THE SIZE OF DOWNPIPE REFER TO DRG. NO. HKLR9/MMH/AB/PW/DN/00200.

As-built Drawing	
Prepared by the Contractor "DCV/J"	
Mr. Y.K. Poon (Project Director)	11/01/19 Date
Checked by the Designer "Mott MacDonald"	
Dr. H.T. Cheng (Designer)	11/01/19 Date
Endorsed by the Design Checker "AECOM"	
Mr. Charles Luk (Design Checker)	11/01/19 Date




Contract No. HY/2011/09
 Hong Kong - Zhuhai - Macao Bridge
 Hong Kong Link Road
 Section Between HKSAR Boundary and Scenic Hill

TYPICAL DRAINAGE DOWNPIPE ARRANGEMENT - PIER P18


Project No.	HKLR9/MMH/AB/PW/DN/00118	Rev.	-
Design	AL	PL	HTC
AS SHOWN (IN A1)			
Drawn by	HKLR9	Sheet No.	1 OF 1
File Name	HKLR9_MMH_AB_PW_DN_00118.dgn		



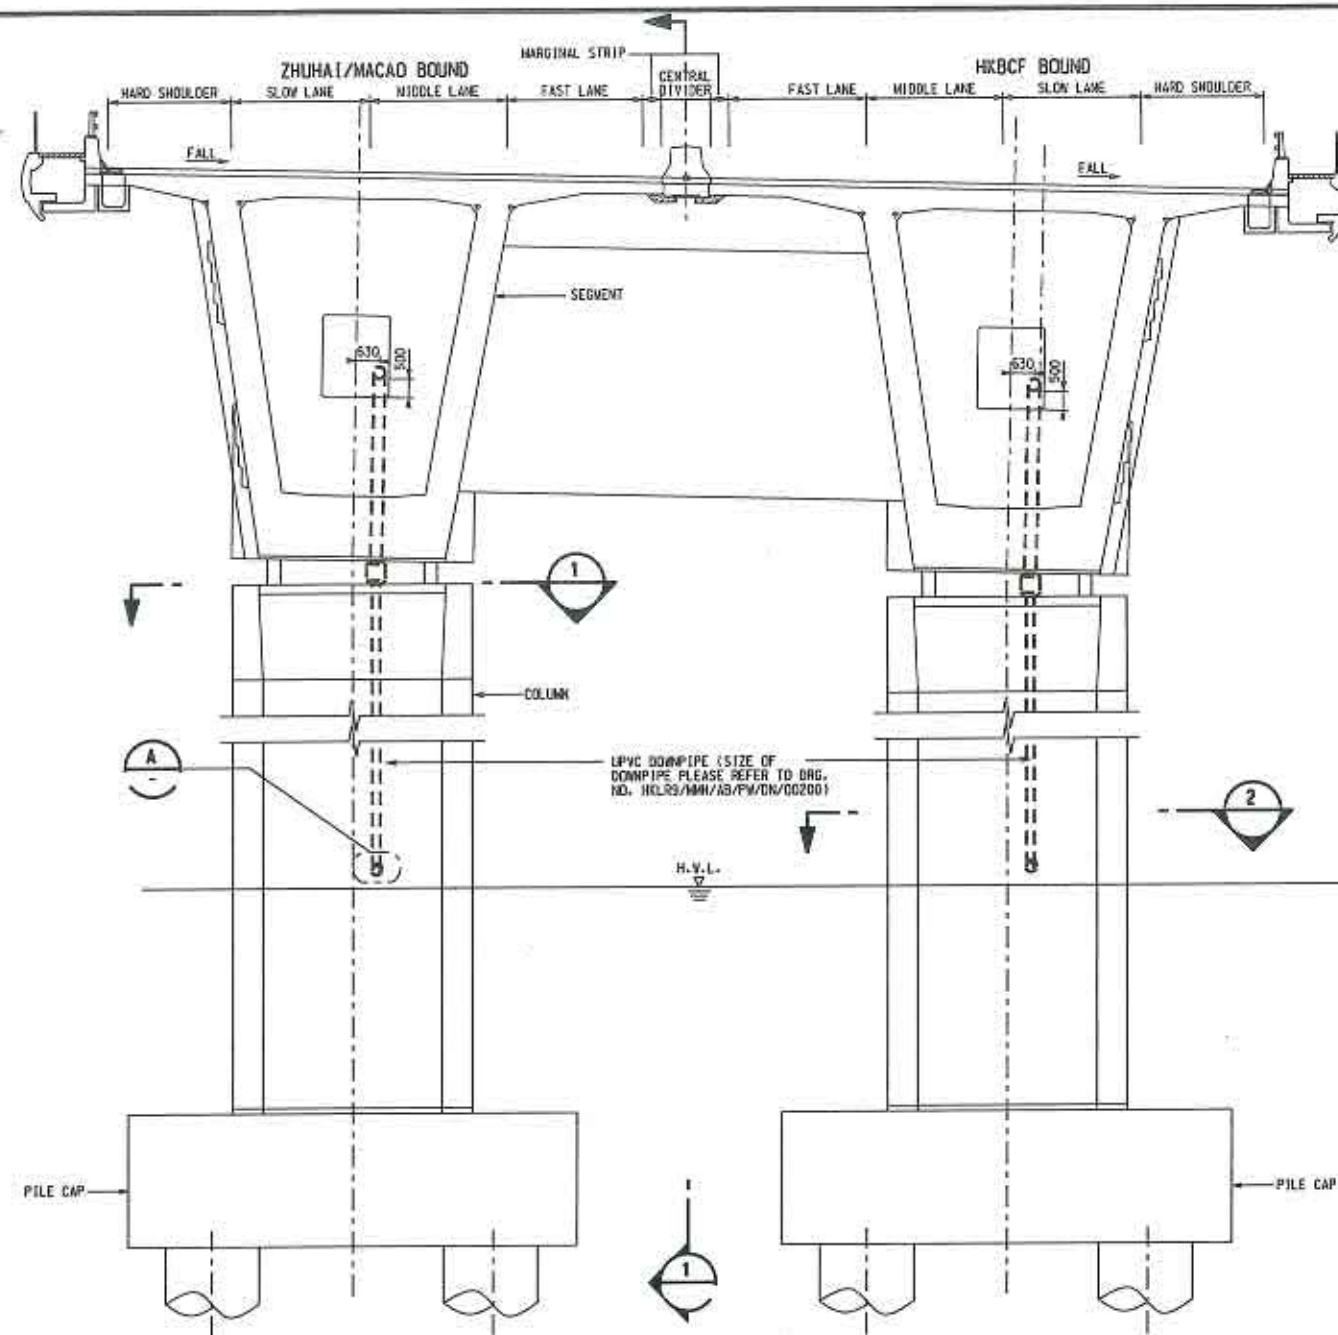


MONOLITHIC PIER AT NAVIGATION CHANNEL
 (APPLICABLE TO PIER P69)


SCALE 1:100

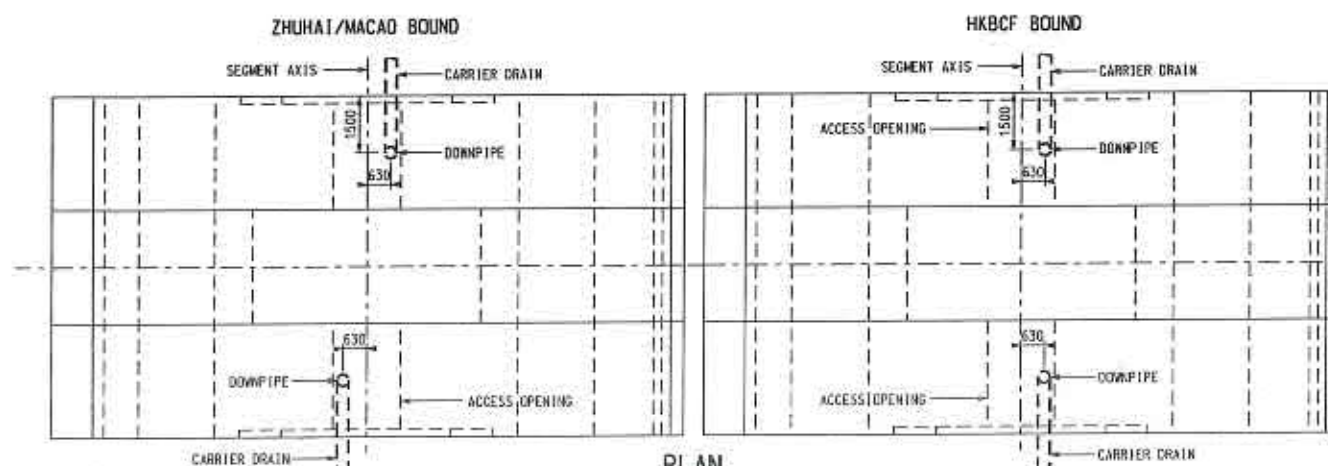


PLAN
 SCALE 1:100

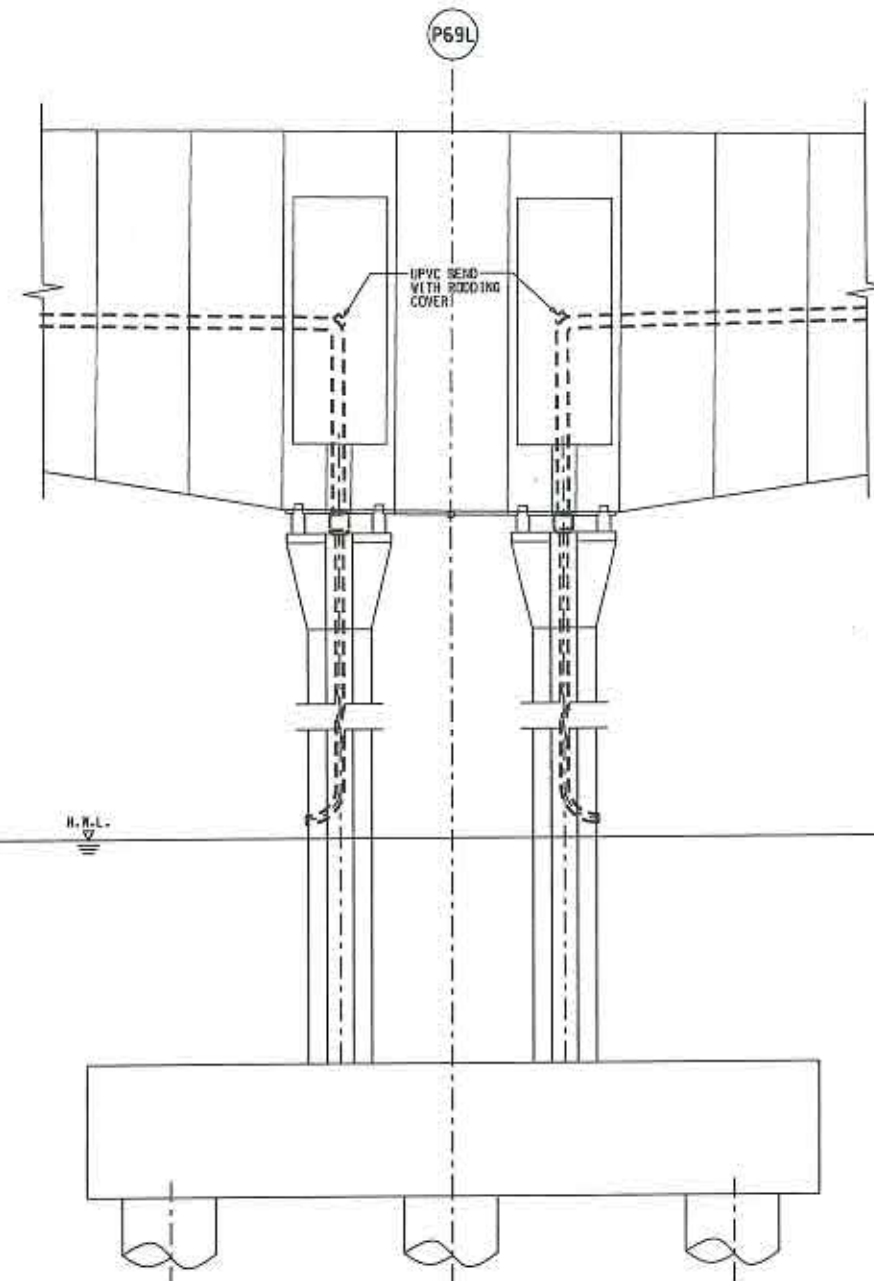


SECTION 1
 SCALE 1:100

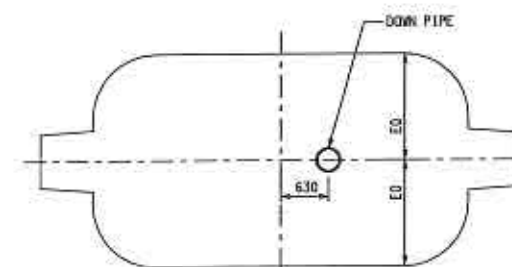


SECTION 2
 SCALE 1:50

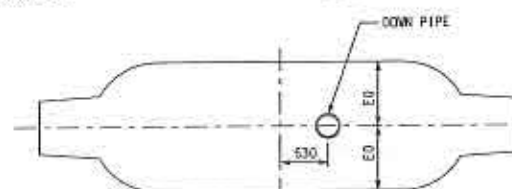

SECTION 3
 SCALE 1:50

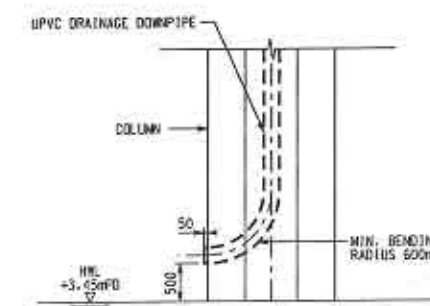

DETAIL A
 SCALE 1:50

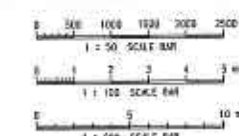

NOTES:

- FOR GENERAL NOTES REFER TO DRG. NO. HKLR9/MMH/AB/PW/DN/00000.
- THIS TYPE OF DRAINAGE ARRANGEMENT IS APPLICABLE TO PIER P69.
- DETAILS OF ROODING EYE REFER TO DRG. NO. HKLR9/MMH/AB/PW/DN/00125.
- PIER STARTERS AT CROSSHEAD SHALL BE CRANKED TO ALLOW CARRIER DRAIN PASSING THROUGH TO THE PIER AREA IF NECESSARY.
- THIS SIZE OF CARRIER DRAIN REFER TO DRG. NO. HKLR9/MMH/AB/PW/DN/00001-00009.
- THE SIZE OF DOWPIPE REFER TO DRG. NO. HKLR9/MMH/AB/PW/DN/00200.

As-built Drawing

Prepared by the Contractor "DCV JV"

Mr. W. P. Poon (Project Director)	11/01/19 Date
Checked by the Designer "Mott MacDonald"	
Dr. H.T. Cheng (Designer)	11/01/19 Date
Endorsed by the Design Checker "AECOM"	
Mr. Charles Luk (Design Checker)	11/01/19 Date



Designers - China Harbour - VSL Joint Venture 中國-香港-荷蘭聯合設計



Consultant



Project title

Contract No. HY/2011/09
Hong Kong - Zhuhai - Macao Bridge
Hong Kong Link Road
Section Between HKSAR Boundary and Scenic Hill

Drawing title

TYPICAL DRAINAGE DOWPIPE ARRANGEMENT - PIER P69

Drawing no.

HKL9/MMH/AB/PW/DN/00119

Design: AL, PL, HTC, AS-BUILT






AS SHOWN (IN A1)

Sheet no. 1 OF 1

File name: HKLR9_MMH_AB_PW_DN_00119.dgn

COPYRIGHT RESERVED



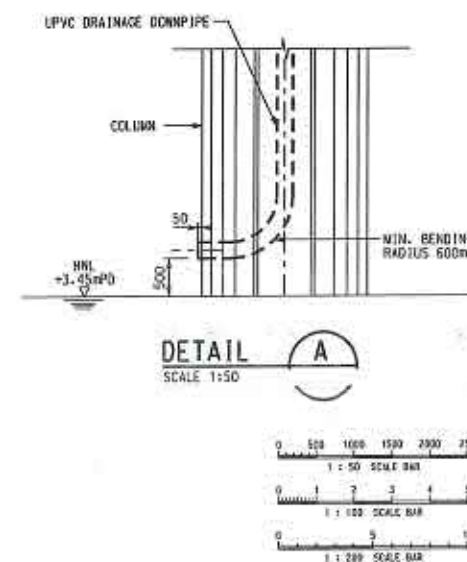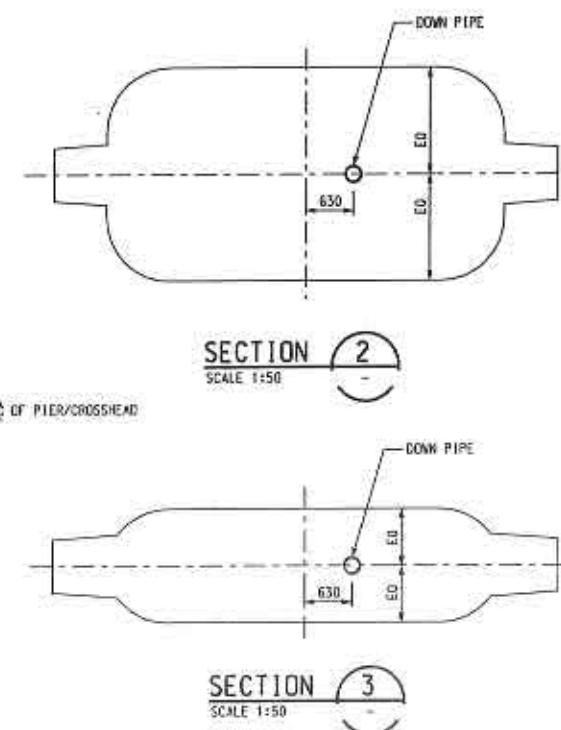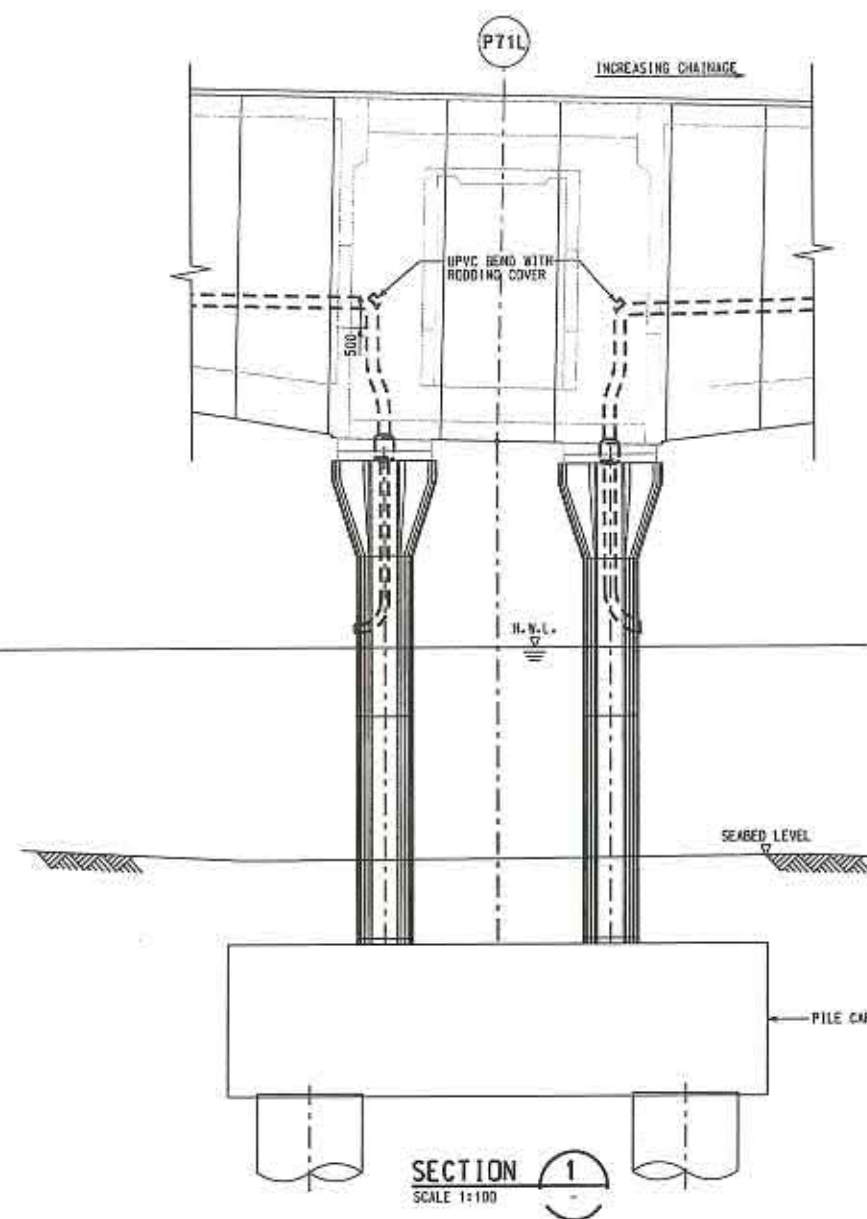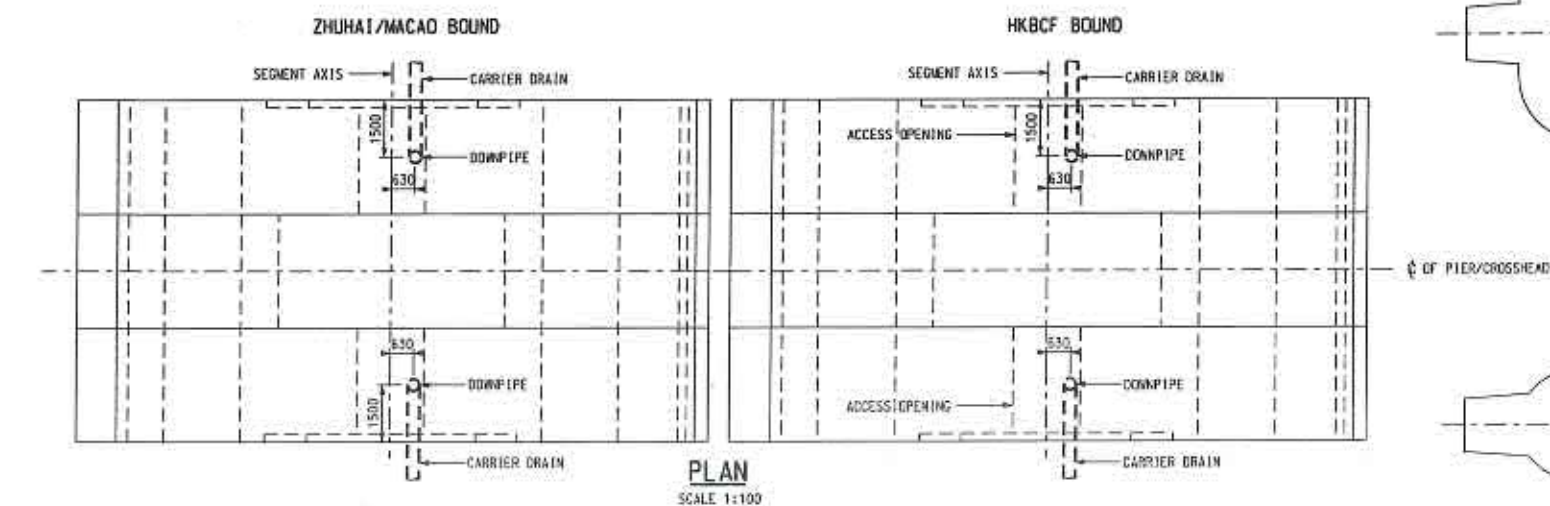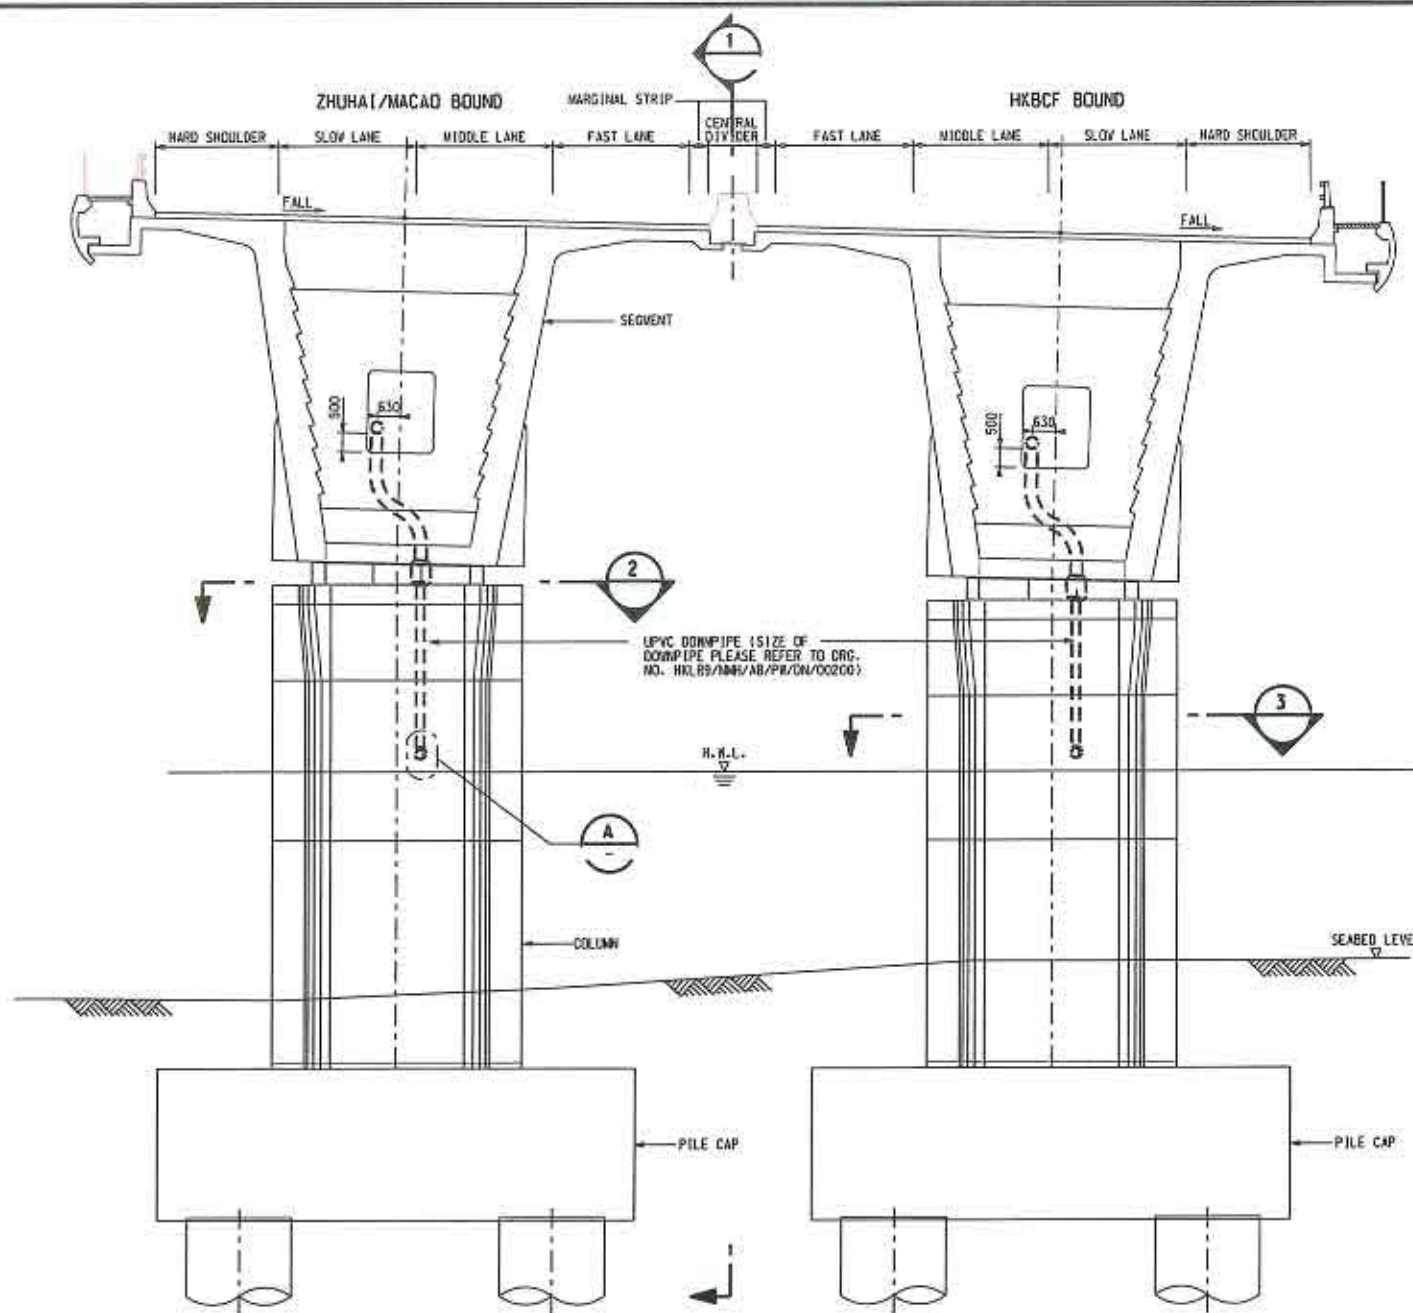

NOTES:

- FOR GENERAL NOTES REFER TO DRG. NO. HKLR9/MMH/AB/PW/DN/00000.
- THIS TYPE OF DRAINAGE ARRANGEMENT IS APPLICABLE TO PIERS P71, P72, P73 AND P75.
- PIER STARTERS AT CROSSHEAD SHALL BE CRANED TO ALLOW CARRIER DRAIN PASSING THROUGH TO THE PIER AREA IF NECESSARY.
- THIS SIZE OF CARRIER DRAIN REFER TO DRG. NO. HKLR9/MMH/AB/PW/DN/00001-00009.
- THE SIZE OF DOWNPIPE REFER TO DRG. NO. HKLR9/MMH/AB/PW/DN/00200.

As-built Drawing

Prepared by the Contractor "DCVJV"

11/01/19
 Mr. W.K. Poon
 (Project Director)

11/01/19
 Dr. H.T. Cheng
 (Designer)

11/01/19
 Dr. H.T. Cheng
 (Designer)

11/01/19
 Mr. Charles Luk
 (Design Checker)



Designs - China Harbour - VSL Joint Venture 設計-中國港務-維多利亞



ARUP 奧雅納工程顧問
 Ove Arup & Partners Hong Kong Limited

Contract No. HY/2011/09
Hong Kong - Zhuhai - Macao Bridge
Hong Kong Link Road
Section Between HK SAR Boundary and Scenic Hill



TYPICAL DRAINAGE
DOWNPIPE ARRANGEMENT
PIER P71, P72, P73 & P75

Drawn by:	Checked by:	Approved by:	Scale:
AL	PL	HTC	AS-BUILT
AS SHOWN (IN A1)			
HKLR9			1 OF 1

HKLR9_MMH_AB_PW_DN_00120.dgn


COPYRIGHT RESERVED



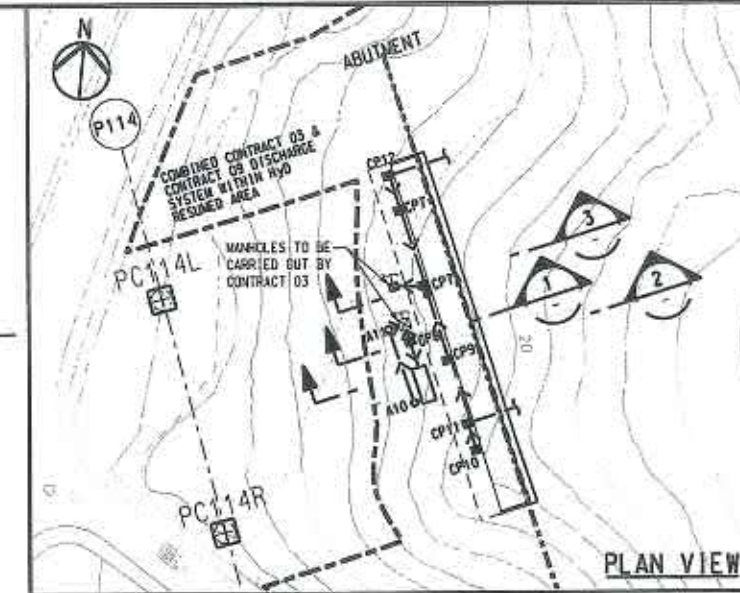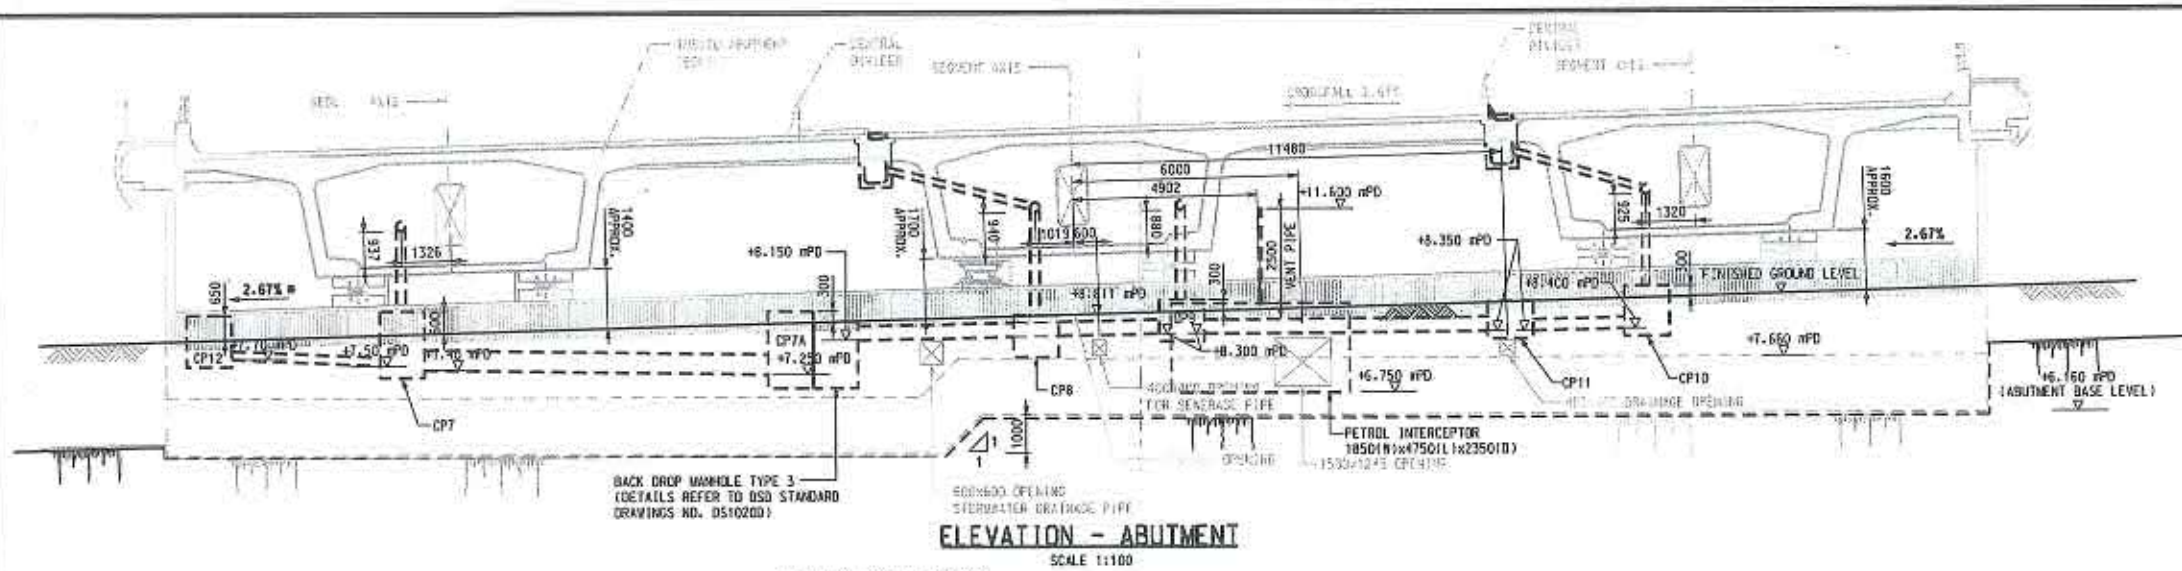

NOTES:

1. DOWNPIPE ARE INDICATIVE ONLY AND TO BE CONSTRUCTED UNDER CONTRACT HY/2011/09.
2. ALL CAST UNITS SHALL BE COATED WITH A BITUMEN COATING.
3. FOR STRUCTURE DETAIL REFER TO DDA SUPERSTRUCTURE DESIGN PACKAGE.
4. PIER STARTERS AT CROSSROAD SHALL BE CRANKED TO ALLOW CARRIER DRAIN PASSING THROUGH TO THE PIER AREA IF NECESSARY.
5. DETAILS OF PRECAST CONCRETE COVERS FOR CATCHPIT REFER TO CEDD STD DRG. NO. C2401B.
6. THE LEVELS AND FALLS OF FINISH GROUND ARE INDICATIVE ONLY. THE GROUND REINSTATEMENT WORKS SHALL BE DONE BY OTHERS.

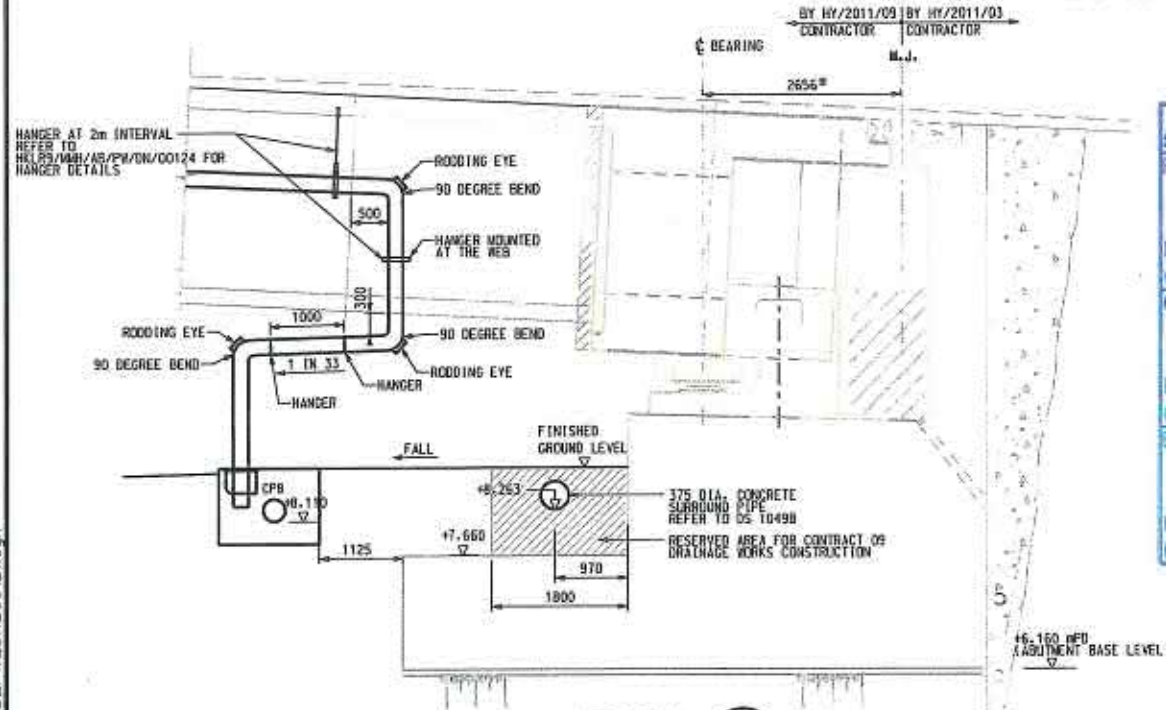

As-built Drawing
 Prepared by the Contractor "DCV JV"
 11/01/19
 Mr. W.K. Poon
 (Project Director)
 Checked by the Designer "Mott MacDonald"
 11/01/19
 Dr. H.T. Cheng
 (Designer)
 Endorsed by the Design Checker "AECOM"
 11/01/19
 Mr. Charles Luk
 (Design Checker)



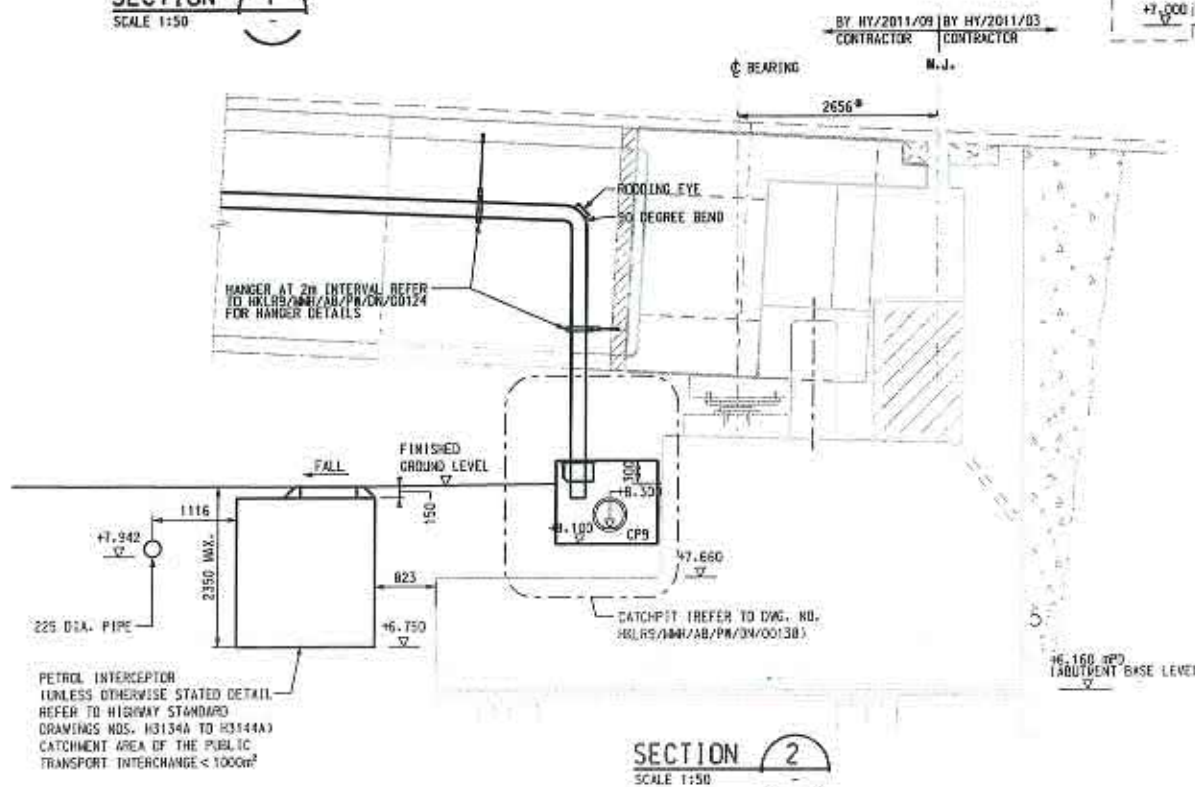


TABLE FOR CATCHPIT DETAILS:

CATCHPIT NO.	CP7	CP7A	CP8	CP9	CP10	CP11	CP12
TOP LEVEL (mm FROM F.G.L.)	600	300	0	300	300	0	650
DOWN PIPE AT TOP	YES	NO	YES	YES	YES	NO	NO

FOR ANY DOWN PIPE AT TOP REFER TO DWS. NO. HKLR9/MH/AB/PN/DN/00138.
 FOR NO DOWN PIPE AT TOP REFER TO DWS. NO. HKLR9/MH/AB/PN/DN/00139.

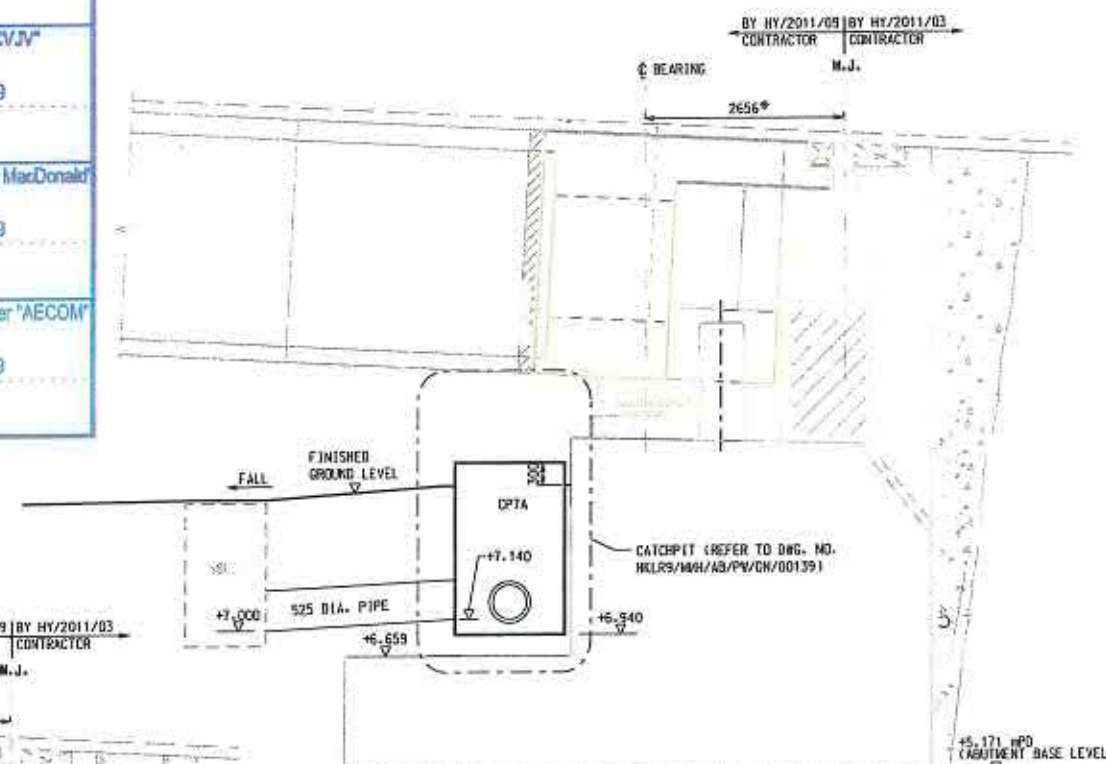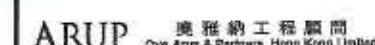


Contract No. HY/2011/09
Hong Kong - Zhuhai - Macao Bridge
Hong Kong Link Road
Section Between HKSAR Boundary and Scenic Hill

TYPICAL DRAINAGE DETAILS
INTERFACE ABUTMENT


Project No.	HKL9/MH/AB/PN/DN/00121	Rev.	-
Design	AL	PL	HTC
Scale	1:1000 (IN A1)	Author	AS-HKL9
Drawn by	HKL9	Sheet No.	1 OF 1
File Name	HKL9_MH_AB_PW_DN_00121.dgn		



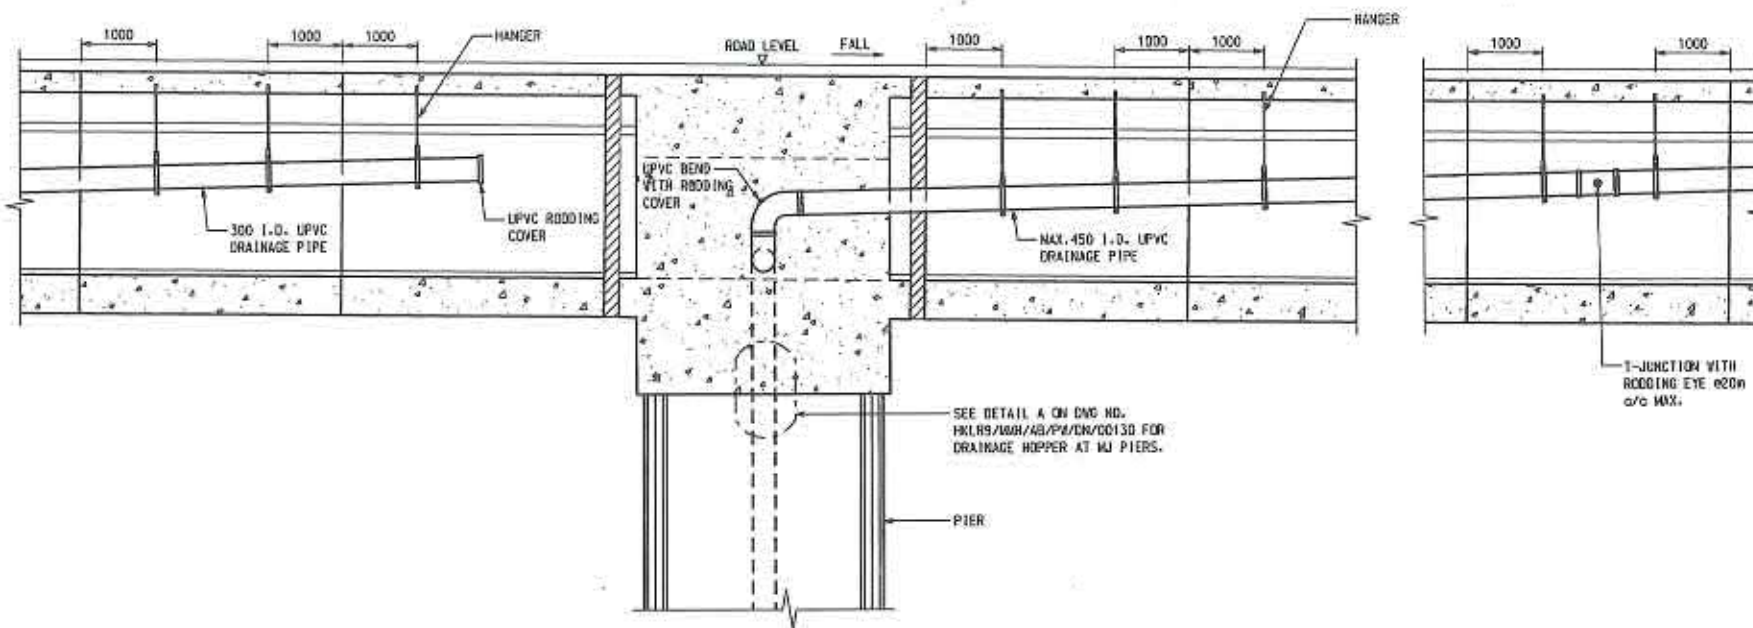


TYPICAL CARRIER DRAIN ARRANGEMENT

SCALE 1:50

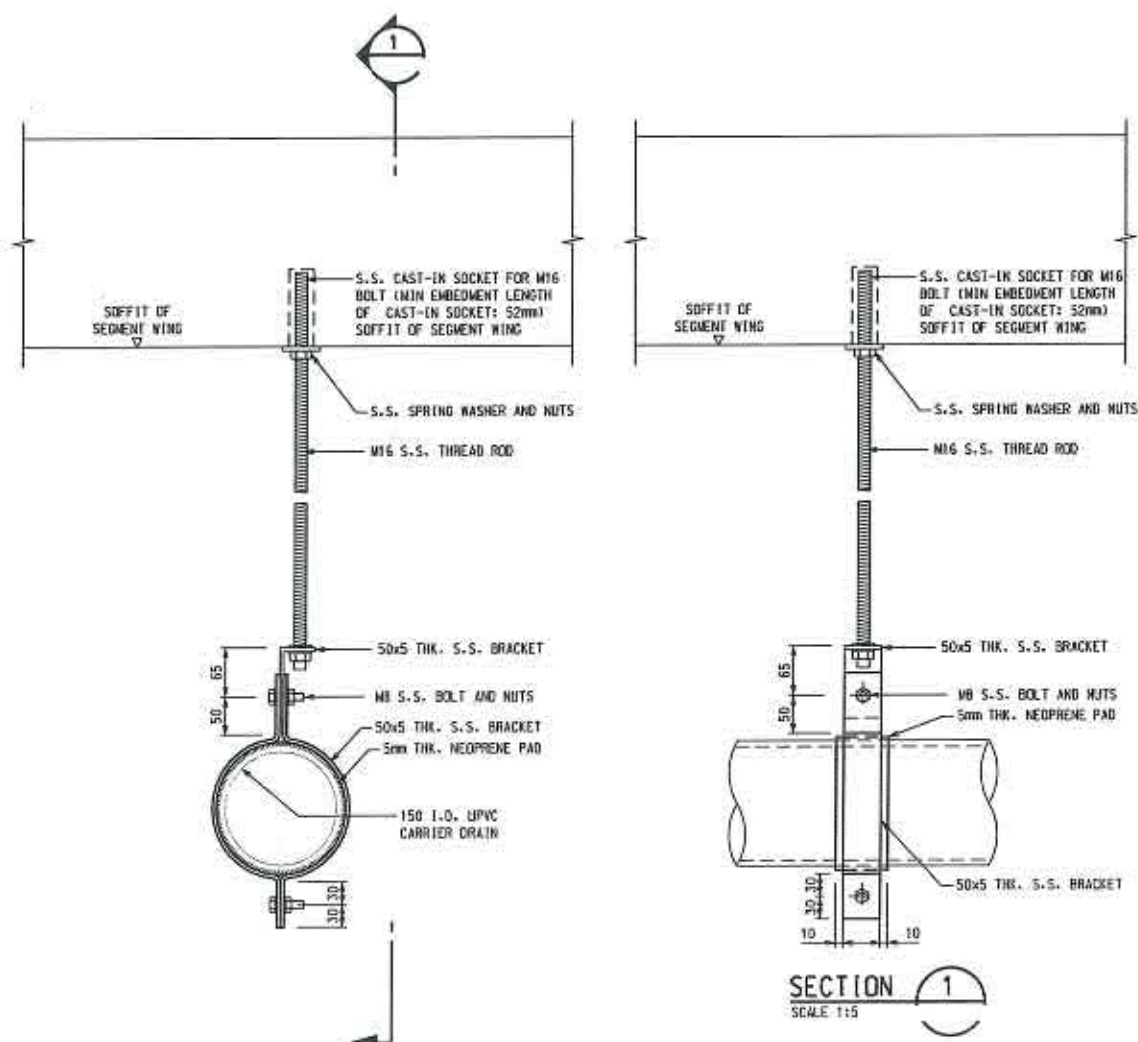

TYPICAL HANGER DETAIL FOR GULLY CONNECTION PIPE EXPOSED TO OUTDOOR ENVIRONMENT

SCALE 1:5

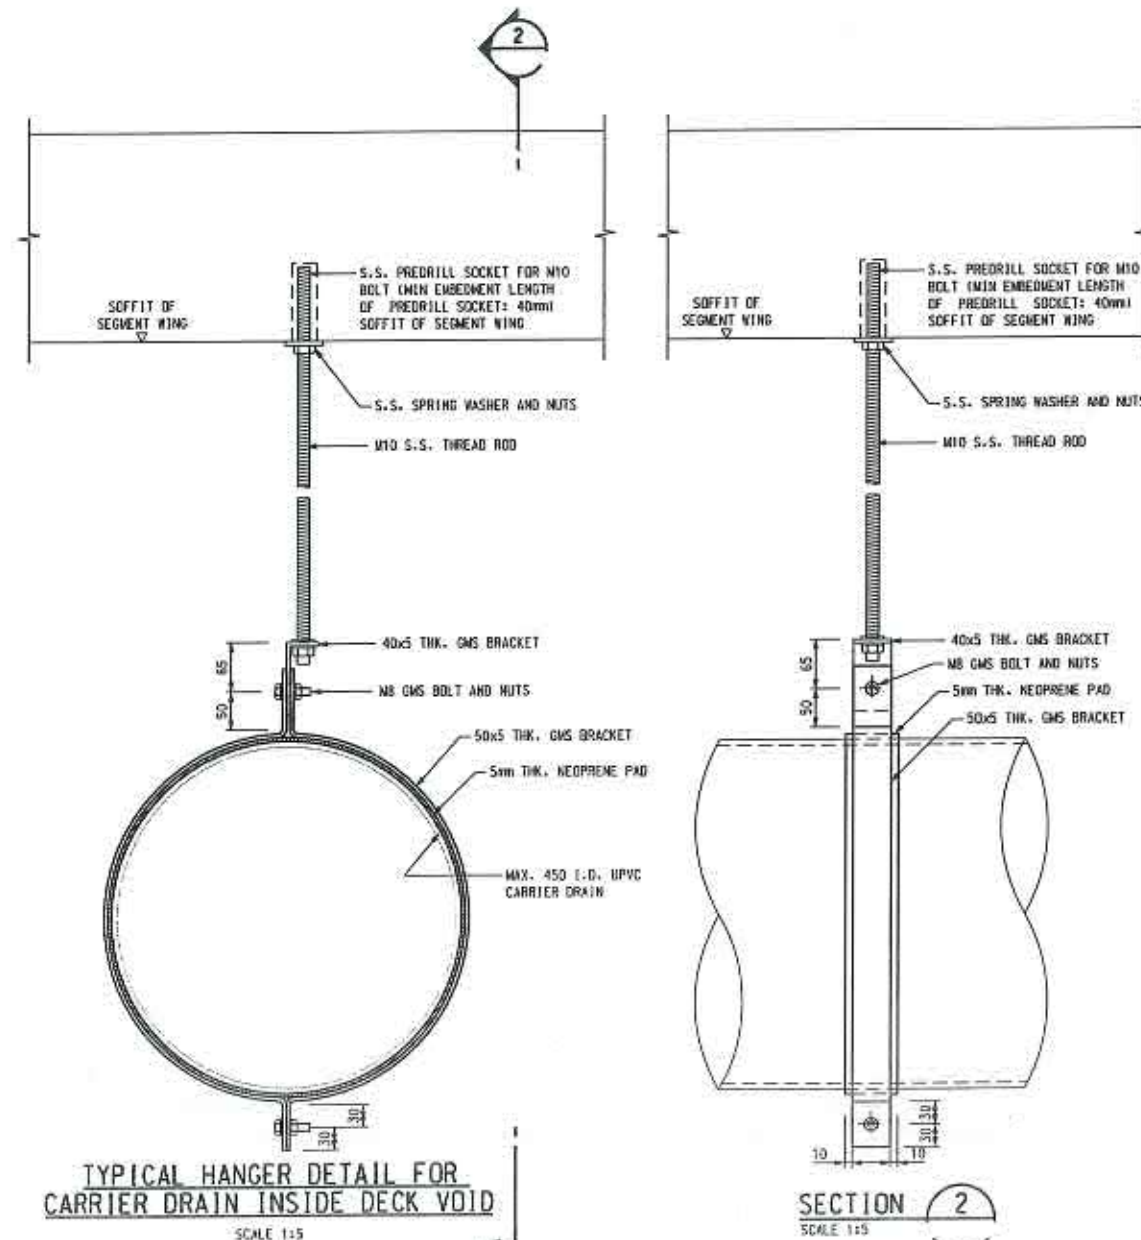

TYPICAL HANGER DETAIL FOR CARRIER DRAIN INSIDE DECK VOID

SCALE 1:5

NOTES:

- FOR NOTES AND LEGENDS REFER TO DRG. NO. HKLRS/MMH/AB/PW/DN/00000.
- LOCATION AND DETAIL OF HANGER ARE INDICATIVE ONLY. EXACT ARRANGEMENT OF HANGER TO BE DETERMINED ON SITE.
- GRADE S275 WILL BE ADOPTED FOR GMS BRACKET.
- NYLON WASHER TO BE PROVIDED BETWEEN S.S. AND GMS FOR ISOLATION.

As-built Drawing

Prepared by the Contractor "DCV JV"

Mr. W.K. Poon
 (Project Director)
 Date: 11/01/19

Checked by the Designer "Mott MacDonald"

Dr. H.T. Chang
 (Designer)
 Date: 11/01/19

Endorsed by the Design Checker "AECOM"

Mr. Charles Luk
 (Design Checker)
 Date: 11/01/19



Contractor's Engineer




Contract No. HY/2011/09
Hong Kong - Zhuhai - Macao Bridge
Hong Kong Link Road
Section Between HKSAR Boundary and Scenic Hill

TYPICAL DRAINAGE DETAILS HANGER SUPPORT

Design No.	HKLRS/MMH/AB/PW/DN/00124	Rev.	-
Design	AL	SHL	HTC
AS SHOWN (IN A1)			
Sheet No.	HKLRS	1 OF 1	
File Name	HKLRS_MMH_AB_PW_DN_00124.dgn		



Printed by : 6/4/2019
Filename : D:\HKLR9\As-Built drawings\DDA 20\Final As-Built drawings\Part 1\HKLR9_MMH_AB_PW_DN_00125.dgn

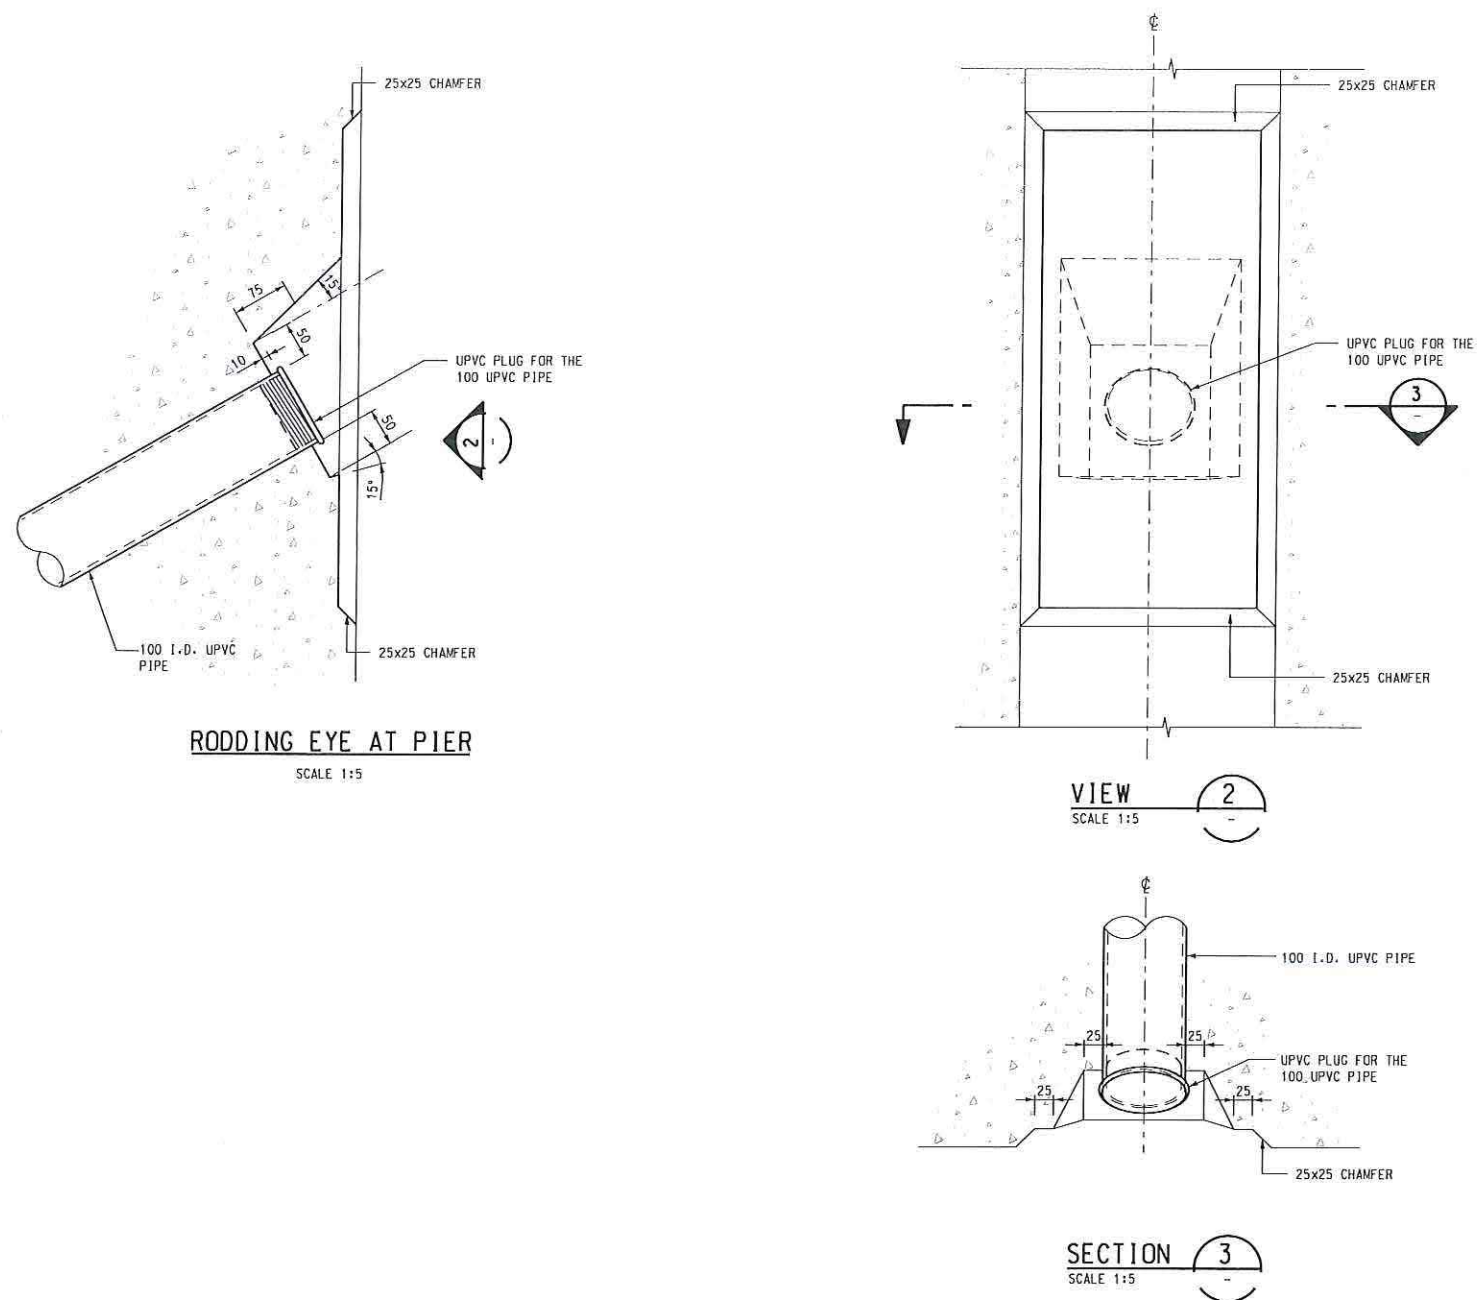

NOTES:

- FOR NOTES AND LEGENDS REFER TO DRG. NO. HKLR9/MMH/AB/PW/DN/00000.
- DETAILS OF RODDING EYE ON SURFACE ROAD SHALL REFER TO HYD STANDARD DRAWINGS H3114A AND H3115A.

As-built Drawing

Prepared by the Contractor "DCVJV"

04JUN2019
Date

Mr. W.K. Poon
(Project Director)

Checked by the Designer "Mott MacDonald"

04JUN2019
Date

Dr. H.T. Cheng
(Designer)

Endorsed by the Design Checker "AECOM"

04JUN2019
Date

Mr. Charles Luk
(Design Checker)

Major Contractor



Dragages - China Harbour - VSL Joint Venture 廣發-中國海灣-威利利聯合

Contractor's Designer



Consultant

ARUP 奧雅納工程顧問
Ove Arup & Partners Hong Kong Limited

Project Title

Contract No. HY/2011/09
Hong Kong - Zhuhai - Macao Bridge
Hong Kong Link Road
Section Between HKSAR Boundary
and Scenic Hill

Drawing Title

TYPICAL DRAINAGE DETAILS
- RODDING EYE

Drawing No.

HKLR9/MMH/AB/PW/DN/00125

Design AL SHL Approved HTC Status AS-BUILT

Scale AS SHOWN (IN A1)


Job No. HKLR9 Sheet No. 1 OF 1

Title name HKLR9_MMH_AB_PW_DN_00125.dgn

COPYRIGHT RESERVED




0 50 100 150 200 250 m
1 : 5 SCALE BAR

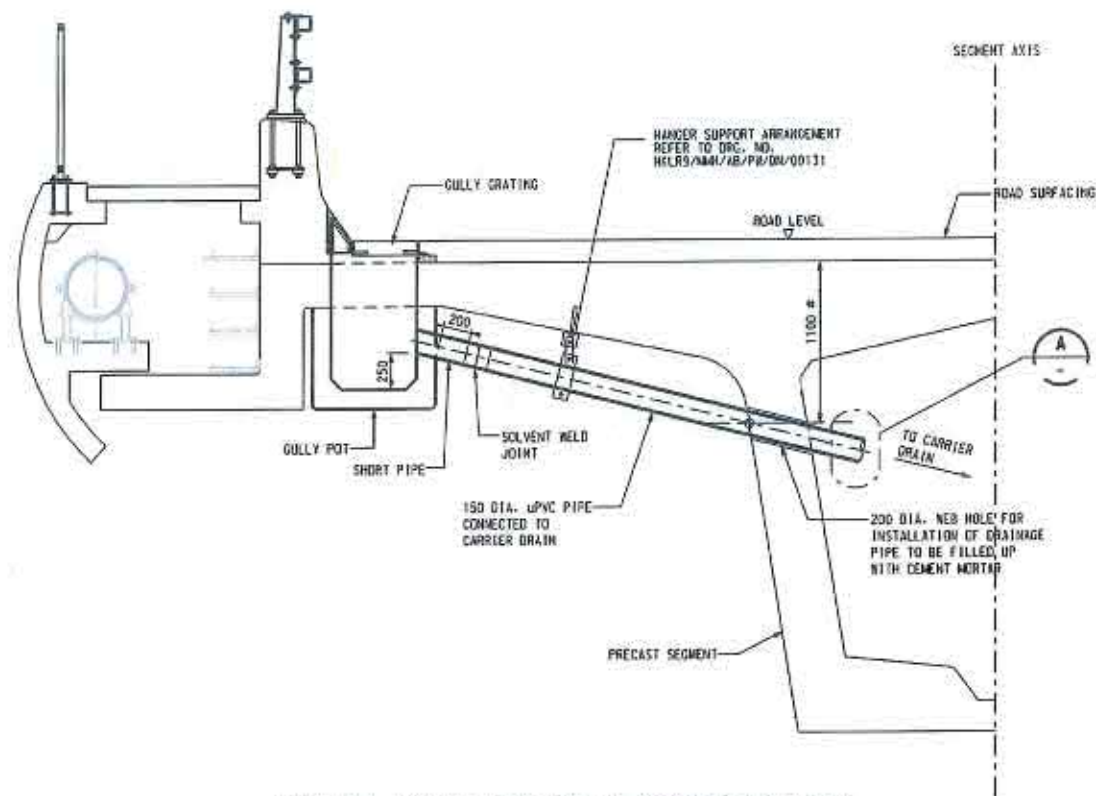


TYPICAL DETAILS OF GULLY CONNECTION PIPE

SCALE 1:25

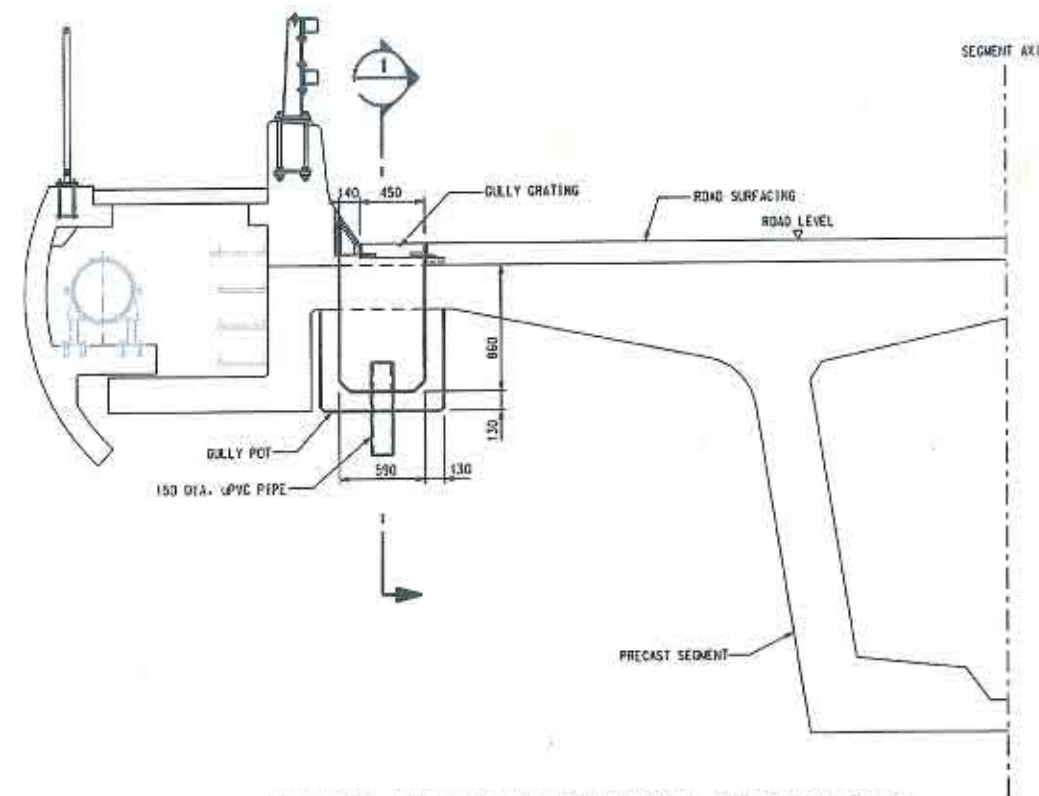


TYPICAL DETAILS OF GULLY WITH OVERFLOW WEIR

SCALE 1:25

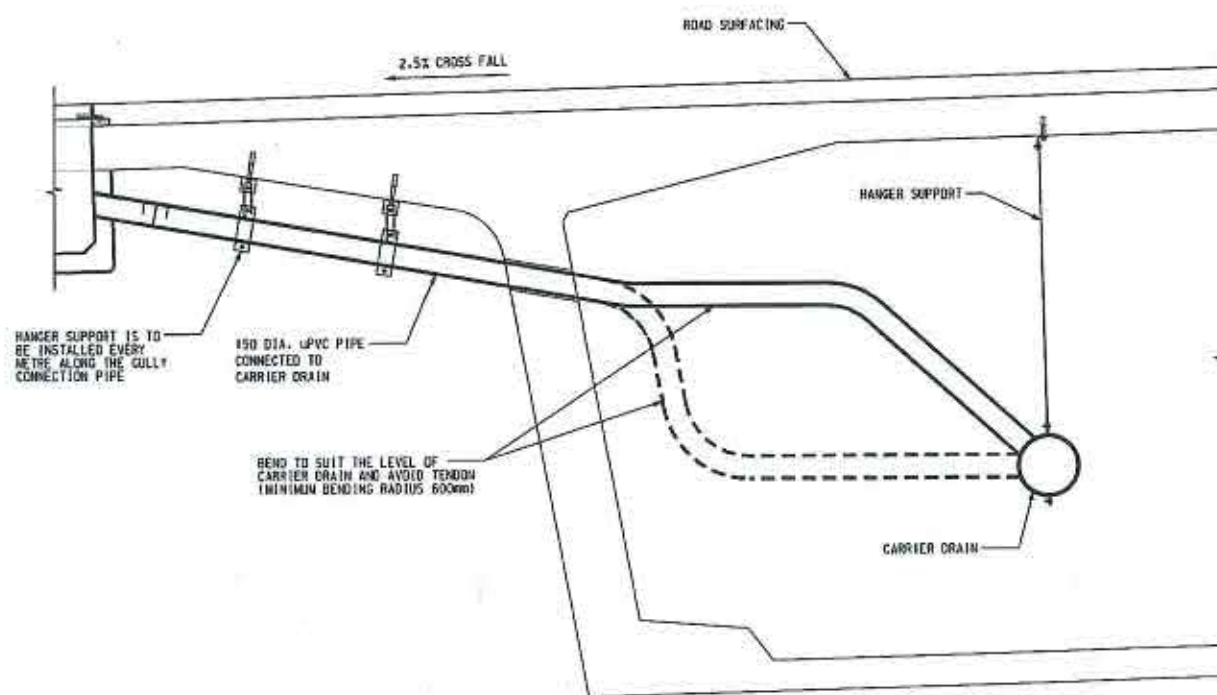


DETAIL A

SCALE 1:25

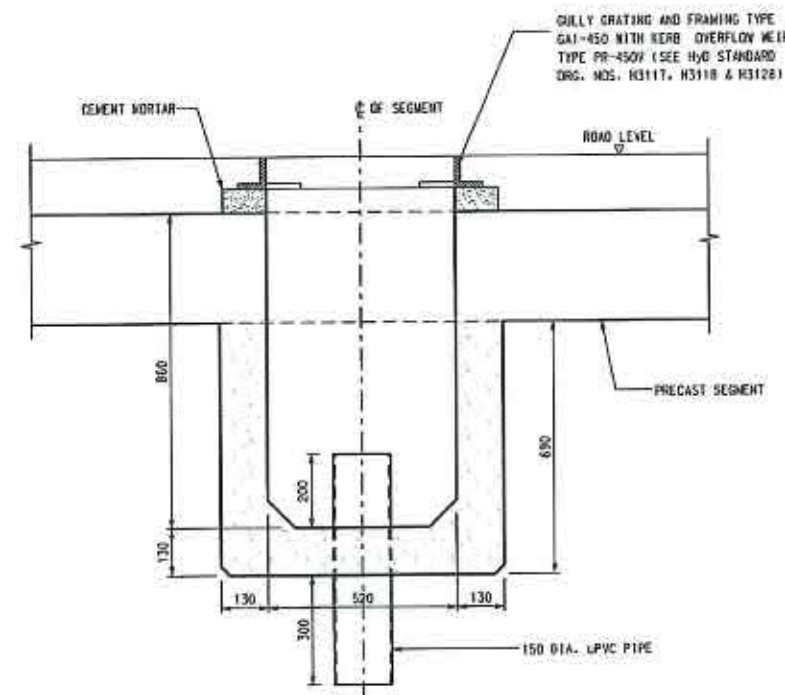

SECTION 1

SCALE 1:10

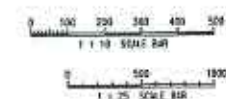

As-built Drawing	
Prepared by the Contractor "DCV JV"	
Mr. W.K. Poon (Project Director)	11/01/19 Date
Checked by the Designer "Mott MacDonald"	
Dr. H.T. Cheng (Designer)	11/01/19 Date
Endorsed by the Design Checker "AECOM"	
Mr. Charles Luk (Design Checker)	11/01/19 Date



Contract No. HY/2011/09
Hong Kong - Zhuhai - Macao Bridge
Hong Kong Link Road
Section Between HKSAR Boundary
and Scenic Hill


TYPICAL DRAINAGE DETAILS
GULLY CONNECTION PIPE

Drawing No. HKLR9/MMH/AB/PW/DN/00126

AS SHOWN (IN A1)


HKLR9

路政署
HIGHWAYS DEPARTMENT

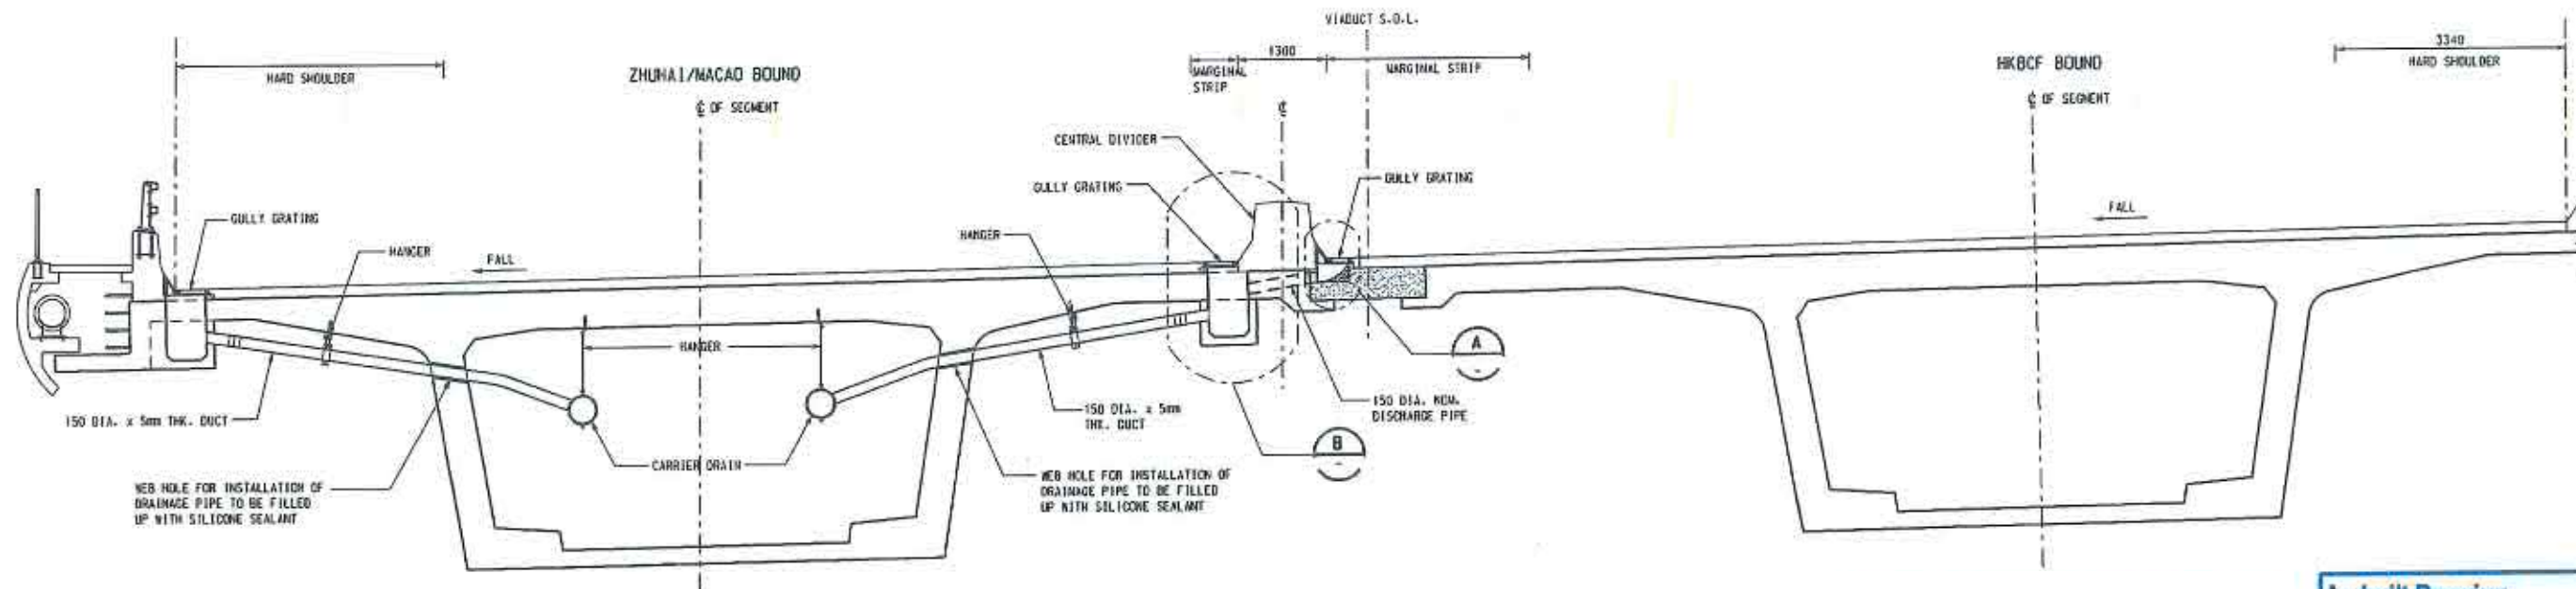


TYPICAL GULLY ARRANGEMENT FOR WIDENING SECTION

SCALE 1:50

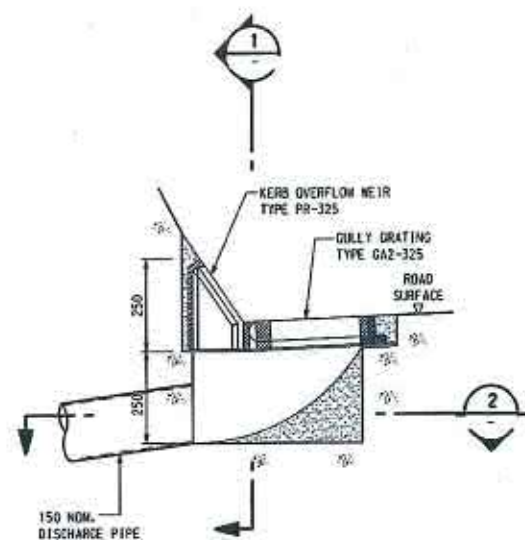


DETAIL A

SCALE 1:10

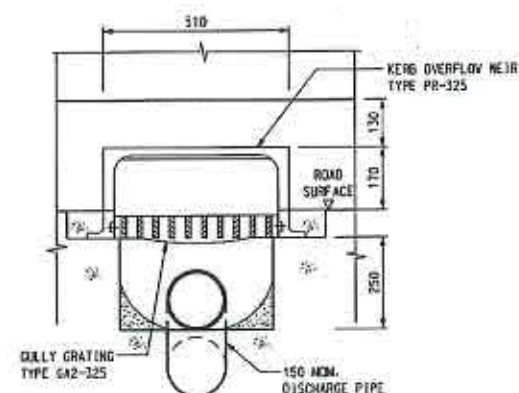


SECTION 1

SCALE 1:10

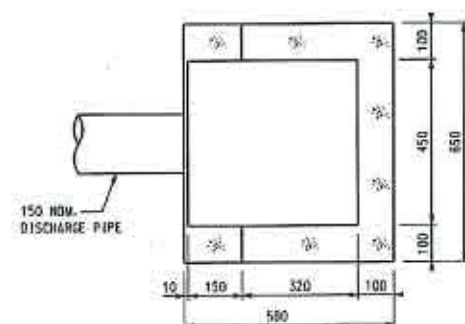

SECTION 2

SCALE 1:10

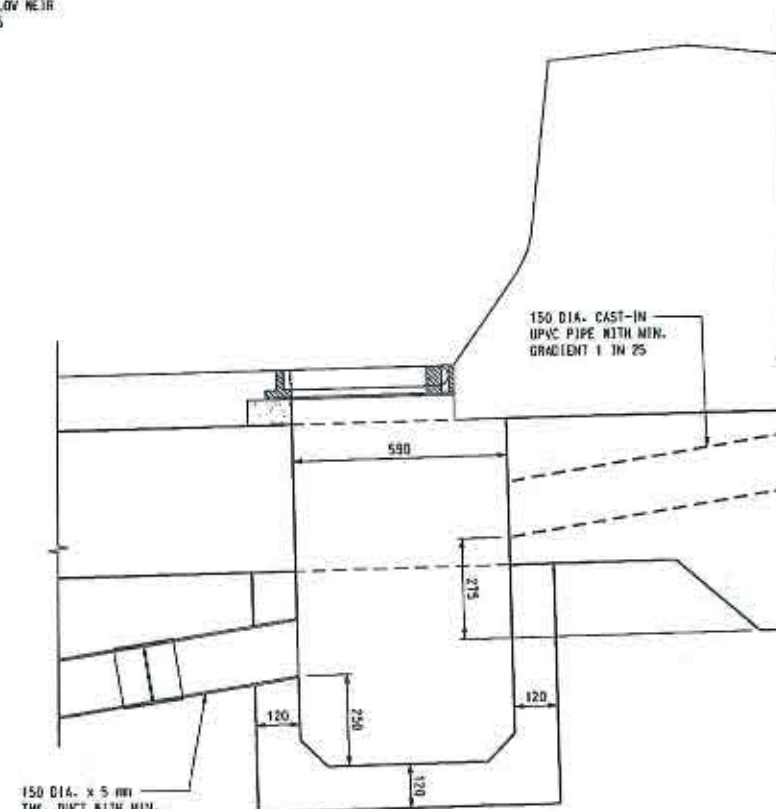

DETAIL B

SCALE 1:10

As-built Drawing	
Prepared by the Contractor "DCVJV"	
Mr. W.K. Poon (Project Director)	11/01/19 Date
Checked by the Designer "Mott MacDonald"	
Dr. H.T. Cheng (Designer)	11/01/19 Date
Endorsed by the Design Checker "AECOM"	
Mr. Charles Luk (Design Checker)	11/01/19 Date



Cooper - China Harbour - VSL Joint Venture 實業 - 中國港務 - 威達有限公司












Contract No. HY/2011/09
Hong Kong - Zhuhai - Macao Bridge
Hong Kong Link Road
Section Between HKSAR Boundary
and Scenic Hill

TYPICAL DRAINAGE ARRANGEMENT FOR
WIDENING SECTIONS

Project No.	HKLR9/MMH/AB/PW/DN/00128	Rev.	-
Design	AL	SHL	HTC
AS SHOWN (IN A1)	AS SHOWN	AS SHOWN	AS SHOWN
Box No.	HKLR9	Sheet No.	3 OF 6
File Name	HKLR9_MMH_AB_PW_DN_00128.dgn	COPYRIGHT RESERVED	



0 300 600 900 1200 1500 1800 2100 2400 2700 3000
1 : 50 SCALE BAR

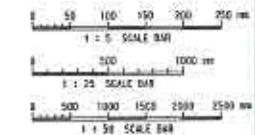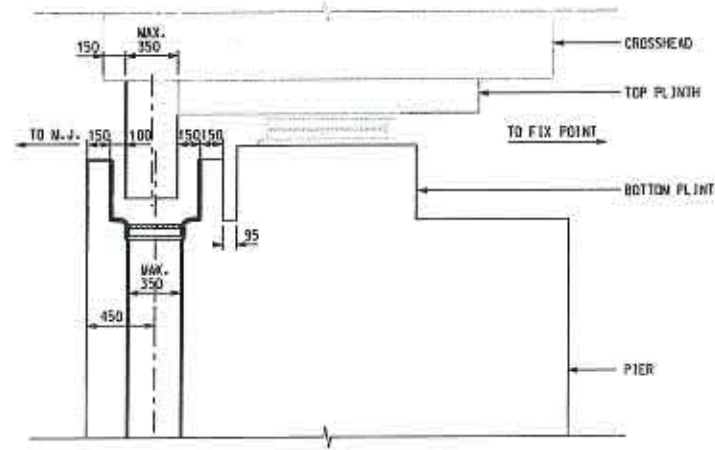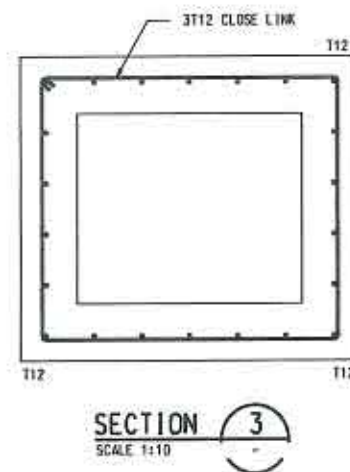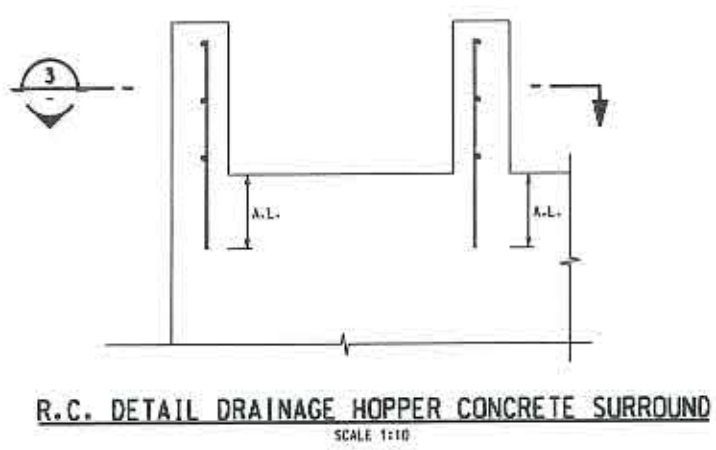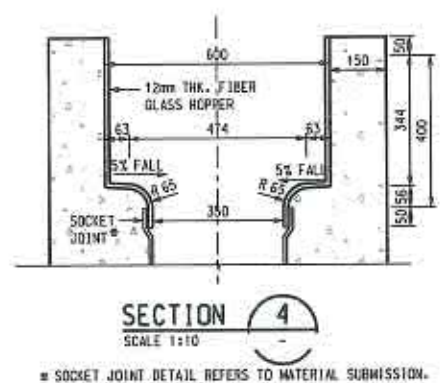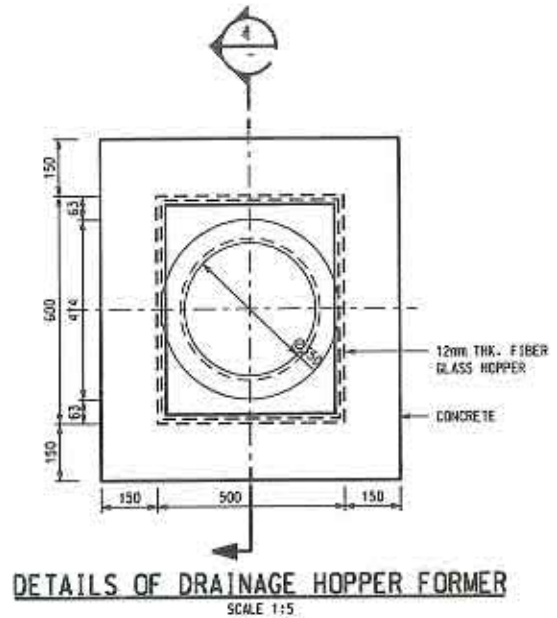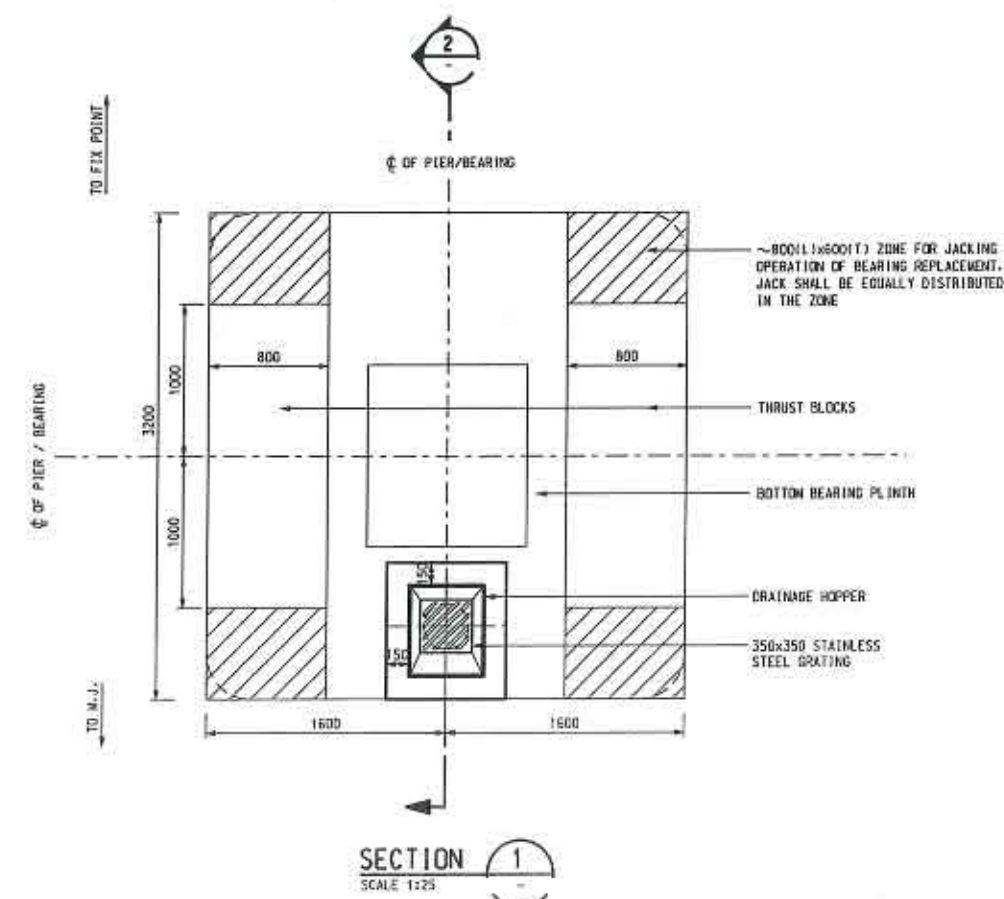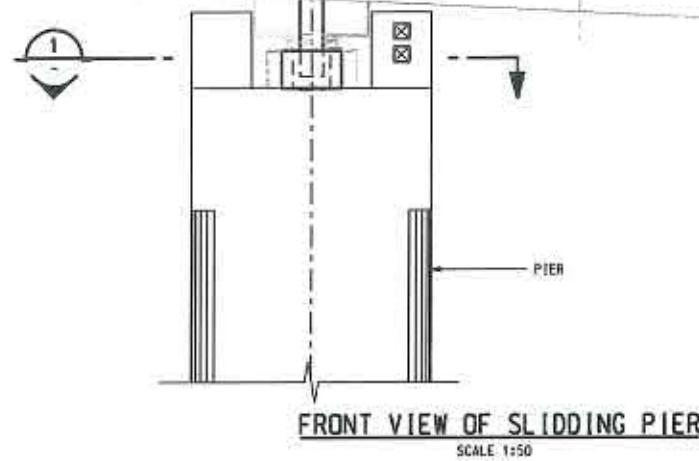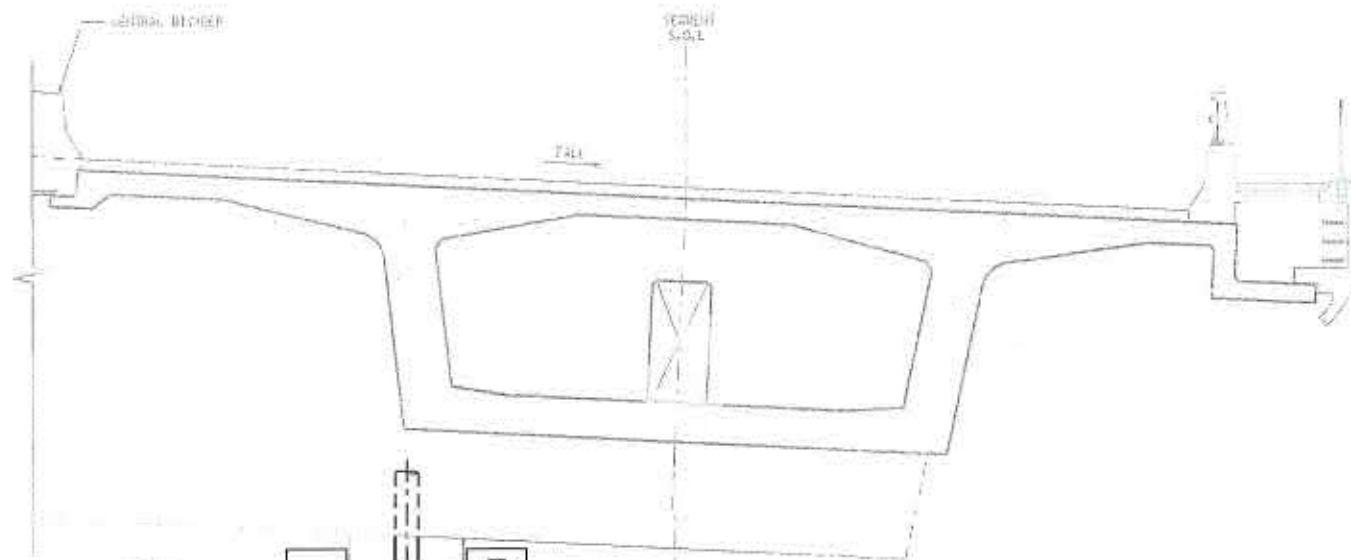

NOTE:
 1. CAST IRON FOR GRATINGS IS TO CONFORM WITH GRADE 150 OF BS1452.

LEGEND:
 [Hatched Box] ZONE FOR JACKING POINT FOR BEARING REPLACEMENT. JACK SHALL BE PLACED EQUALLY DISTRIBUTED IN THE ZONE
 [Box with X] 200x200x150 BOX-OUT FOR EARTH / ELECTRICAL PIT

As-built Drawing
 Prepared by the Contractor "DCVJV"
 11/01/19 Date
 Mr. W.K. Poon (Project Director)
 Checked by the Designer "Mott MacDonald"
 11/01/19 Date
 Dr. H.T. Cheng (Designer)
 Endorsed by the Design Checker "AECOM"
 11/01/19 Date
 Mr. Charles Luk (Design Checker)

Logos: D, CHEC, VSL, Mott MacDonald, YWL Engineering, ARUP

Contract No. HY/2011/09
Hong Kong - Zhuhai - Macao Bridge
Hong Kong Link Road
Section Between HKSAR Boundary and Scenic Hill


Project Title:
TYPICAL DRAINAGE DETAILS
DRAINAGE HOPPER

Drawing No.:
 HKLR9/MMH/AB/PW/DN/00130


AS SHOWN (IN A1)
 HKLR9 1 OF 1

Copyright Reserved

Highways Department

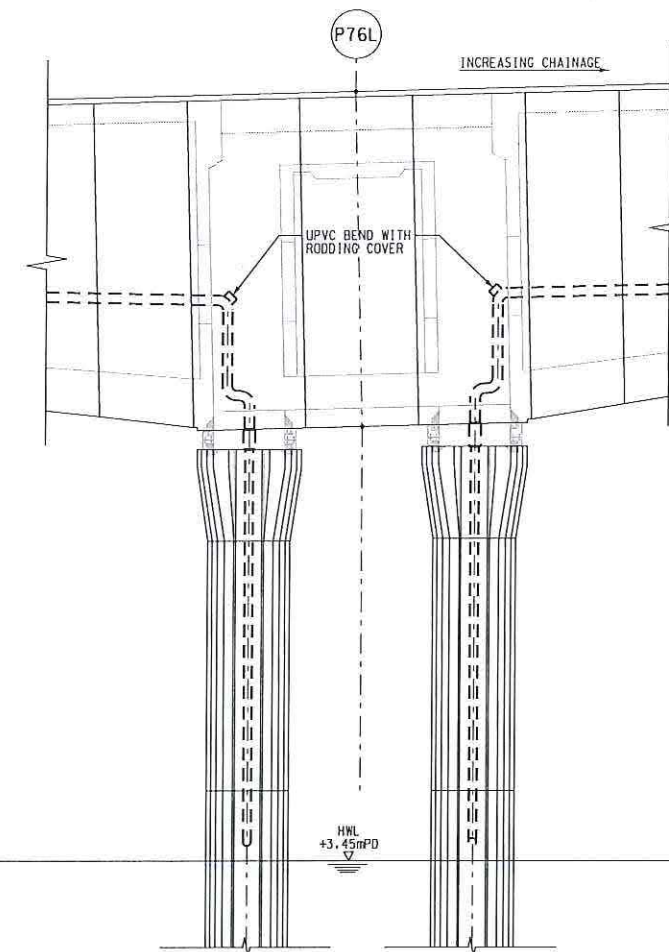


SECTION 1
SCALE 1:100

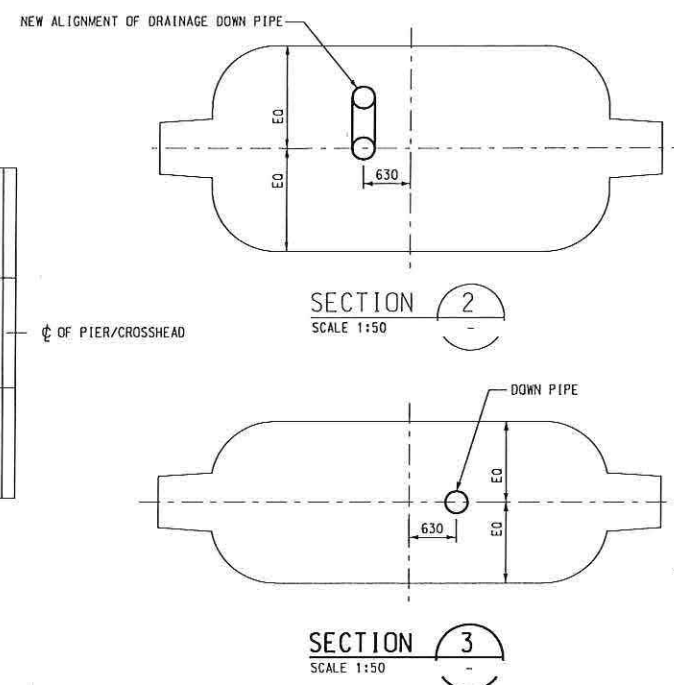


SECTION 3
SCALE 1:50




路政署
HIGHWAYS DEPARTMENT

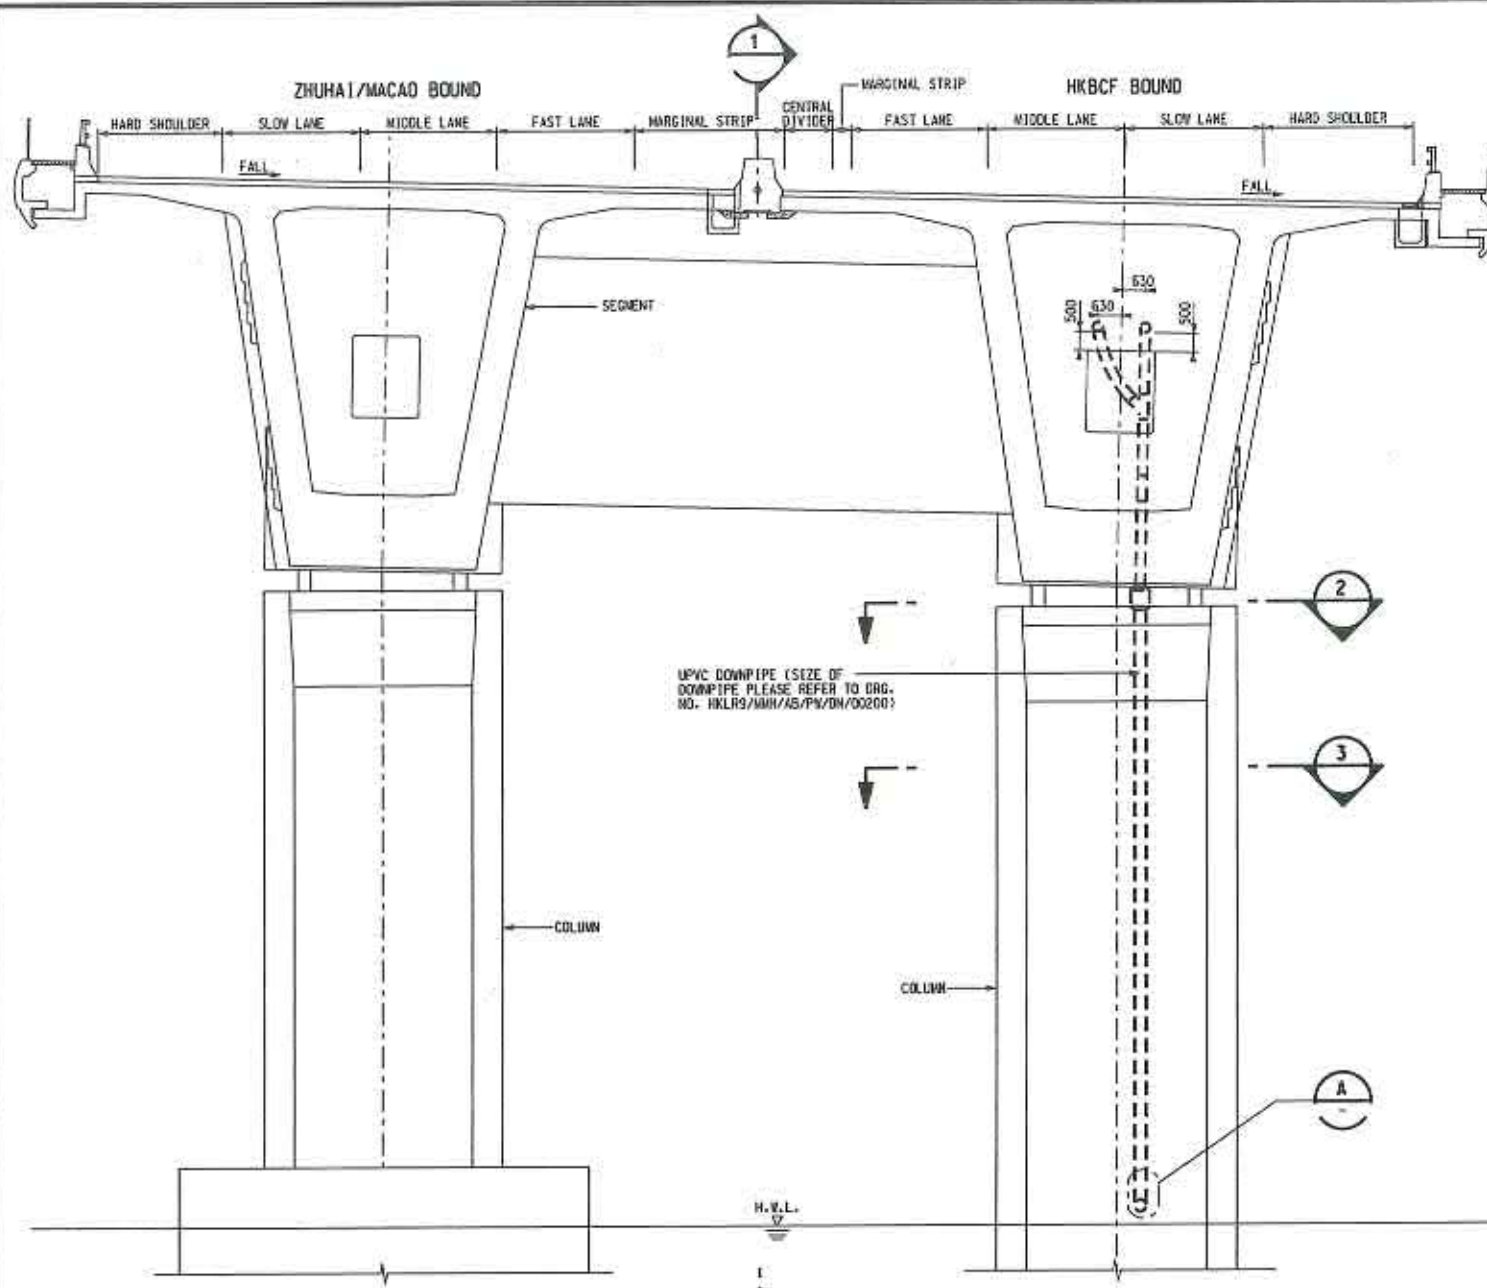


MONOLITHIC PIER AT NAVIGATION CHANNEL
 (APPLICABLE TO PIERS P82 AND P83)
 SCALE 1:100

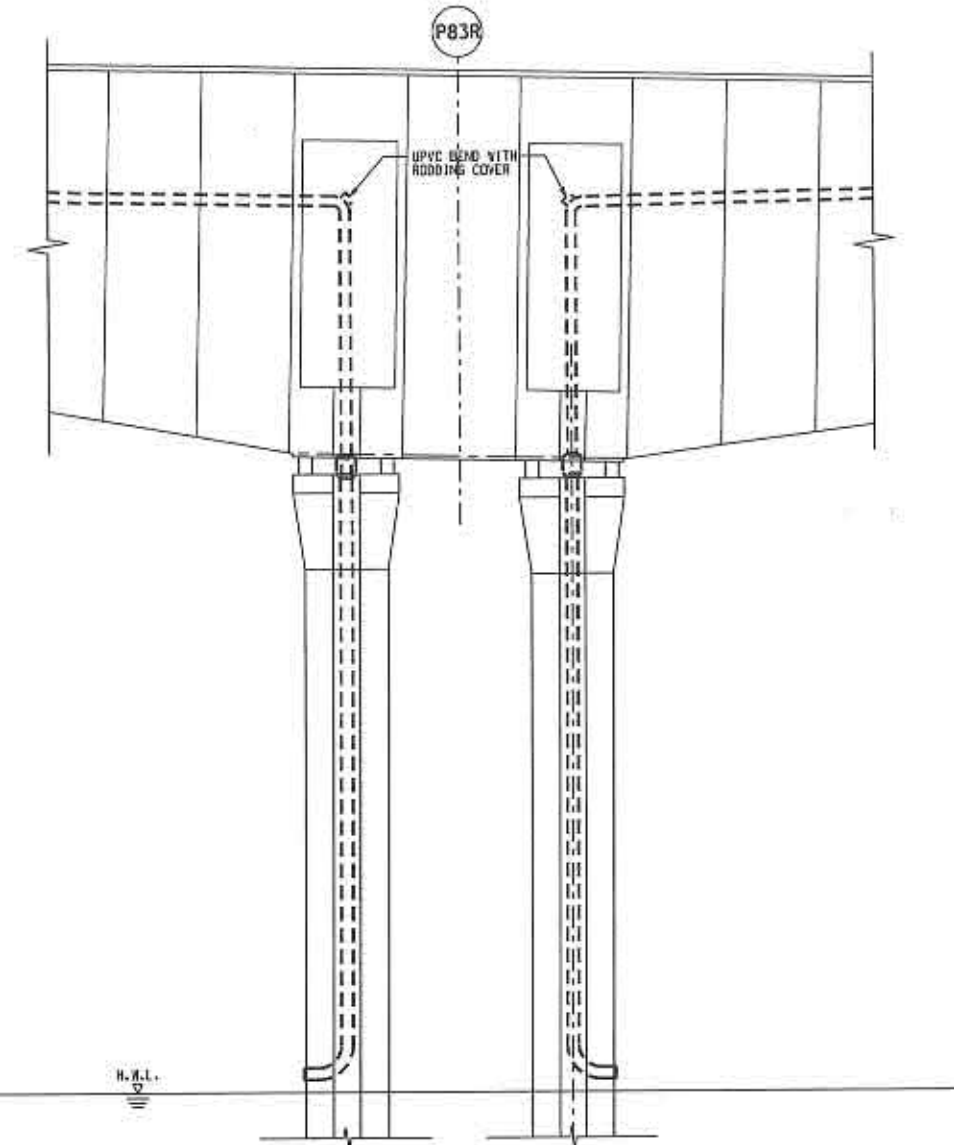


SECTION 1
 SCALE 1:100

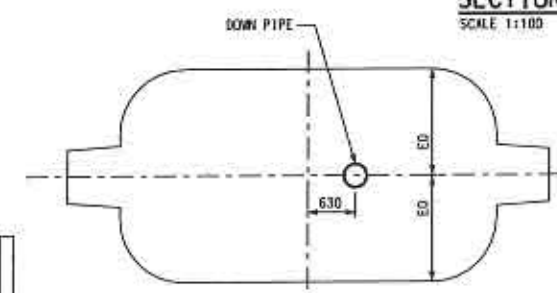

SECTION 2
 SCALE 1:50

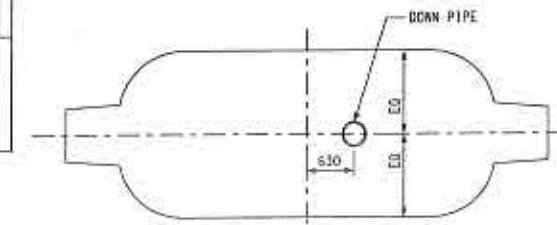


SECTION 3
 SCALE 1:50

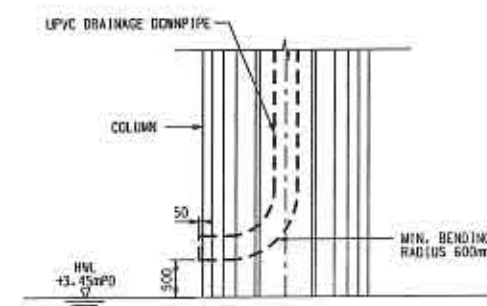


DETAIL A
 SCALE 1:50



PLAN
 SCALE 1:100

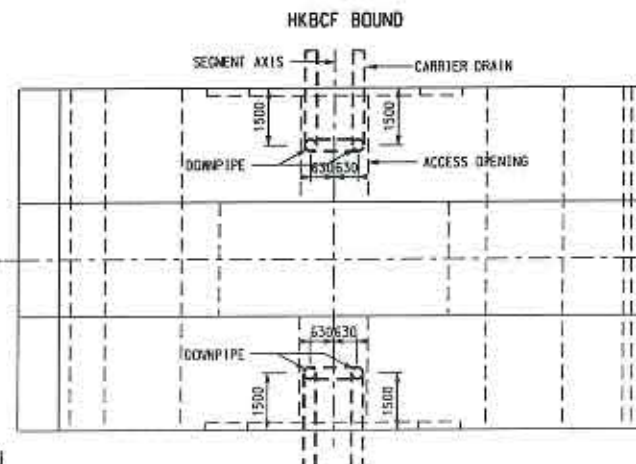

PLAN
 SCALE 1:100

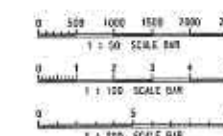

NOTES:

- FOR GENERAL NOTES REFER TO DRG. NO. HKLR9/MMH/AB/PW/DN/00000.
- THIS TYPE OF DRAINAGE ARRANGEMENT IS APPLICABLE TO PIERS P82 AND P83.
- PIER STARTERS AT CROSSHEAD SHALL BE CRAWLED TO ALLOW CARRIER DRAIN PASSING THROUGH TO THE PIER AREA IF NECESSARY.
- THIS SIZE OF CARRIER DRAIN REFER TO DRG. NO. HKLR9/MMH/AB/PW/DN/00001-00009.
- THE SIZE OF DOWNPIPE REFER TO DRG. NO. HKLR9/MMH/AB/PW/DN/00200.

As-built Drawing

Prepared by the Contractor "DCV/M"

Mr. W.K. Poon (Project Director)	11/01/19 Date
Checked by the Designer "Mott MacDonald"	
Dr. H.T. Cheng (Designer)	11/01/19 Date
Endorsed by the Design Checker "AECOM"	
Mr. Charles Luk (Design Checker)	11/01/19 Date



Contractor's Designer



ARUP 奧雅納工程顧問

Contract No. HY/2011/09
 Hong Kong - Zhuhai - Macao Bridge
 Hong Kong Link Road
 Section Between HKSAR Boundary and Scenic Hill

TYPICAL DRAINAGE DOWNPIPE ARRANGEMENT PIER P82 & P83

Contract No. HY/2011/09
 Hong Kong - Zhuhai - Macao Bridge
 Hong Kong Link Road
 Section Between HKSAR Boundary and Scenic Hill









Contract No. HKLR9/MMH/AB/PW/DN/00133

Design	PL	HTC	AS-BUILT
AS SHOWN (IN A1)			
HKLR9			1 OF 1

Copyright Reserved



Printed by : 6/4/2019
Filename : D:\HKL9\As-Built drawings\DDA 20\Final As-Built drawings\Part 1\HKL9_MMH_AB_PW_DN_00134.dgn

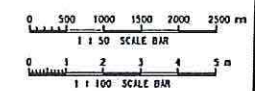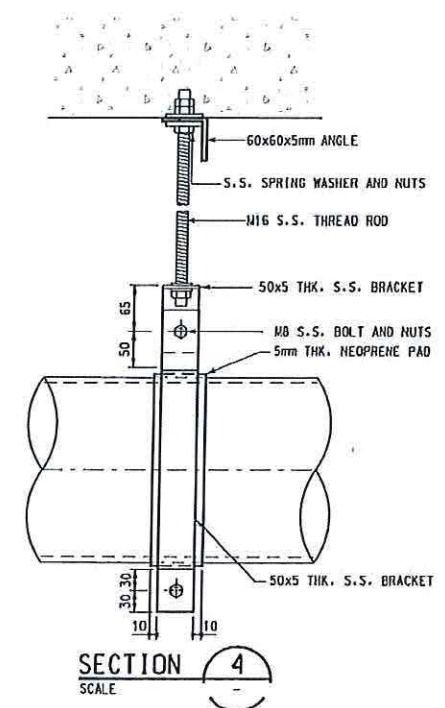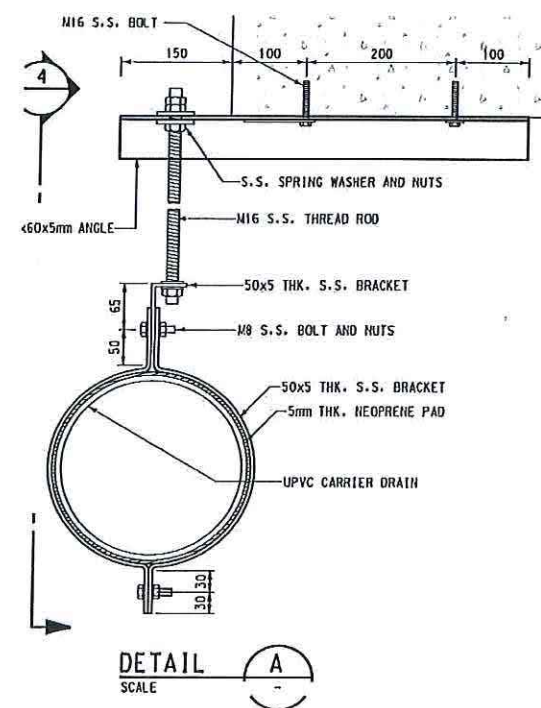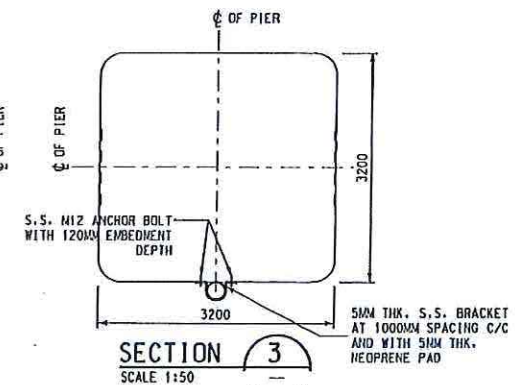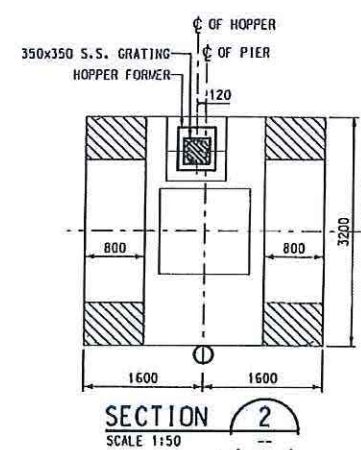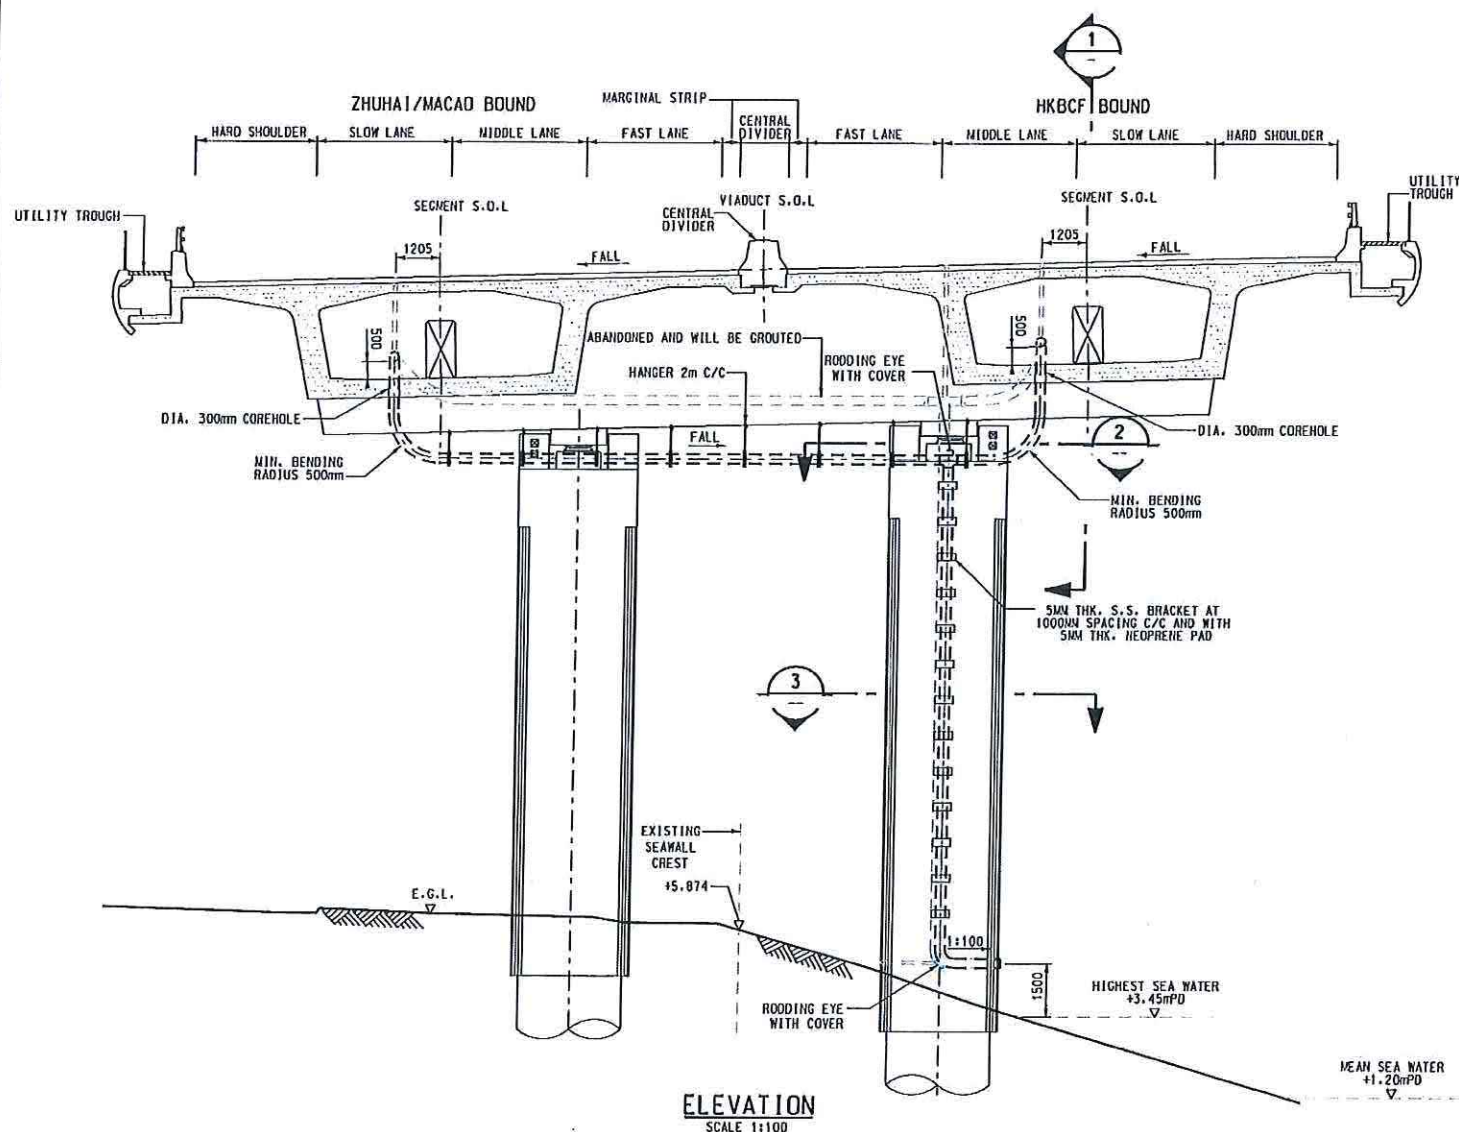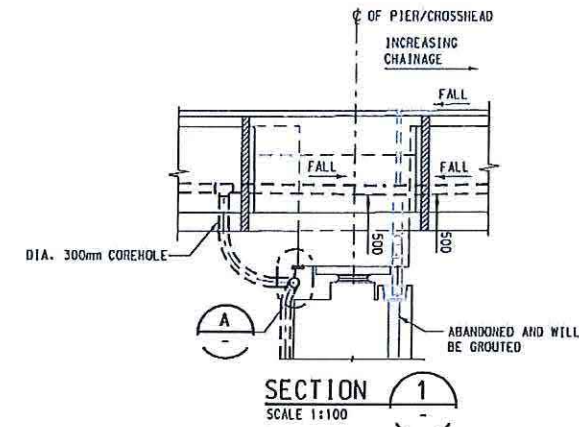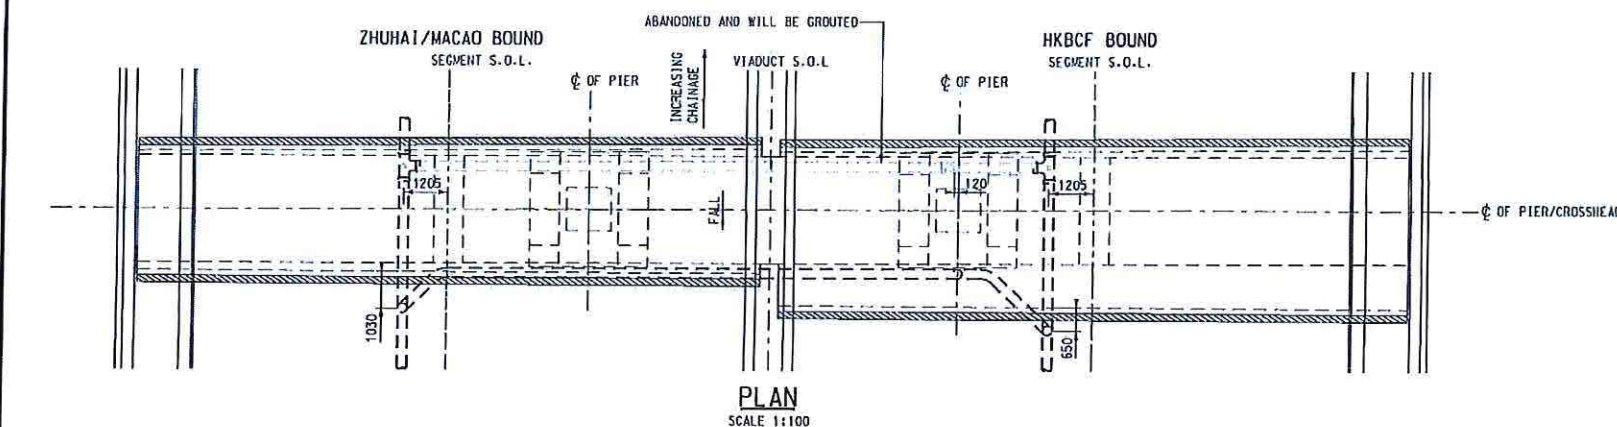

NOTES:

1. FOR GENERAL NOTES REFER TO DRG. NO. HKLR9/MMH/AB/PW/DN/00000.
2. THIS TYPE OF DRAINAGE ARRANGEMENT IS APPLICABLE TO PIER P105.
3. PIER STARTERS AT CROSSHEAD SHALL BE CRANKED TO ALLOW CARRIER DRAIN PASSING THROUGH TO THE PIER AREA IF NECESSARY.
4. THIS SIZE OF CARRIER DRAIN REFER TO DRG. NO. HKLR9/MMH/AB/PW/DN/00001-00009.
5. THE SIZE OF DOWNPIPE REFER TO DRG. NO. HKLR9/MMH/AB/PW/DN/00200.
6. DETAILS OF DRAINAGE HOPPER REFERS TO DRG. NO. HKLR9/MMH/AB/PW/DN/00130.

As-built Drawing

Prepared by the Contractor "DCVJV"

04JUN2019
Mr. W.K.Poon Date
(Project Director)

04JUN2019
Dr. H.T.Cheng Date
(Designer)

04JUN2019
Mr. Charles Luk Date
(Design Checker)

04JUN2019
Mr. Charles Luk Date
(Design Checker)



Mott MacDonald
YWL Engineering


ARUP 奧雅納工程顧問
Ovo Arup & Partners Hong Kong Limited

Contract No. HY/2011/09
Hong Kong - Zhuhai - Macao Bridge
Hong Kong Link Road
Section Between HK SAR Boundary and Scenic Hill

TYPICAL DRAINAGE DETAILS
DOWNPIPE ARRANGEMENT - PIER P105

Design No.	HKLR9/MMH/AB/PW/DN/00134	Rev.	AS SHOWN (IN A1)
Design	AL	PL	HTC
Check	AL	PL	HTC
Drawn	AL	PL	HTC
Sheet No.	1 OF 1		
File Name	HKLR9_MMH_AB_PW_DN_00134.dgn		
Copyright	RESERVED		

路政署
HIGHWAYS DEPARTMENT

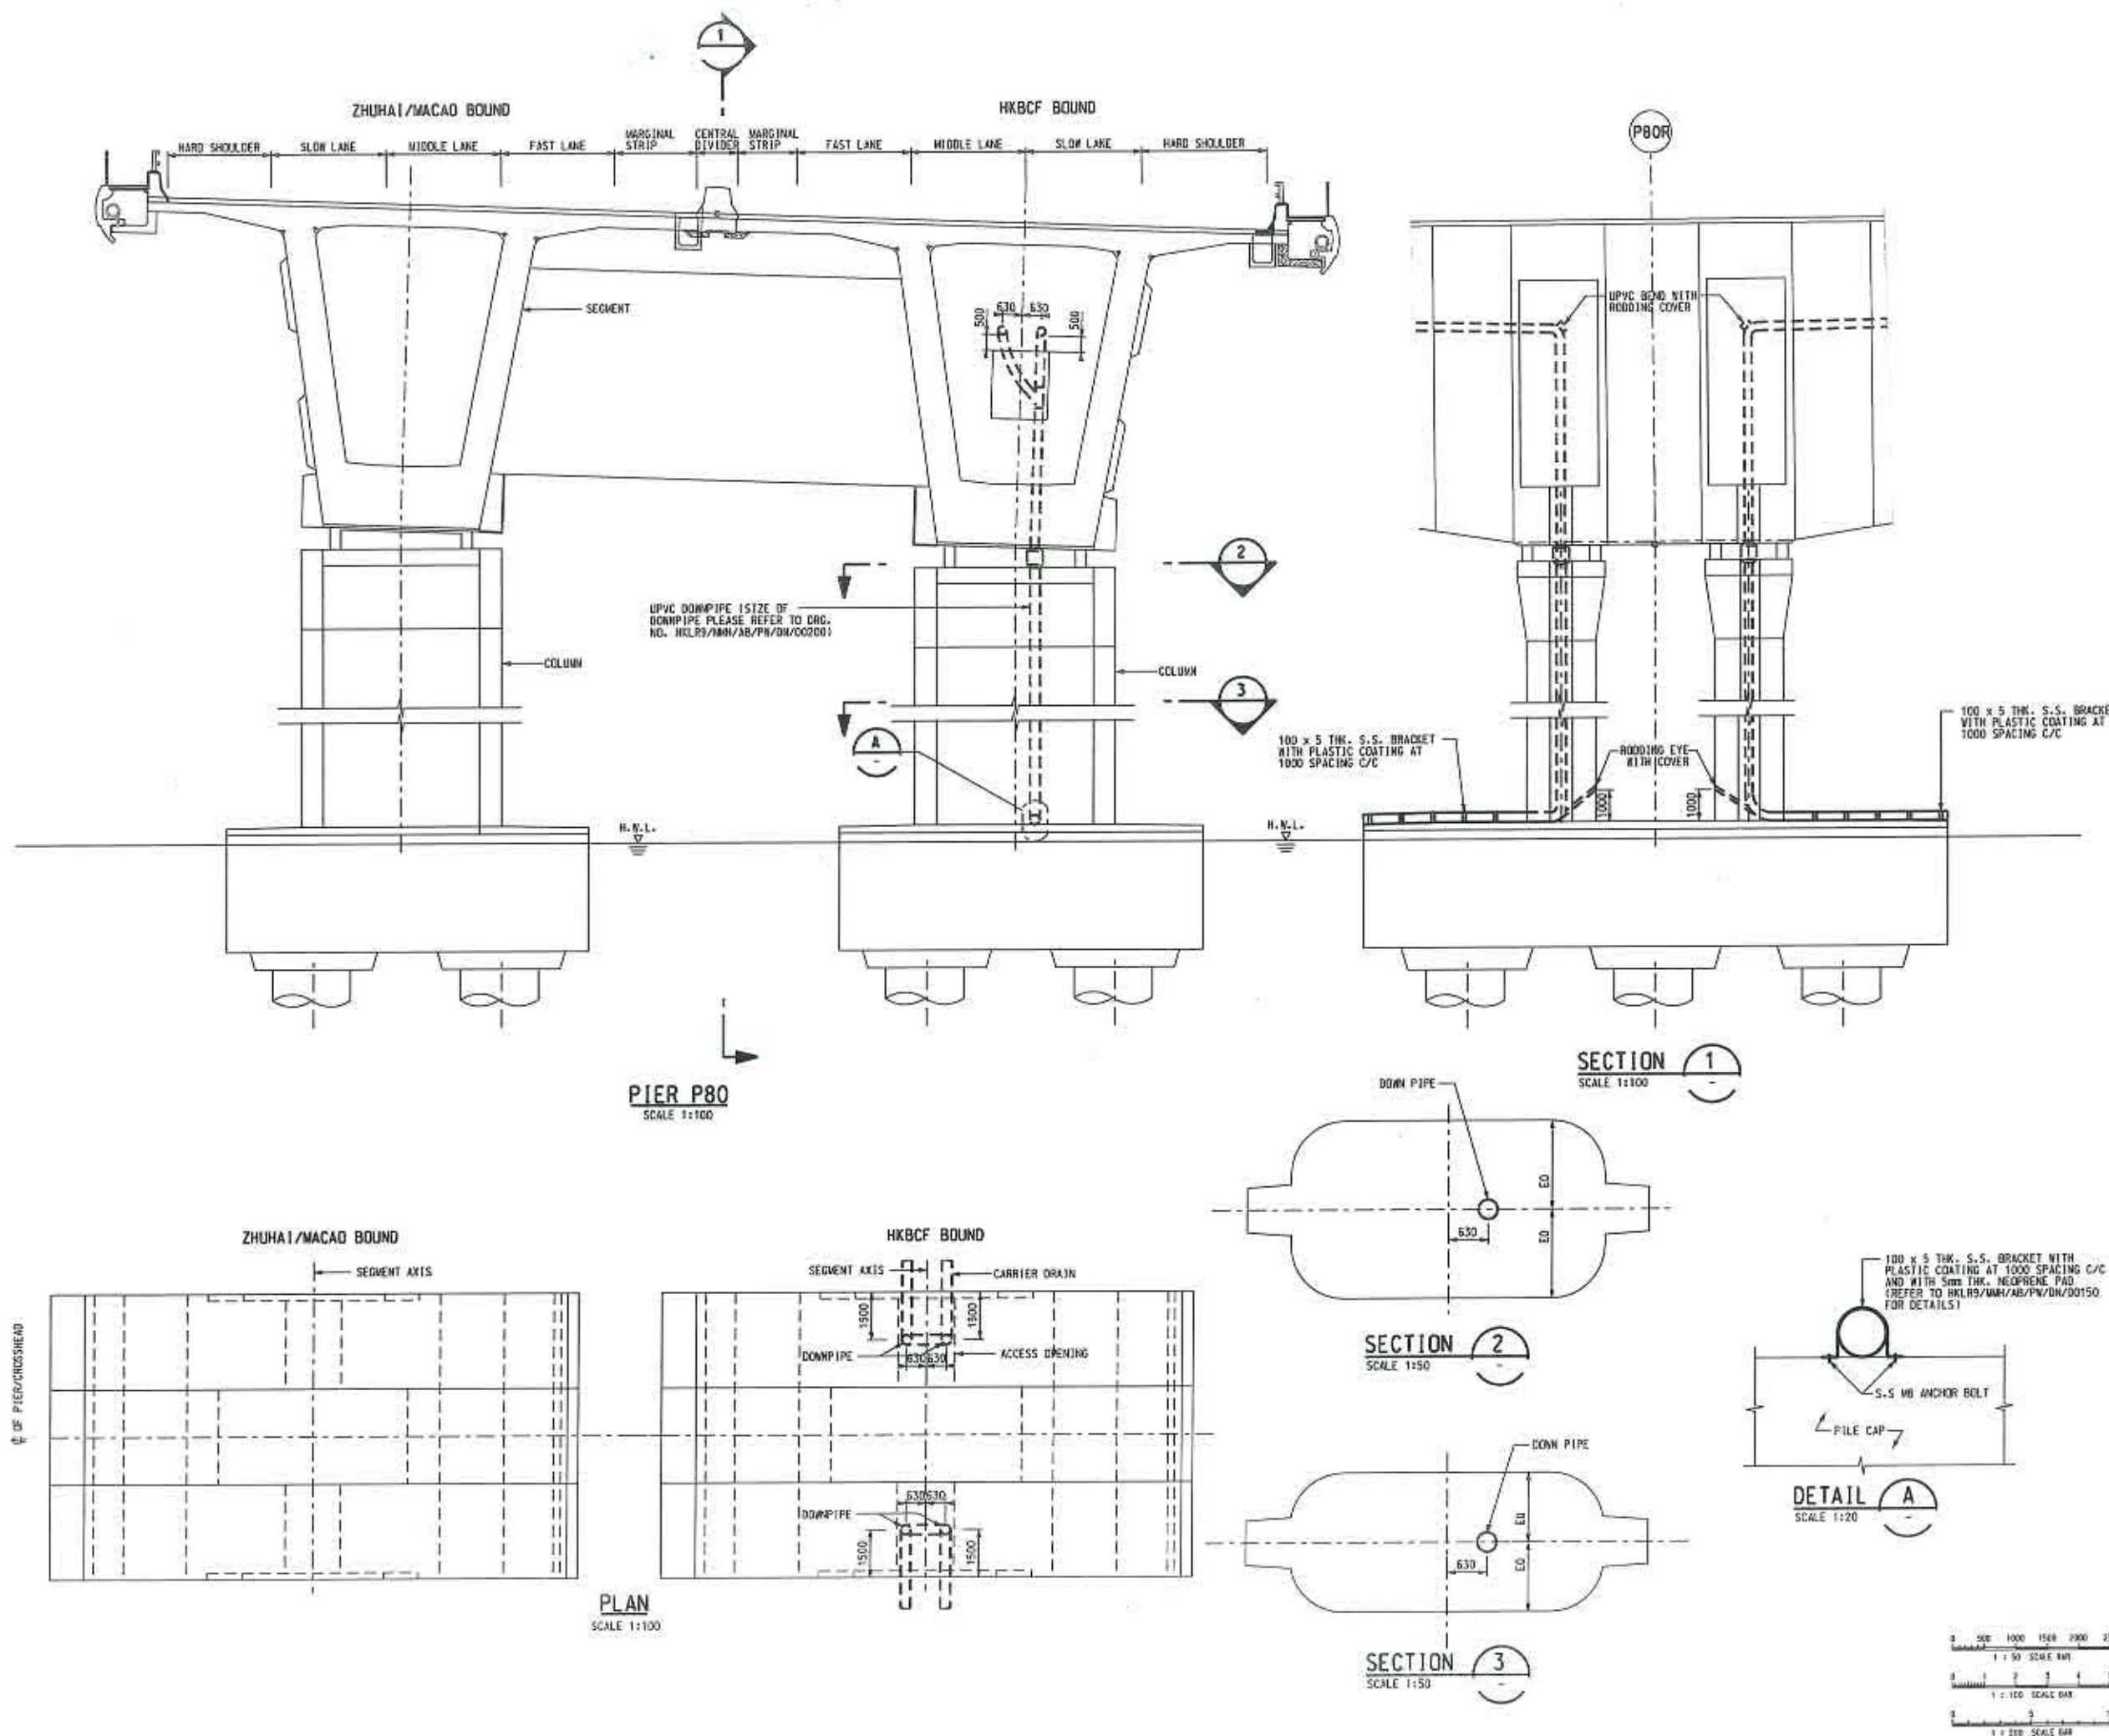

NOTES:

- FOR GENERAL NOTES REFER TO DRG. NO. HKLR9/MMH/AB/PW/DN/00000.
- THIS TYPE OF DRAINAGE ARRANGEMENT IS APPLICABLE TO PIERS P80.
- PIER STARTERS AT CROSSHEAD SHALL BE CRANED TO ALLOW CARRIER DRAIN PASSING THROUGH TO THE PIER AREA IF NECESSARY.
- THIS SIZE OF CARRIER DRAIN REFER TO DRG. NO. HKLR9/MMH/AB/PW/DN/00001-00003.
- THE SIZE OF DOWNPIPE REFER TO DRG. NO. HKLR9/MMH/AB/PW/DN/00200.

As-built Drawing

Prepared by the Contractor "DCV,IV"

Mr. W.K. Poon
(Project Director)
Date 11/01/19

Dr. H.T. Cheng
(Designer)
Date 11/01/19

Mr. Charles Luk
(Design Checker)
Date 11/01/19

Checked by the Designer "Mott MacDonald"

Endorsed by the Design Checker "AECOM"



Mott MacDonald
YWL Engineering









ARUP
Ove Arup & Partners Hong Kong Limited

Contract No. HY/2011/09
 Hong Kong - Zhuhai - Macao Bridge
 Hong Kong Link Road
 Section Between HKSAR Boundary and Scenic Hill

**TYPICAL DRAINAGE
 DOWNPIPE ARRANGEMENT
 PIER P80**

DRG. NO.	HKLR9/MMH/AB/PW/DN/00137	REV.	-
DESIGN	RL	PROJ	JL
AS SHOWN (IN A1)	HTC	REVIEW	AS-BUILT
DO. NO.	HKLR9	DO. NO.	1 OF 1
File name	HKLR9_MMFL_AB_PW_DN_00137.dgn		
	COPYRIGHT RESERVED		

**路政署
 HIGHWAYS DEPARTMENT**

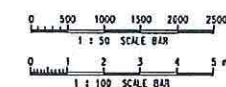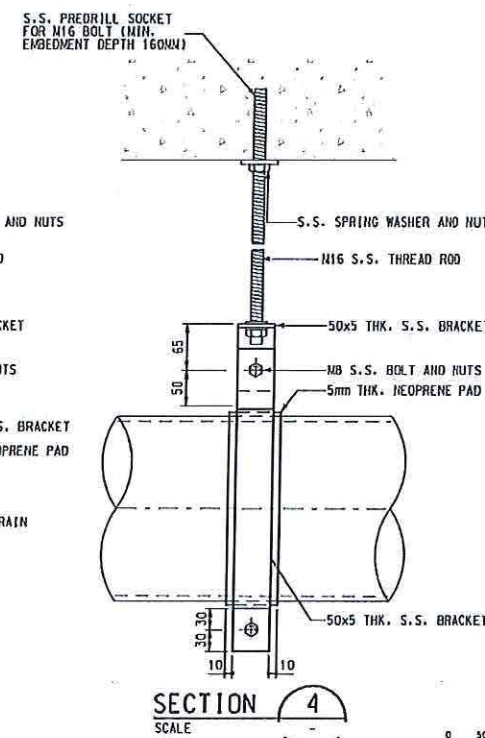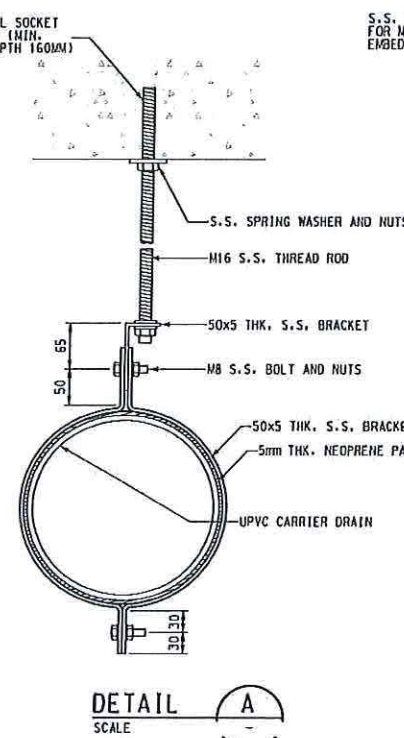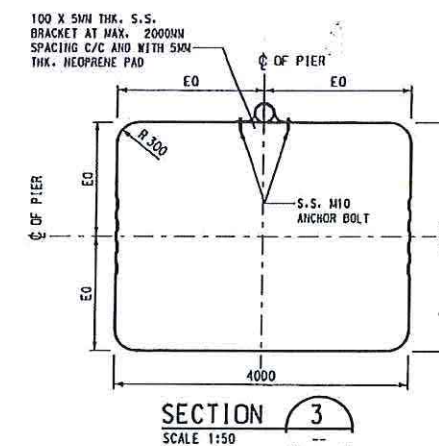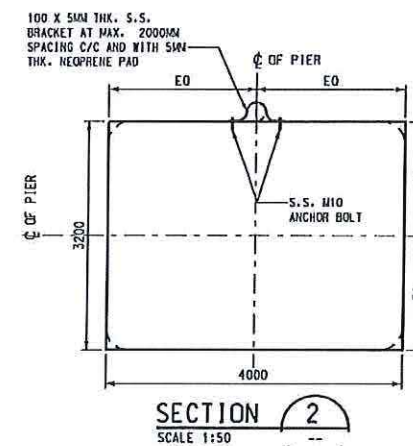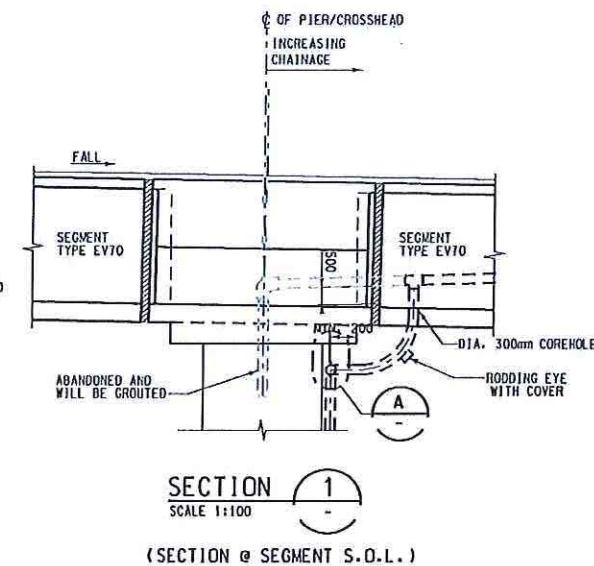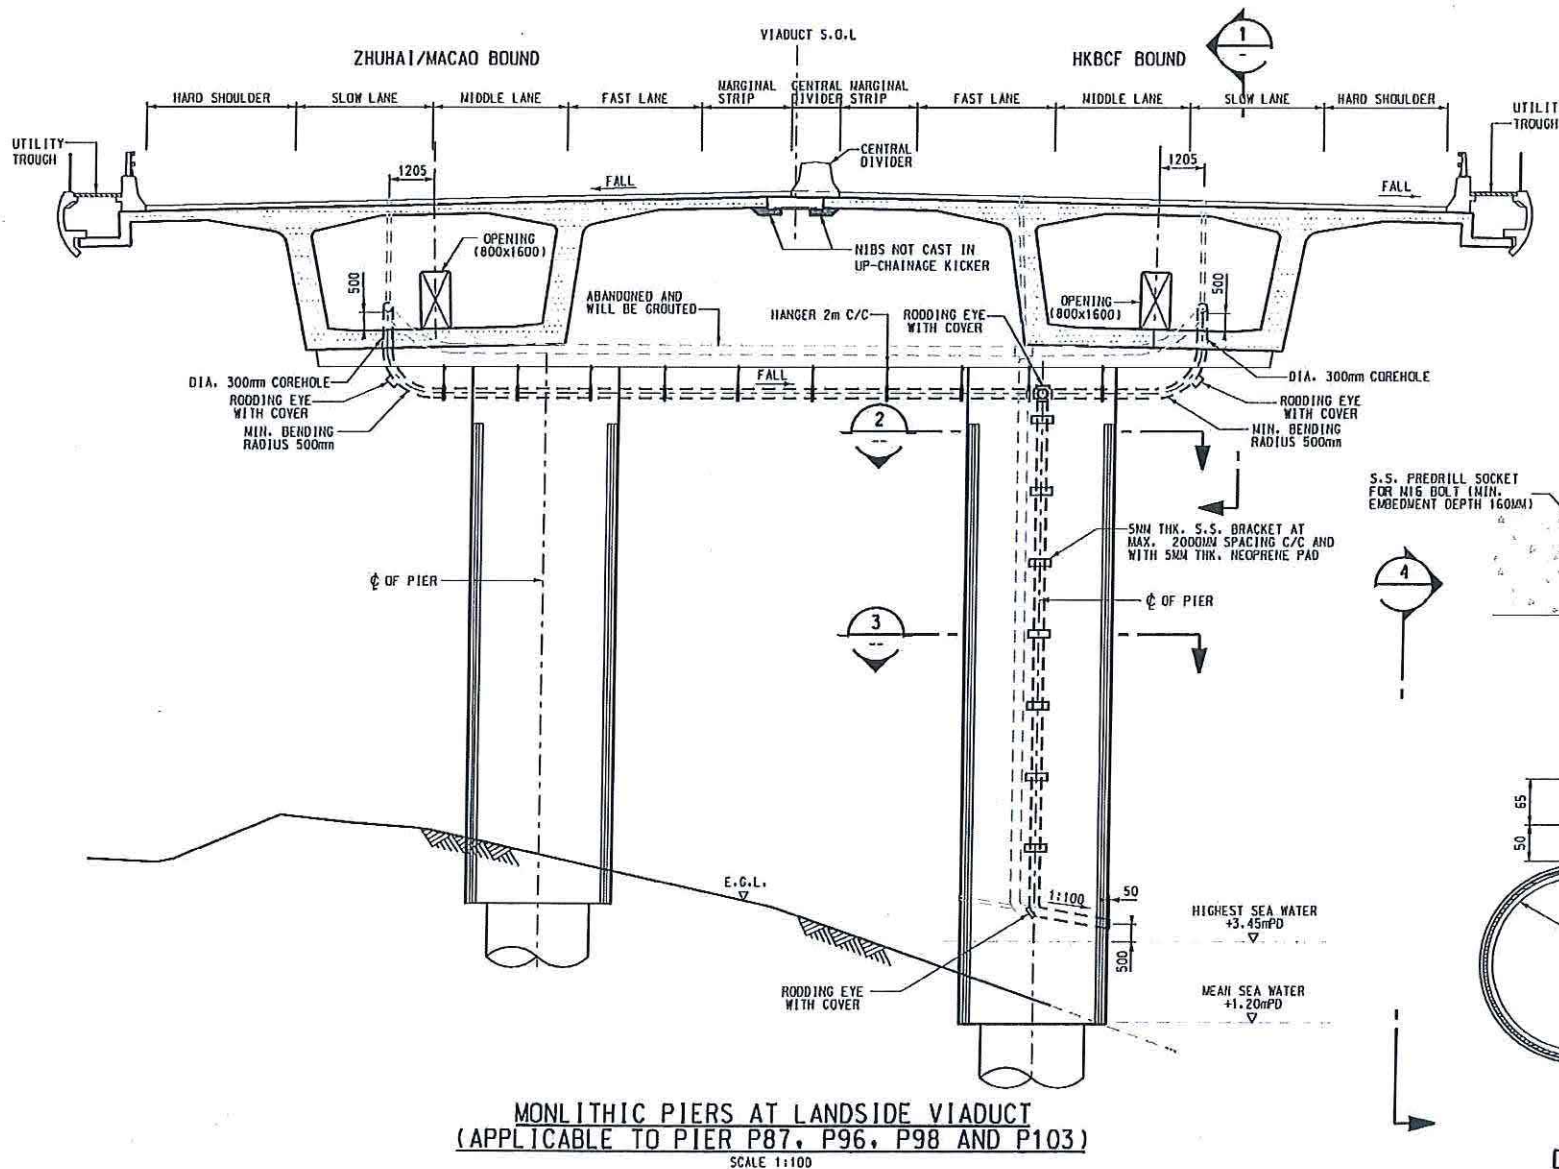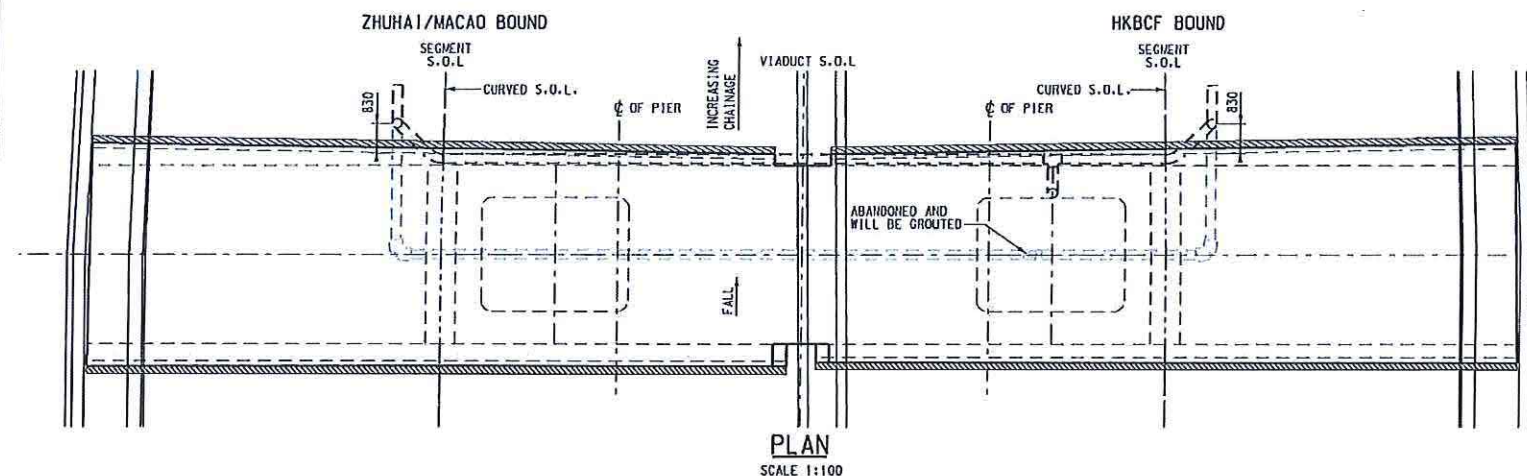


- NOTES:
1. FOR GENERAL NOTES REFER TO DRG. NO. HKLR9/MKH/AB/PW/DN/00000.
 2. THIS TYPE OF DRAINAGE ARRANGEMENT IS APPLICABLE TO PIERS P87, P88, P89, P90, P94, P95, P96, P97, P98, P101, P102 AND P103.
 3. DETAILS OF RODDING EYE RETERS TO DRG. NO. HKLR9/MKH/AB/PW/DN/00125.
 4. PIER STARTERS AT CROSSHEAD SHALL BE CRANKED TO ALLOW CARRIER DRAIN PASSING THROUGH TO THE PIER AREA IF NECESSARY.
 5. THIS SIZE OF CARRIER DRAIN REFER TO DRG. NO. HKLR9/MKH/AB/PW/DN/00001-00003.
 6. THE SIZE OF DOWNPIPE REFER TO DRG. NO. HKLR9/MKH/AB/PW/DN/00200.

As-built Drawing	
Prepared by the Contractor "DCVJV"	
Mr. W.K. Poon	04JUN2019
(Project Director)	Date
Checked by the Designer "Mott MacDonald"	
Dr. H.T. Cheng	04JUN2019
(Designer)	Date
Endorsed by the Design Checker "AECOM"	
Ir. Charles Luk	04JUN2019
(Design Checker)	Date



Dragages - China Harbour - VSL Joint Venture 廣東-中國港務-維多利亞

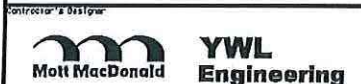

Contract No. HY/2011/09
Hong Kong - Zhuhai - Macao Bridge
Hong Kong Link Road
Section Between HK SAR Boundary
and Scenic Hill

TYPICAL DRAINAGE
DOWNPIPE ARRANGEMENT
PIER P87, P96, P98, P103

Project No.	HKLR9/MKH/AB/PW/DN/00150
Drawn by	AL
Checked by	MAR
Approved by	HTC
Scale	AS SHOWN (IN A1)
Job No.	HKLR9
Sheet No.	1 OF 1
File name	HKLR9_MKH_AB_PW_DN_00150.dgn



Appendix C – Implementation Schedule

Appendix C – Implementation Schedule of Emergency Response Plan for Chemical and Oil Spillage

Ref.	Recommended Mitigation Measures / Actions	Objectives of the Recommended Measures & Main Concerns to address	Implementation Agent	Location of the Measures	Implementation Stage
S5.4	In case of chemical spillage on the HKLR, HyD will follow the procedures specified in the Highways Department Emergency Handbook. In accordance with Clause 2.1 of the Handbook, HyD is responsible for informing the contractor to mobilize emergency plants/materials (e.g. sandbags) to confine chemical spills, upon identification of the incident by emergency parties i.e. HKPF and FSD.	Prevent the chemical spillage into the marine water.	HyD	On HKLR	During chemical spillage incident.
S5.5	Within the resources of the HyD or through the HyD's term maintenance contractors, HyD will be responsible for the duties as listed in S5.5(1) – (9).	Prevent the chemical spillage into the marine water and remove the chemical from the road as soon as possible.	HyD	On HKLR	During chemical spillage incident.
S5.6	In case of vehicle accident with, or with likelihood of, chemical spillage on HKLR, TD and HKPF's "Regional Command and Coordination Centre" will monitor the traffic conditions within Hong Kong portions of HKLR and in its vicinity through the 24-hour Traffic Control and Surveillance System (TCSS) operated by TD.	Implement temporary traffic arrangement and control in case of vehicle accident and chemical spillage.	TD	On HKLR	During chemical spillage incident.
S5.7	TD will assist HKPF to ascertain the necessity of traffic diversion and control, and whether partial or total road closure is required. TD will assist the temporary traffic management / arrangement including contra-flow traffic arrangement if necessary by controlling the TCSS. TD, in consultation with Police Public Relations Branch (PPRB), will be responsible for disseminating traffic diversion and lane/road closure as well as other related traffic and transportation information for motorists through the media and to other parties if necessary. Regarding cross-boundary coach services on HKLR, TIMS duty officers will	Implement temporary traffic arrangement and control in case of vehicle accident and chemical spillage.	TD	On HKLR	During chemical spillage incident.


Ref.	Recommended Mitigation Measures / Actions	Objectives of the Recommended Measures & Main Concerns to address	Implementation Agent	Location of the Measures	Implementation Stage
	arrange publicity on the closure of HKLR, inform THB duty officer, and inform the cross-boundary coach associations that the HKLR is to be closed. TIMS duty officer will request them to adjust service level / suspend service as appropriate.				
S5.8	RCCC NT of HKPF will immediately activate this ERP and inform the relevant government departments including but not limited to those departments identified under this ERP to take immediate actions to deal with the (potential) chemical spillage.	Activate the ERP and deal with chemical spillage situation.	HKPF	On HKLR	During chemical spillage incident.
S5.9	HKPF and FSD will carry out a preliminary assessment as to the likelihood of chemical spillage from vehicle, and if spillage has occurred, the likelihood of the spill entering into the drainage system of HKLR. HKPF should keep RCCC NT informed of the seriousness of the incident and provide RCCC NT with regular updated situation reports.	Activate the ERP and deal with chemical spillage situation.	HKPF	On HKLR	During chemical spillage incident.
S5.10	In the event of traffic congestion brought about by a chemical spillage incident, HKPF will inform the Mainland/Macao Authorities through the established border liaison channel for any incidents which may cause serious disruption to the operation of the HZMB and HKLR. They may request the Mainland/Macao Authorities for assistance from Mainland/Macao as and where necessary.	Activate the ERP and deal with chemical spillage situation.	HKPF	On HKLR	During chemical spillage incident.
S5.11 - 5.12	HKPF will be a key member of the ad hoc chemical spillage response team comprising representatives of all relevant departments to deal with (potential) chemical spillage from vehicle with the duties listed S5.11 and S5.12.	Activate the ERP and deal with chemical spillage situation.	HKPF	On HKLR	During chemical spillage incident.
S5.13 – 5.14	FSD is mainly responsible for fire-fighting and rescue. FSD will be responsible to take the actions listed in S5.14.	Fire-fighting and rescue.	FSD	On HKLR	During chemical spillage incident.
S5.15 – 5.18	MD is the designated authority for the clean up of oil spillage at sea.	Clean-up of chemical / oil spillage at sea.	MD	Marine water	During chemical spillage incident.
S5.19	EPD will follow the plans responding to marine based and land	Respond to	EPD	On HKLR /	During chemical

Ref.	Recommended Mitigation Measures / Actions	Objectives of the Recommended Measures & Main Concerns to address	Implementation Agent	Location of the Measures	Implementation Stage
	based pollution incidents in the territory.	marine / land based pollution incidents.		Marine water	spillage incident.
S5.20	GL will provide assistance in chemical identification in a chemical spillage incident and advise the characteristics of the chemical so as to help FSD and HKPF to plan the operational strategy. If necessary, GL will send an officer to the scene to assist in locating/identifying the chemical, analyse the levels of toxic substances at scene and/or provide advice to stabilise/handle/dispose the chemical.	Assist FSD and HKPF to plan the operational strategy to deal with chemical spillage.	GL	On HKLR / Marine water	During chemical spillage incident.
S5.21	AFCD will advise on the protection of ecologically sensitive areas in the waters; provide assistance and comments on the methods for cleaning up the substances/wastes/chemicals washed ashore in the nearby marine parks, especially their ecological impacts as recommended by relevant authorities; and monitor the ecological conditions and assess the potential ecological/fisheries impacts at the likely affected ecologically sensitive areas.	Protection of ecologically sensitive areas in the waters.	AFCD	Marine water	During chemical spillage incident.
S5.22	HyD will provide back up equipment and personnel to assist LCSD in removal of landed oil from gazetted beaches according MOSRP.	Removal of landed oil from gazetted beaches.	LCSD and HyD	Gazetted beaches	During chemical spillage incident.
S5.23	FEHD will provide manpower to assist to manual removal of non-contaminated refuse not classified as chemical or hazardous waste on non-gazetted beaches and foreshores that are without land access if necessary. For non-gazetted beaches and foreshores where land access is available, HyD is responsible for providing equipment and personnel for the removal of landed oil.	Removal of non-contaminated refuse not classified as chemical or hazardous waste on non-gazetted beaches and foreshores.	FEHD	Non-gazetted beaches and foreshores	During chemical spillage incident.
S5.24	DO(Islands) and DO(Tuen Mun) will inform the relevant District Council member(s) and Village Representative(s) in case of	Inform District Council	DO	-	During chemical spillage incident.

Ref.	Recommended Mitigation Measures / Actions	Objectives of the Recommended Measures & Main Concerns to address	Implementation Agent	Location of the Measures	Implementation Stage
	chemical spillage incidents in the waters as necessary.	member(s) and Village Representative(s)			
S5.25	If coordination with the Zhuhai/Macao side is required in traffic control during the exercise/drills (if any), Security Bureau will help liaison work, particularly at the initial stage.	Coordination with the Zhuhai / Macao side	SB	On HKLR	During chemical spillage incident.
S5.26	The HZMB Authority is responsible for the operation, management and maintenance of the Main Bridge of HZMB. In principle, the HZMB Authority will be responsible for emergency response actions for chemical spillage on the Main Bridge of HZMB.	Emergency response actions for chemical spillage on the Main Bridge of HZMB.	HZMBA	On Main Bridge	During chemical spillage incident.
S7	HKPF will notify the Mainland Authority through the established border liaison channel for the accident and requesting for assistance from Mainland where necessary. TD/HKPF will also notify the Mainland Authority if any traffic diversion and lane/road closure are required to be implemented on the Main Bridge.	Notify the Mainland Authority	HKPF	-	During chemical spillage incident.
S8	Training and Drill	Provide a prompt response to an emergency event	Relevant government departments	-	Regular training.

Figures

DO NOT SCALE DRAWING. CHECK ALL DIMENSIONS ON SITE.
ALL RIGHTS RESERVED.
© OVE ARUP & PARTNERS HONG KONG LIMITED.

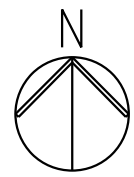

HKSAR BOUNDARY



LEGEND

- WATER SENSITIVE RECEIVERS
- A - TAI O
 - B - SHA LO WAN
 - C - SAN TAU SSSI
 - D - TAI HO WAN
 - E - ARTIFICIAL REEF IN NE AIRPORT
 - F - SHA CHAU AND LUNG KWU CHAU MARINE PARK
 - G - THE BROTHERS MARINE PARK
 - H - GAZETTED BEACHES IN TUEN MUN
 - I - BUTTERFLY BEACH
 - J - SHAM WAT
 - K - HAU HOK WAN
 - L - PROPOSED SOUTHWEST LANTAU MARINE PARK

PLEASE ALSO REFER TO FIGURE 9.5 OF EIA REPORT OF HONG KONG LINK ROAD FOR THE MARINE ECOLOGY SENSITIVE RECEIVERS.

Rev	Description	By	Date
Consultant			
ARUP 奧雅納工程顧問 Ove Arup & Partners Hong Kong Limited			
Contract No. and Title:			
Agreement No. CE36/2009 (HY) Tender and Construction of Hong Kong-Zhuhai-Macao Bridge Hong Kong Link Road - Design and Construction			
Drawing title			
WATER SENSITIVE RECEIVERS			
Drawing no. FIGURE 1			Rev. -
Drawn RI	Date 09/17	Checked	Approved
Scale 1:40000 @A1		Status	

COPYRIGHT RESERVED



DO NOT SCALE DRAWING. CHECK ALL DIMENSIONS ON SITE.
ALL RIGHTS RESERVED.
© OVE ARUP & PARTNERS HONG KONG LIMITED.



805000 E

810000 E

820000 N


820000 N

815000 N

815000 N

805000 E

810000 E

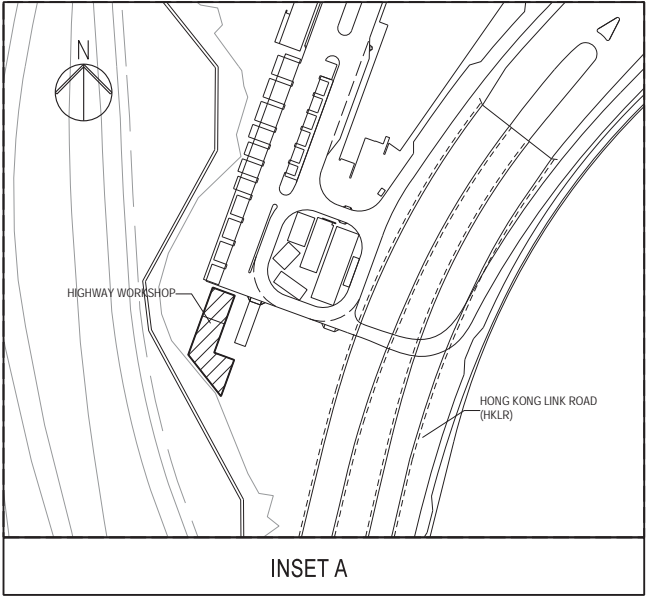

INSET A

HKSAR BOUNDARY

HONG KONG INTERNATIONAL AIRPORT

SEE INSET A

TUNG CHUNG

HONG KONG LINK ROAD (HKLR)

LEGEND

 HIGHWAY WORKSHOP

Rev	Description	By	Date
-----	-------------	----	------

Consultant		ARUP 奧雅納工程顧問 Ove Arup & Partners Hong Kong Limited	
------------	--	---	--

Contract No. and Title:
**Agreement No. CE36/2009 (HY)
Tender and Construction of
Hong Kong-Zhuhai-Macao Bridge
Hong Kong Link Road -
Design and Construction**

Drawing title
**LOCATION PLAN OF
MAINTENANCE WORKSHOP
FOR HONG KONG LINK ROAD**

Drawing no. FIGURE 2		Rev. —	
Drawn RI	Date 09/17	Checked	Approved
Scale 1:20000 @A1		Status	

COPYRIGHT RESERVED

 **路政署
HIGHWAYS DEPARTMENT**
港珠澳大橋香港工程管理處
Hong Kong - Zhuhai - Macao Bridge
Hong Kong Project Management Office

DO NOT SCALE DRAWING. CHECK ALL DIMENSIONS ON SITE.
ALL RIGHTS RESERVED.
© OVE ARUP & PARTNERS HONG KONG LIMITED.



820000 N

805000 E

810000 E

820000 N

815000 N

815000 N

HKSAR BOUNDARY

HONG KONG LINK ROAD
(HKLR)

HONG KONG INTERNATIONAL AIRPORT

HKBCF

HZMB Fire Station
cum Ambulance Depot

A
Chek Lap Kok
Fire Station

B
Tung Chung
Fire Station

TUNG CHUNG

LEGEND



FIRE STATION

Rev	Description	By	Date
-----	-------------	----	------

Consultant		ARUP 奧雅納工程顧問 Ove Arup & Partners Hong Kong Limited	
------------	--	---	--

Contract No. and Title:
Agreement No. CE36/2009 (HY)
Tender and Construction of
Hong Kong-Zhuhai-Macao Bridge
Hong Kong Link Road -
Design and Construction

Drawing title

LOCATION OF FIRE STATION

Drawing no.	FIGURE 3		Rev.	—
-------------	----------	--	------	---

Drawn RI	Date 09/17	Checked	Approved
Scale 1:20000 @A1	Status		

COPYRIGHT RESERVED



路政署
HIGHWAYS DEPARTMENT
港珠澳大橋香港工程管理處
Hong Kong - Zhuhai - Macao Bridge
Hong Kong Project Management Office